


Parcel	Kind of Instrument	Date of Instrument	Grantor	Grantee	Recorded	Remarks
A B C D	A.C.D.	9-23-35	Martha Baker	Clayton Field	16	10-3-35
A-B (C)	W.D.	9-23-35	Clayton Field	"	16	10-3-35

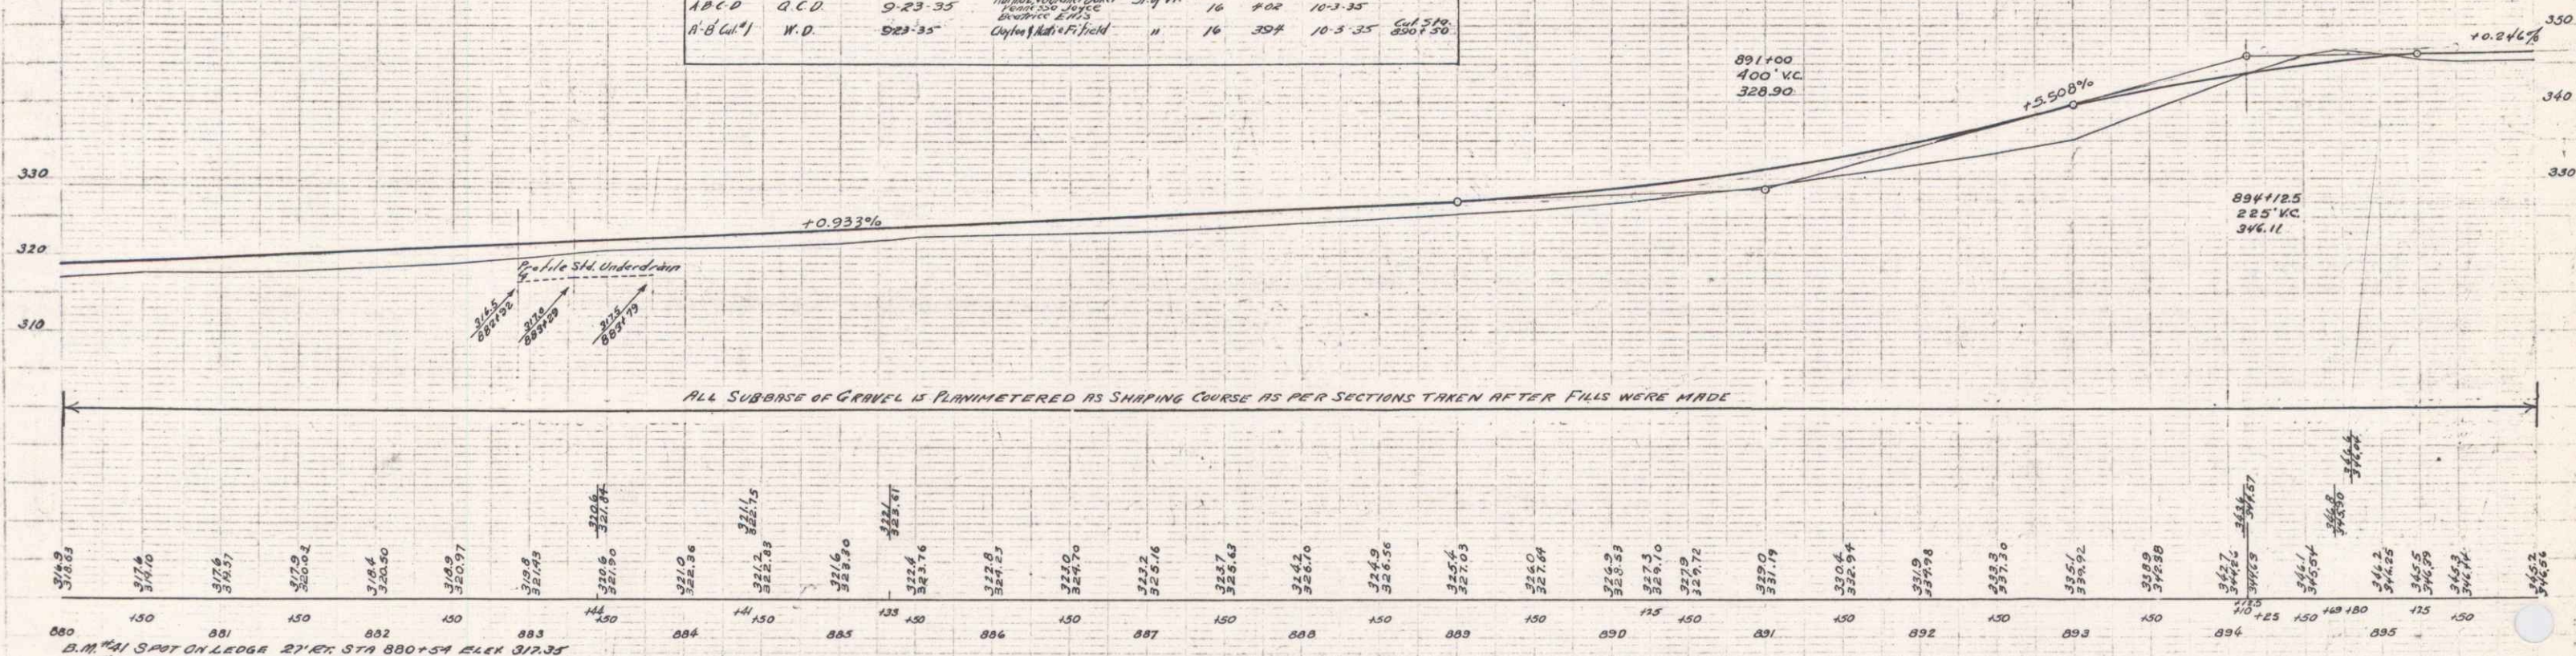

2. M. 41 SPOT ON LEDGE 27' E. STA 880+34 ELEV 317.35
 8. M. 40 SPOT ON BOULDER 20' E. STA 890+78 ELEV 333.22