


Curve
 Δ 23° 37' Left
 D 0'
 E 955.4
 T 199.7
 L 393.6
 E 20.7

River change to be paid for as Common Excavation Incl. Borrow (Item 10-11)
 CHITTENDEN LUMBER CO.

Parcel	Kind of Instrument	Date of Instrument	Grantor	Grantee	Recorded Book Page	Recorded Date	Remarks
A-B	O.C.D.	10-22-35	Chittenden Lumber Co	SI, V.I.	16 496	10-31-35	

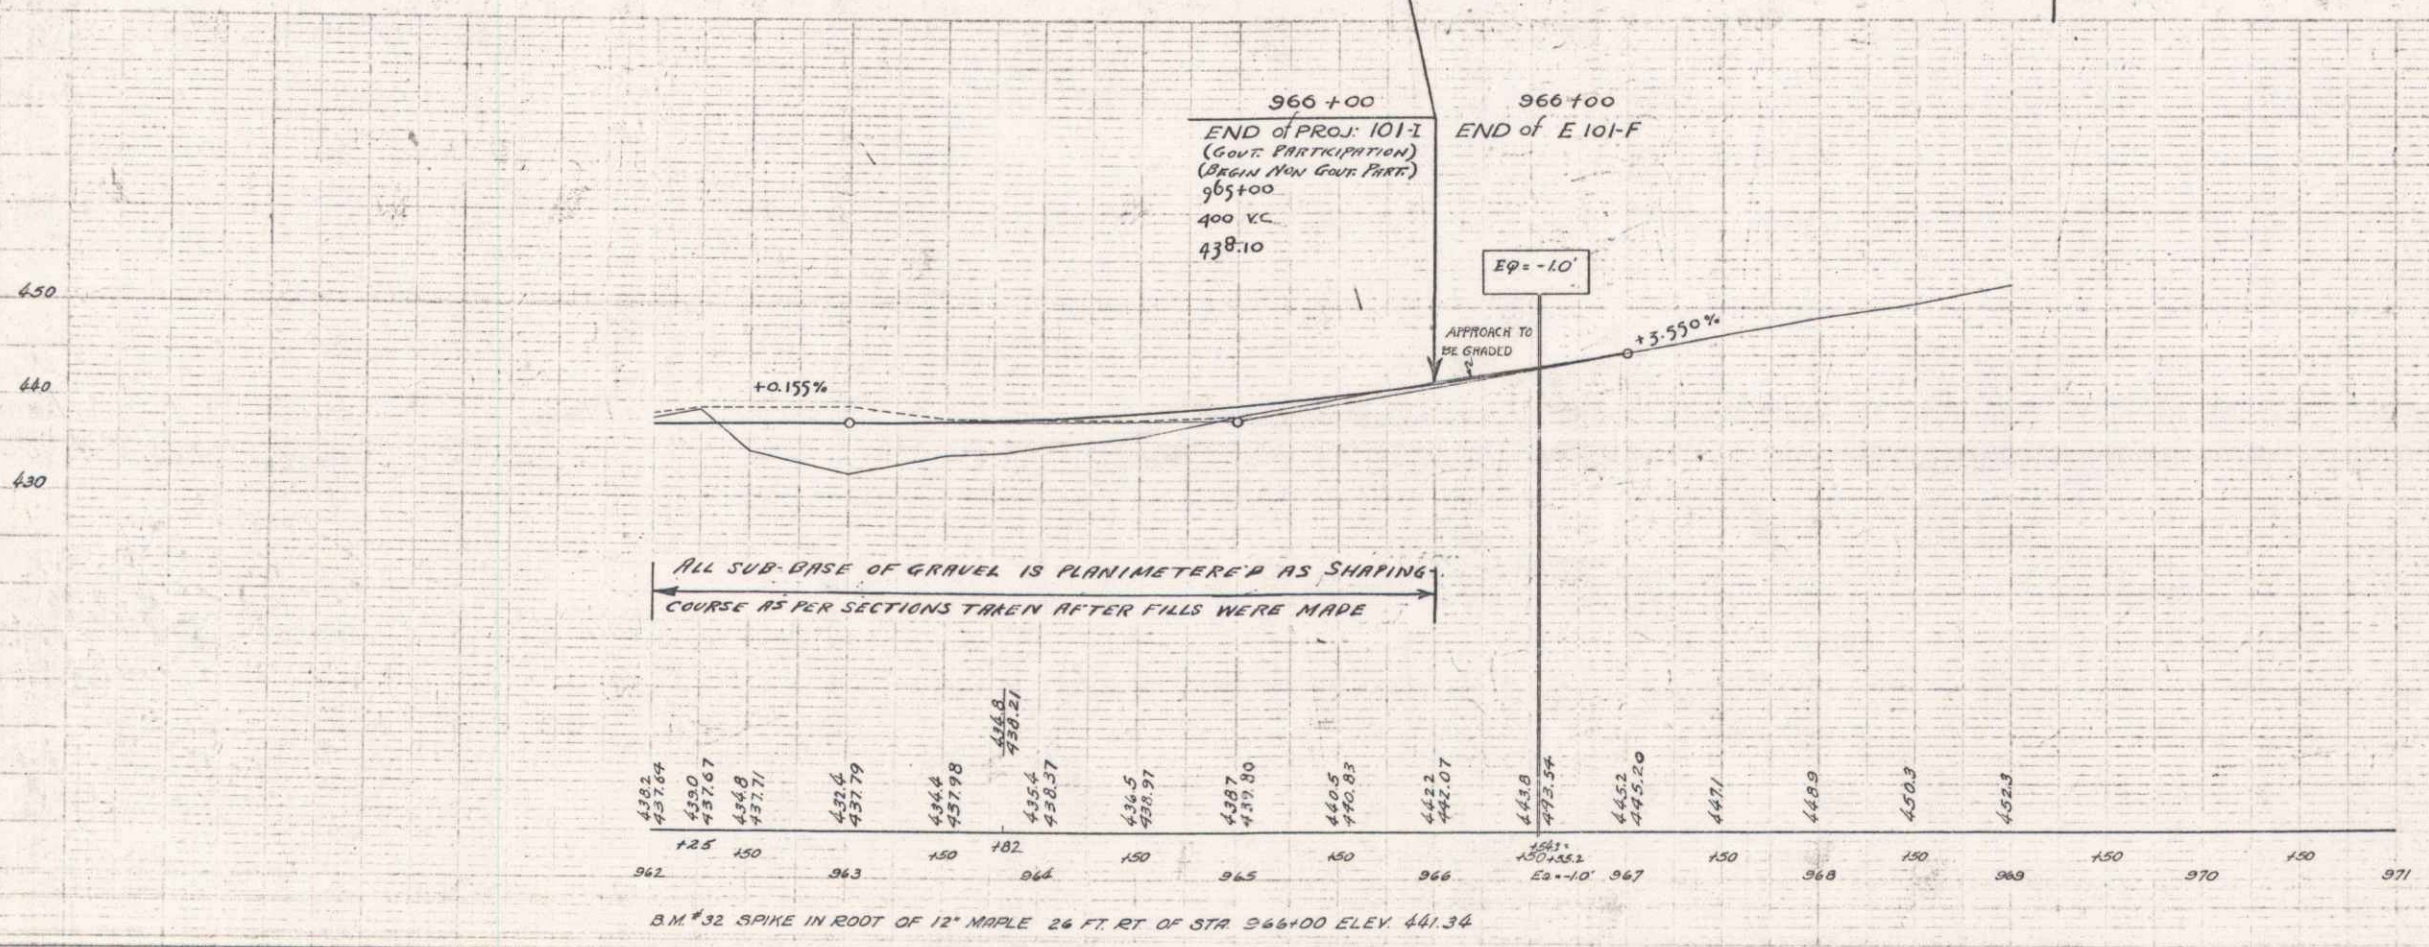

Series MAP M.E.I.
 Sheet 16 of 20