

INDEX OF SHEETS

SHEET NO.	TITLE PAGE
2	TYPICAL CROSS-SECTION OF IMPROVEMENT
3	BANKING AND WIDENING TABLES
4-7	PLAN AND PROFILE SHEETS
10	DETAIL OF SPECIAL CURV. INLET
19	CONCRETE CRIB AROUND D&P INLET
20	6" x 6" R.C. BOX STA 446 + 25
21	5" x 5" R.C. BOX STA 490 + 31
22	STRUCTURE - 51024 - 45° SKEW (USE 3-04 SPRING)
23	ABUTMENT DETAILS
24	PIER DETAILS
25	CABLE GUARD RAIL - SB NO. 50
26	SB NO. 20, DETAILS 503, 507, 509, 512 & GENERAL NOTES
27	STANDARD STRUCTURE SHEET 520, PIPE CULVERTS
28	" " " " 529, BOX "
29	" " " " 530, GUARD RAIL "
30	" " " " 531, BOUNDARY MARKERS "
31	" " " " 535, CONCRETE CRIBBING "
32	" " " " 540, BARRICADES, SIGNS & LIGHTS "
33-130	CROSS-SECTION SHEETS

Standard Structure Sheets approved by the Chief Engineer


520	July 11, 1933
529	July 11, 1933
530	Aug 15, 1934
531	July 25, 1934

STATE OF VERMONT  
STATE HIGHWAY DEPARTMENT  
FEDERAL AID PROJECT

PLAN AND PROFILE OF PROPOSED  
STATE HIGHWAY  
TOWN OF STOCKBRIDGE  
BETHEL - RUTLAND ROAD


BEGINNING AT A POINT 0.523 MILES FROM THE WEST END OF STONEY BROOK BRIDGE AND EXTENDING WESTERLY 3.316 MILES TO A POINT 1.277 MILES EAST OF THE STOCKBRIDGE - PITTSFIELD TOWN LINE.

LENGTH OF ROADWAY 17,257.9 FT. = 3.268 MILES  
LENGTH OF BRIDGE 252.0 FT. = 0.048 MILES  
TOTAL LENGTH OF PROJECT 17,509.9 FT. = 3.316 MILES

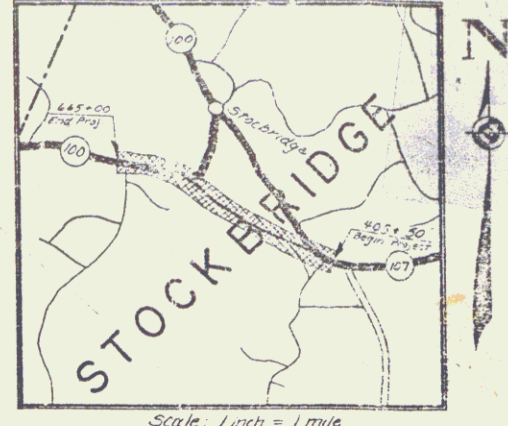

(To Be Returned to E.O.W. Division)  
Form of **VT 107**  
RECEIVED  
TOWN OF  
HIGHWAY DIVISION

Pin # 00R660  
Project FAP 223  
Route VT 100  
Date 6/7/1937

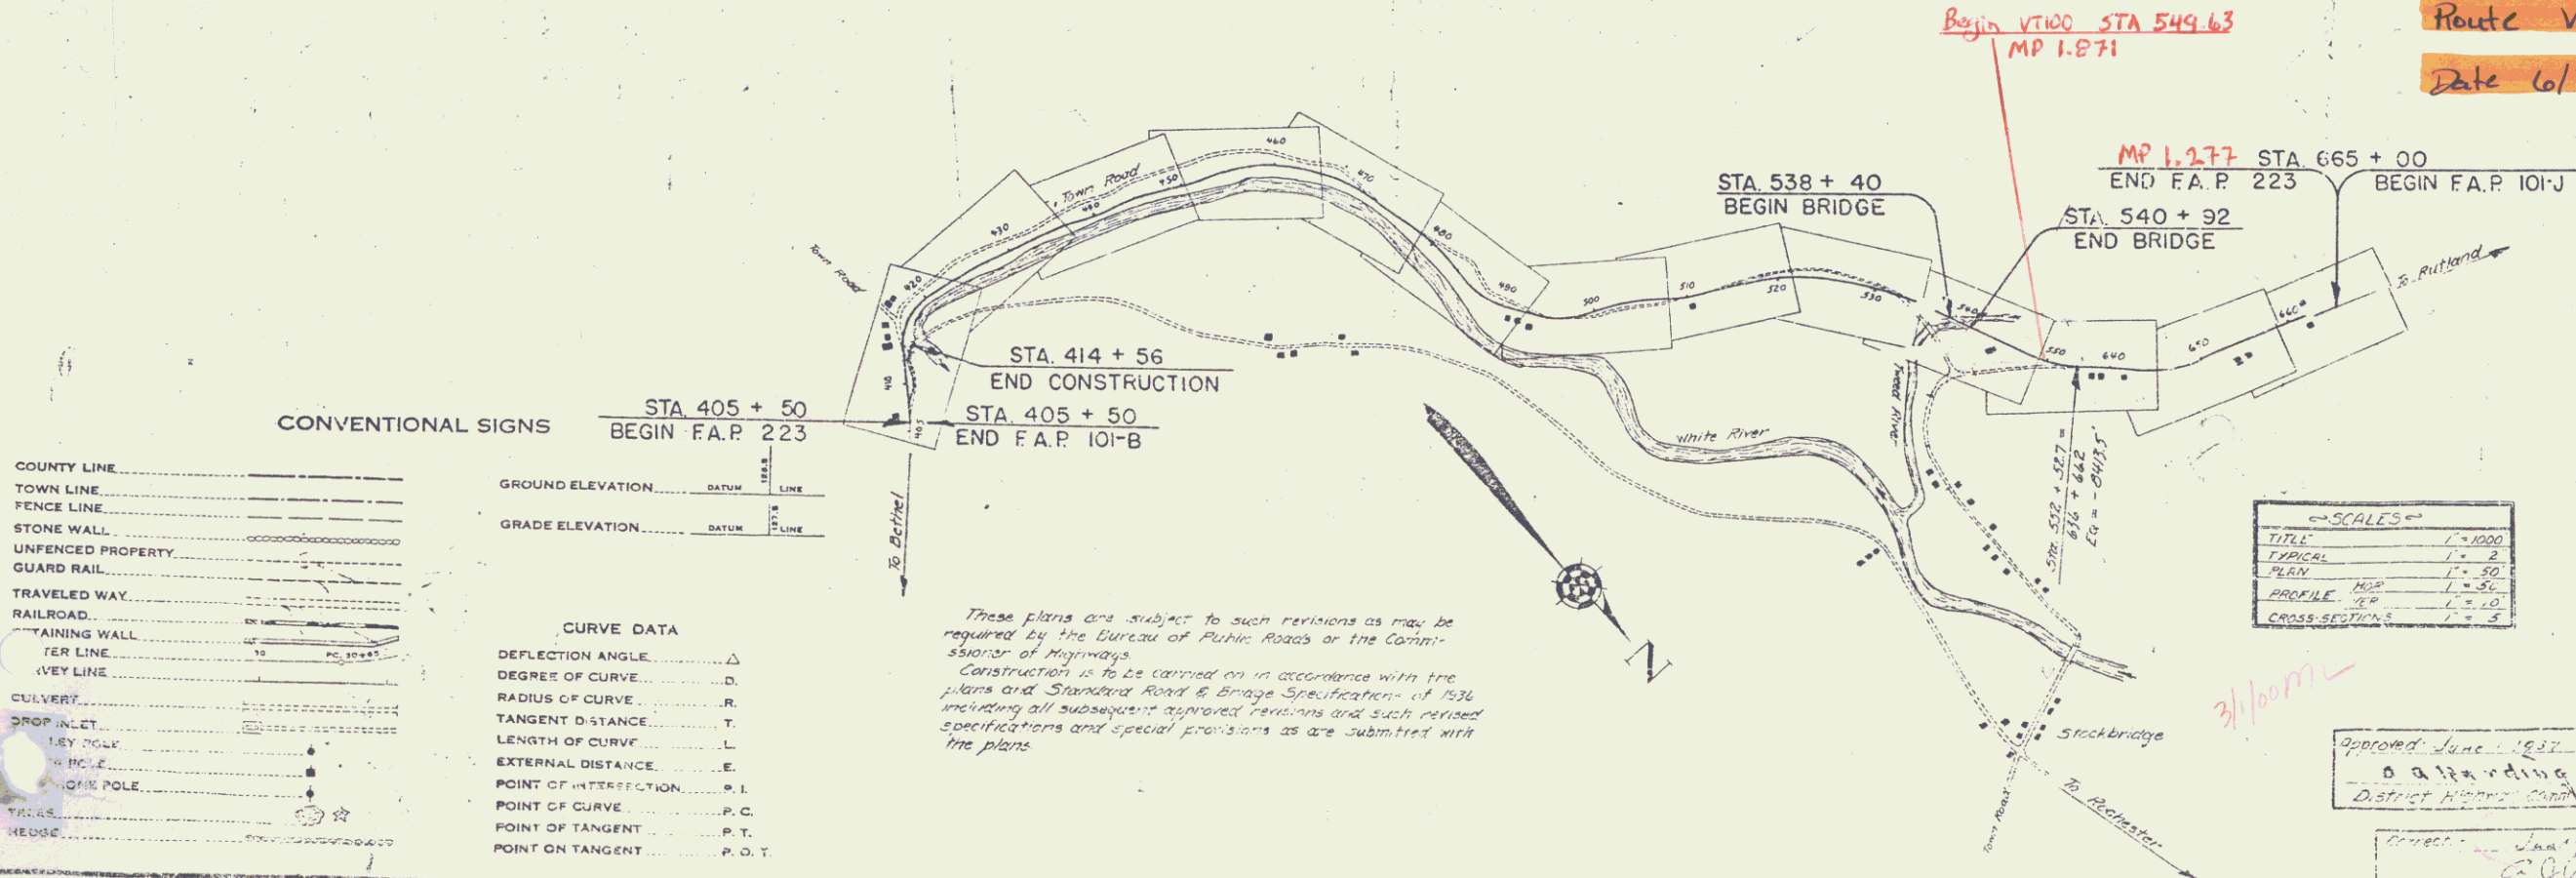


APPROVED: June 16, 1937  
F. E. Stewart  
COMMISSIONER OF HIGHWAYS  
SUBMITTED BY ORDER OF THE STATE HIGHWAY BOARD

RECOMMENDED  
DISTRICT ENGINEER  
RECOMMENDED FOR APPROVAL  
APPROVED  
DIRECTOR GENERAL

Approved June 1937  
District Engineer

Series F No. 2  
SHEET 1 OF 10


DIST. #4 PLANS

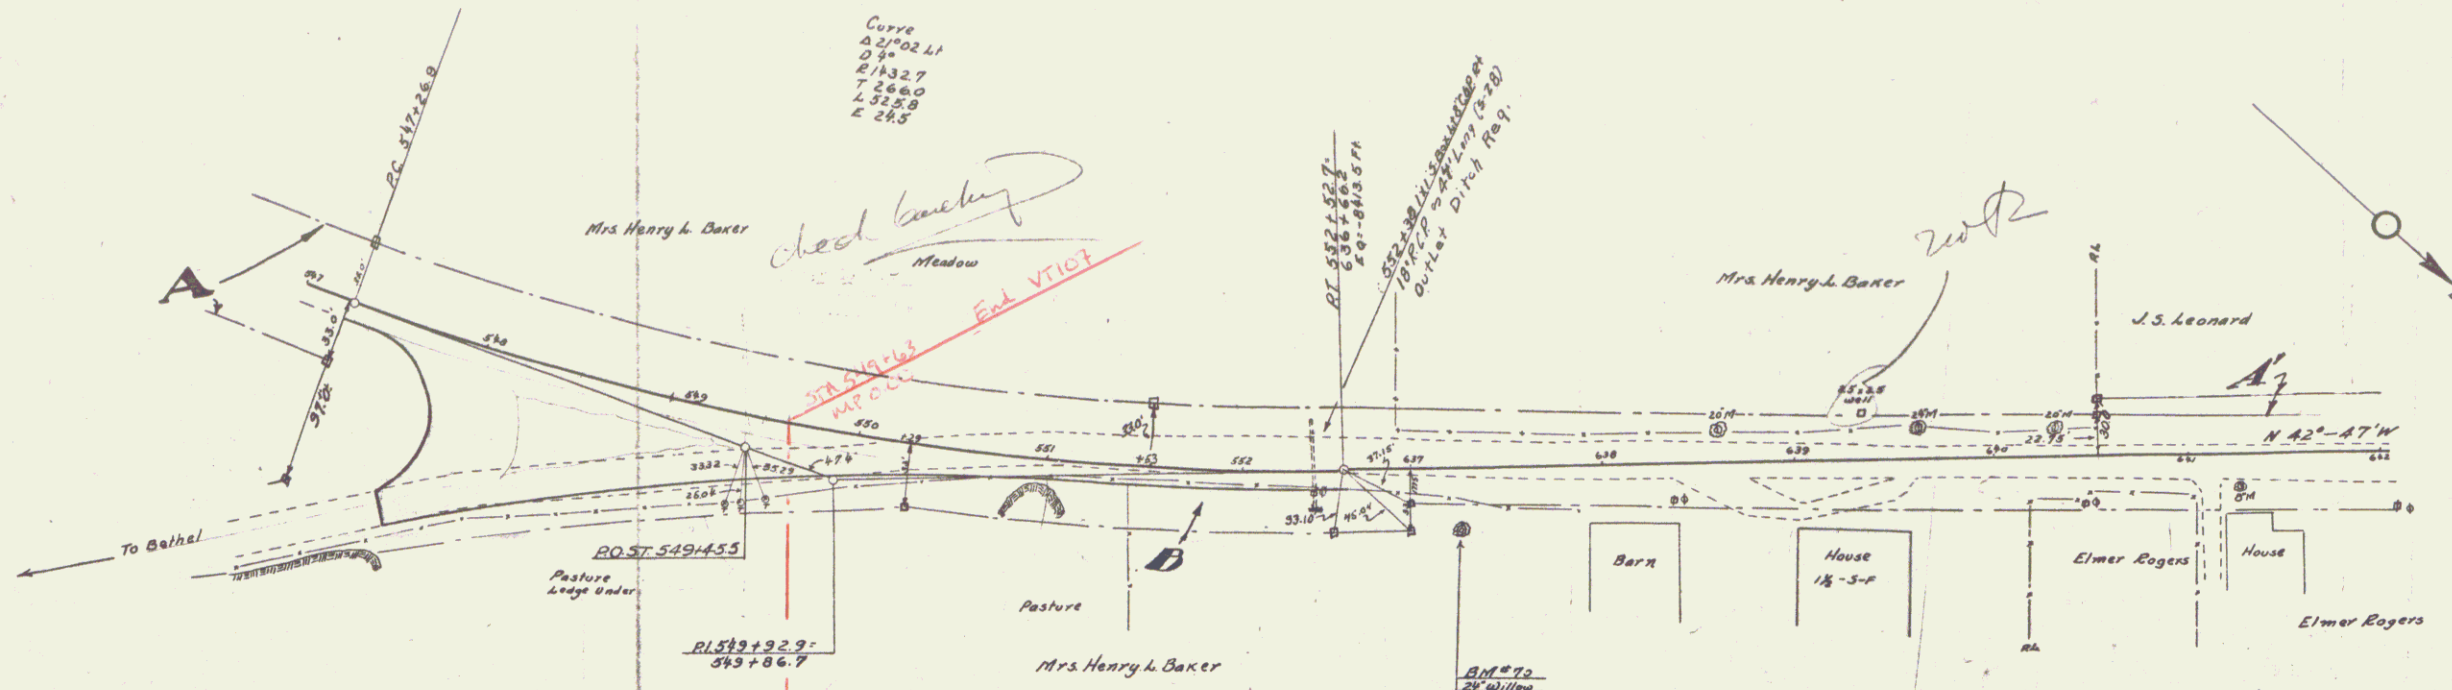


Begin VTI00  
MP 1.871

Note -  
Any rock encountered in excavation at Sta. 550+00± is to be used in making the embankment from Sta. 550+00 to the end of the project -

PARCEL	KIND OF INSTRUMENT	DATE OF INSTRUMENT	GRANTOR	GRANTEE	RECORDED BOOK PAGE DATE	REMARKS
A-B	W.D.	11-25-36	LULAM MUDON E. BAKER	J.S. LEONARD	29 317-318 12-2-36	
A'	G.C.D.	6-7-37	U.S. F. & L. LEONARD	"	29 334 6-20-36	
A''	PARTIAL RELEASE	FEDERAL LAND BANK				


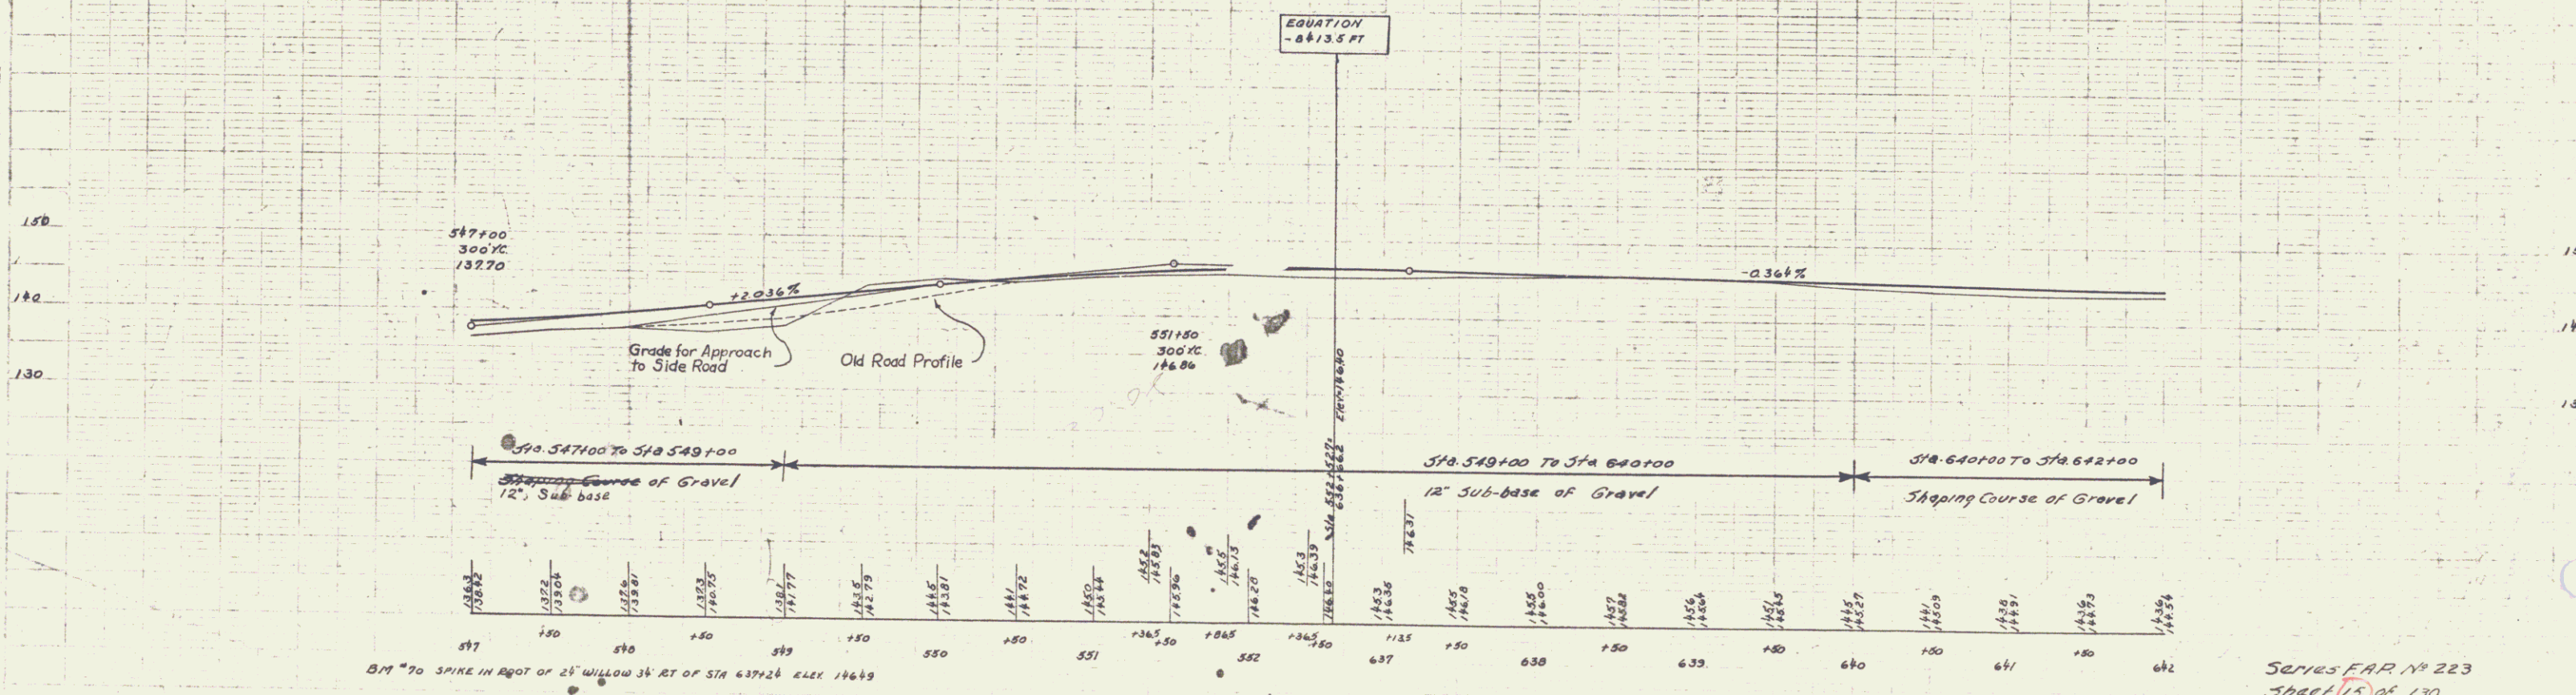


SERIES FAR No 223  
SHEET 15 OF 130

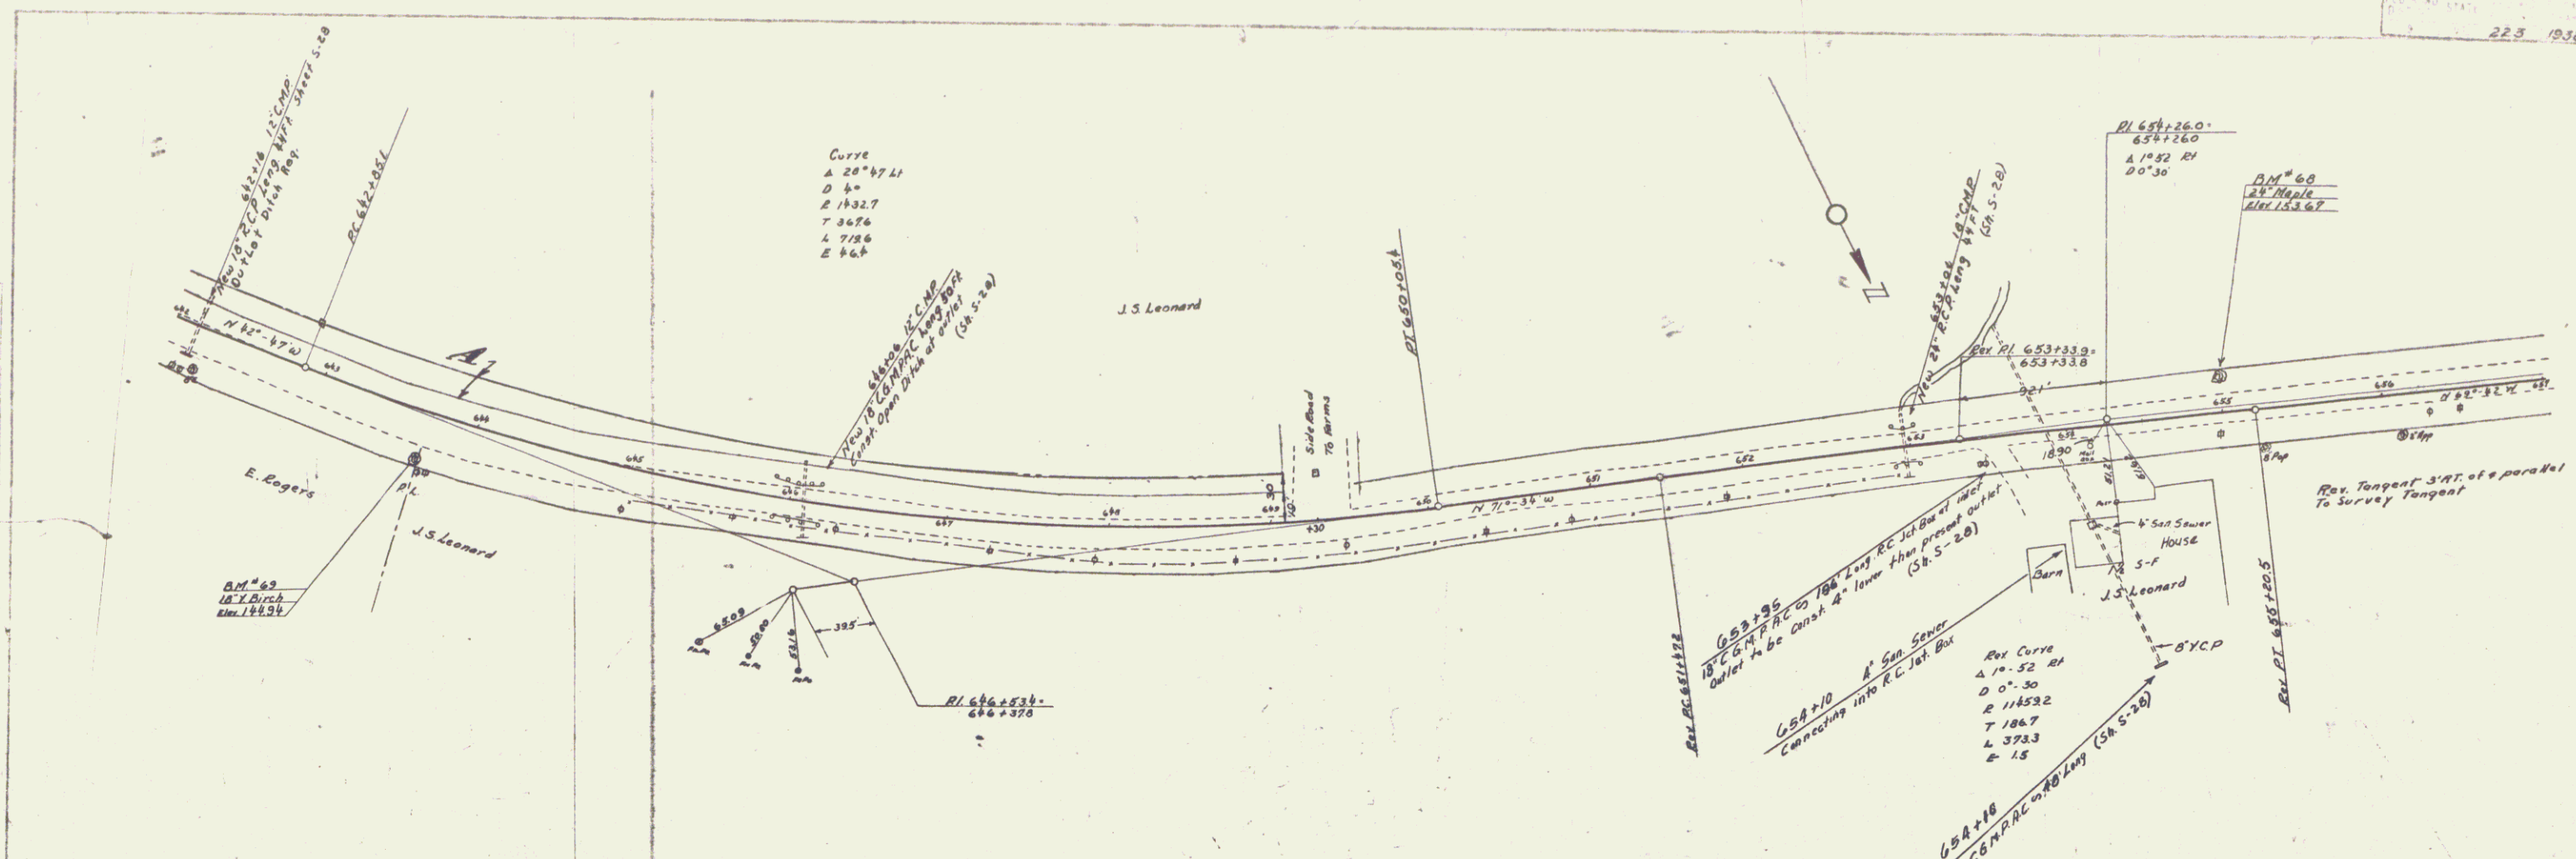


STATION	INSTRUMENT	DATE	GRANTOR	GRANTEE	RECORD	REMARKS
642	A	G.C.D.	G. F. 97	J.S. & A.B. LEONARD	2007	29 334 C-20-96
643	A					
644						
645						
BM #69 SPIRE IN ROOT OF 18" Y BIRCH 20 FT RT OF STA 643+69 ELEV. 148.36  
 BM #60 " " " " 24" MAPLE 16 FT. LT " " 655+00 = 153.07

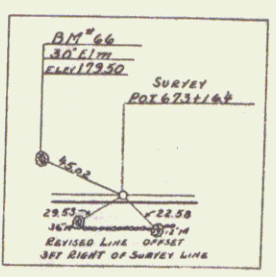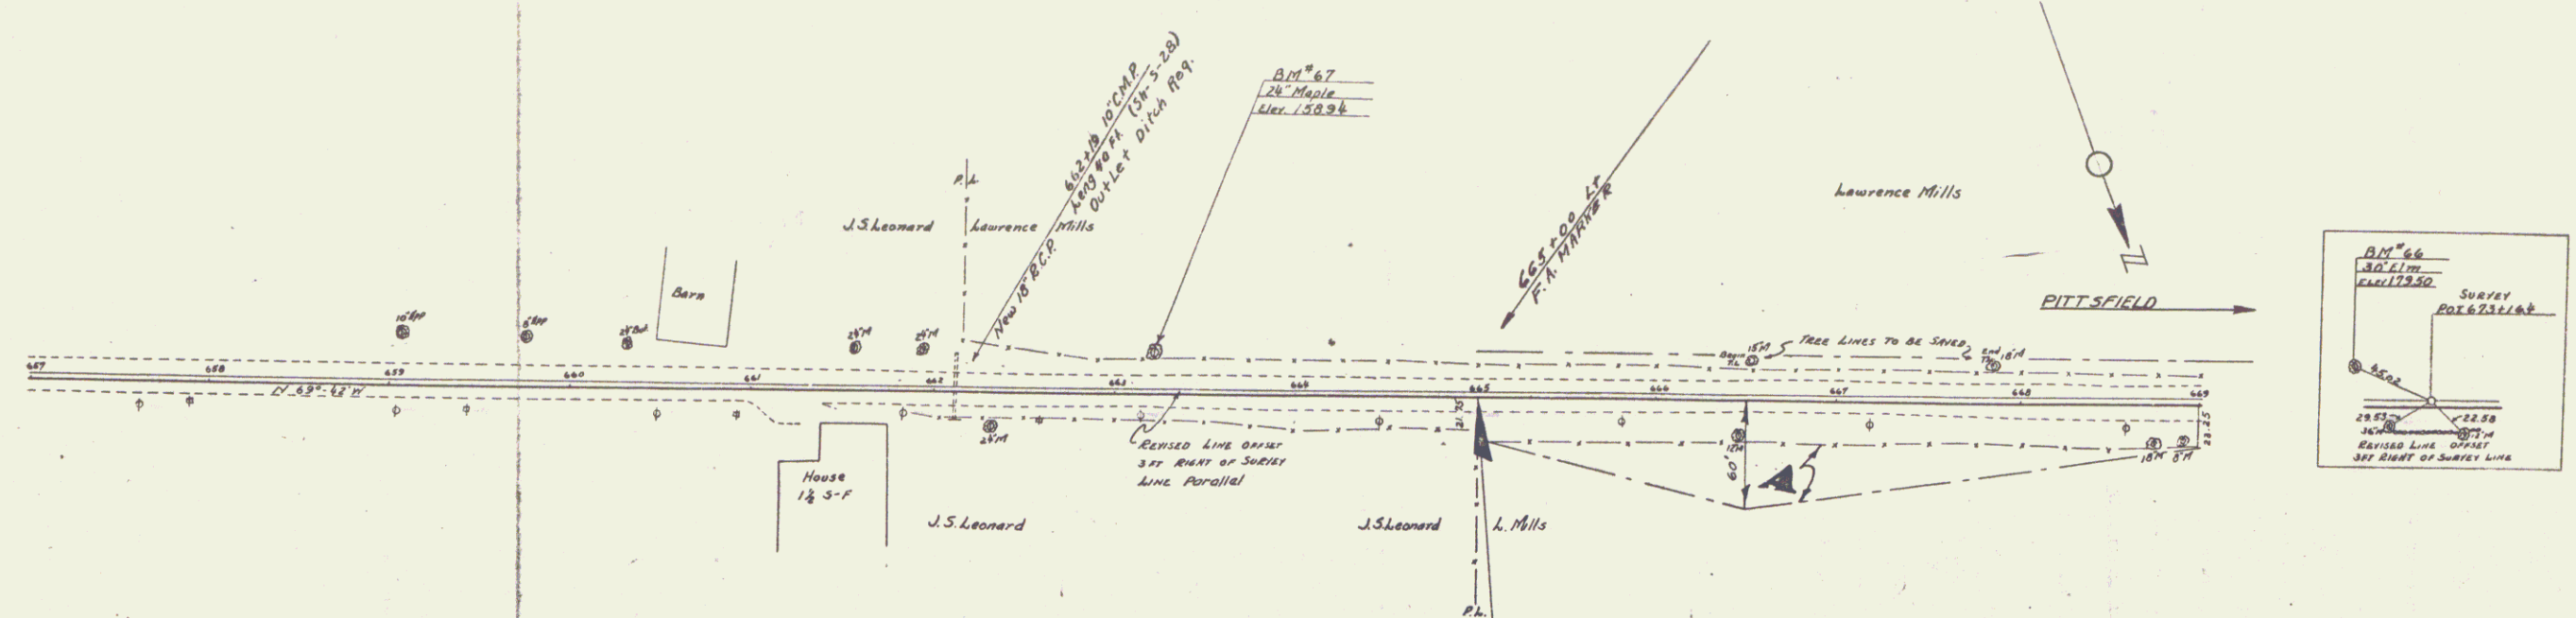

PARCEL	KIND OF INSTRUMENT	DATE OF INSTRUMENT	GRANTOR	GRANTEE	RECORDED STOCKBRIDGE BOOK PAGE DATE	REMARKS
A	Q.C.D.	12-23-36	LAWRENCE MILLS	STOFFY	29 319-20 12-23-36	

MP 1.277  
 END PROJECT FAP 223  
 BEGIN PROJECT FAP 1011

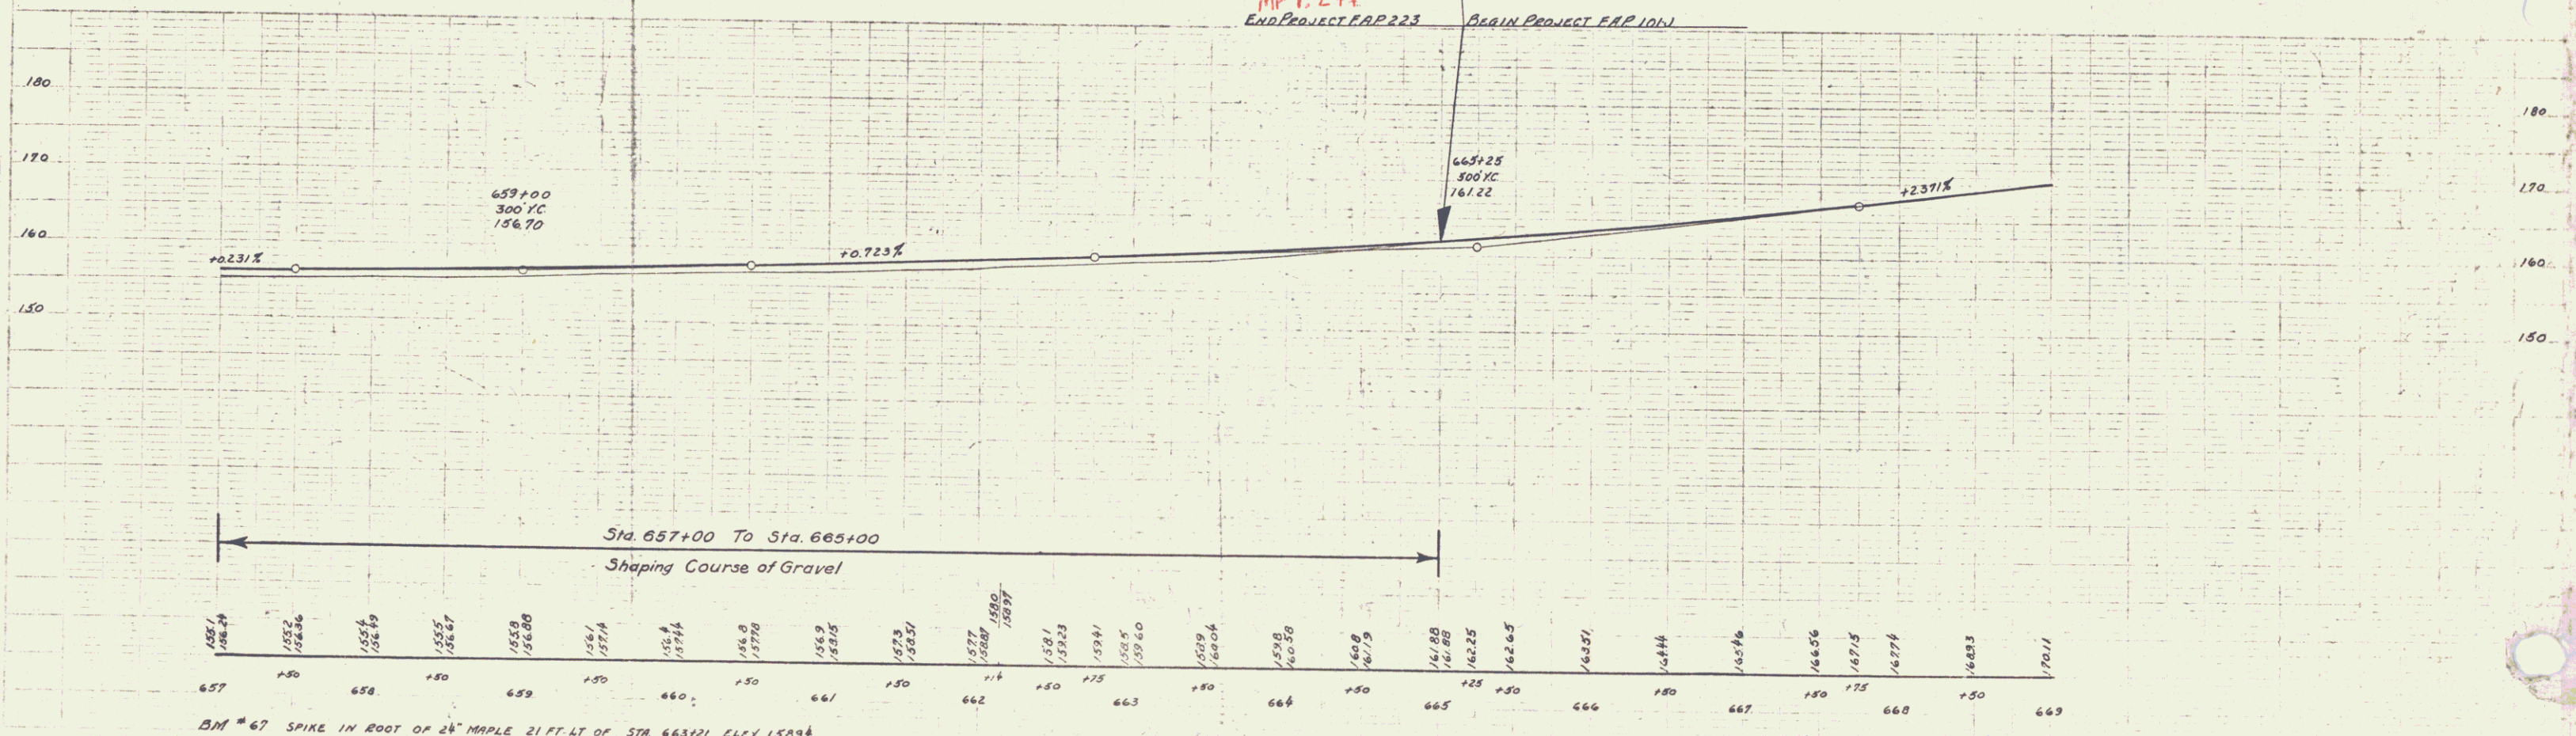

Sta 657+00 To Sta. 665+00  
 Shaping Course of Gravel

Station	Elevation
657	156.70
658	156.85
659	156.80
660	156.87
661	156.84
662	156.81
1000	146.67

BM # 67 SPIKE IN ROOT OF 24" MAPLE 21 FT. LT. OF STA 663+21 ELEV 158.94