



PLAN
 2. Highway
 1/4" = 100'
 DATE: 02/01/1943
 P.N. 00R661

PROFILE
 2. Highway
 1/4" = 100'
 DATE: 02/01/1943
 P.N. 00R661

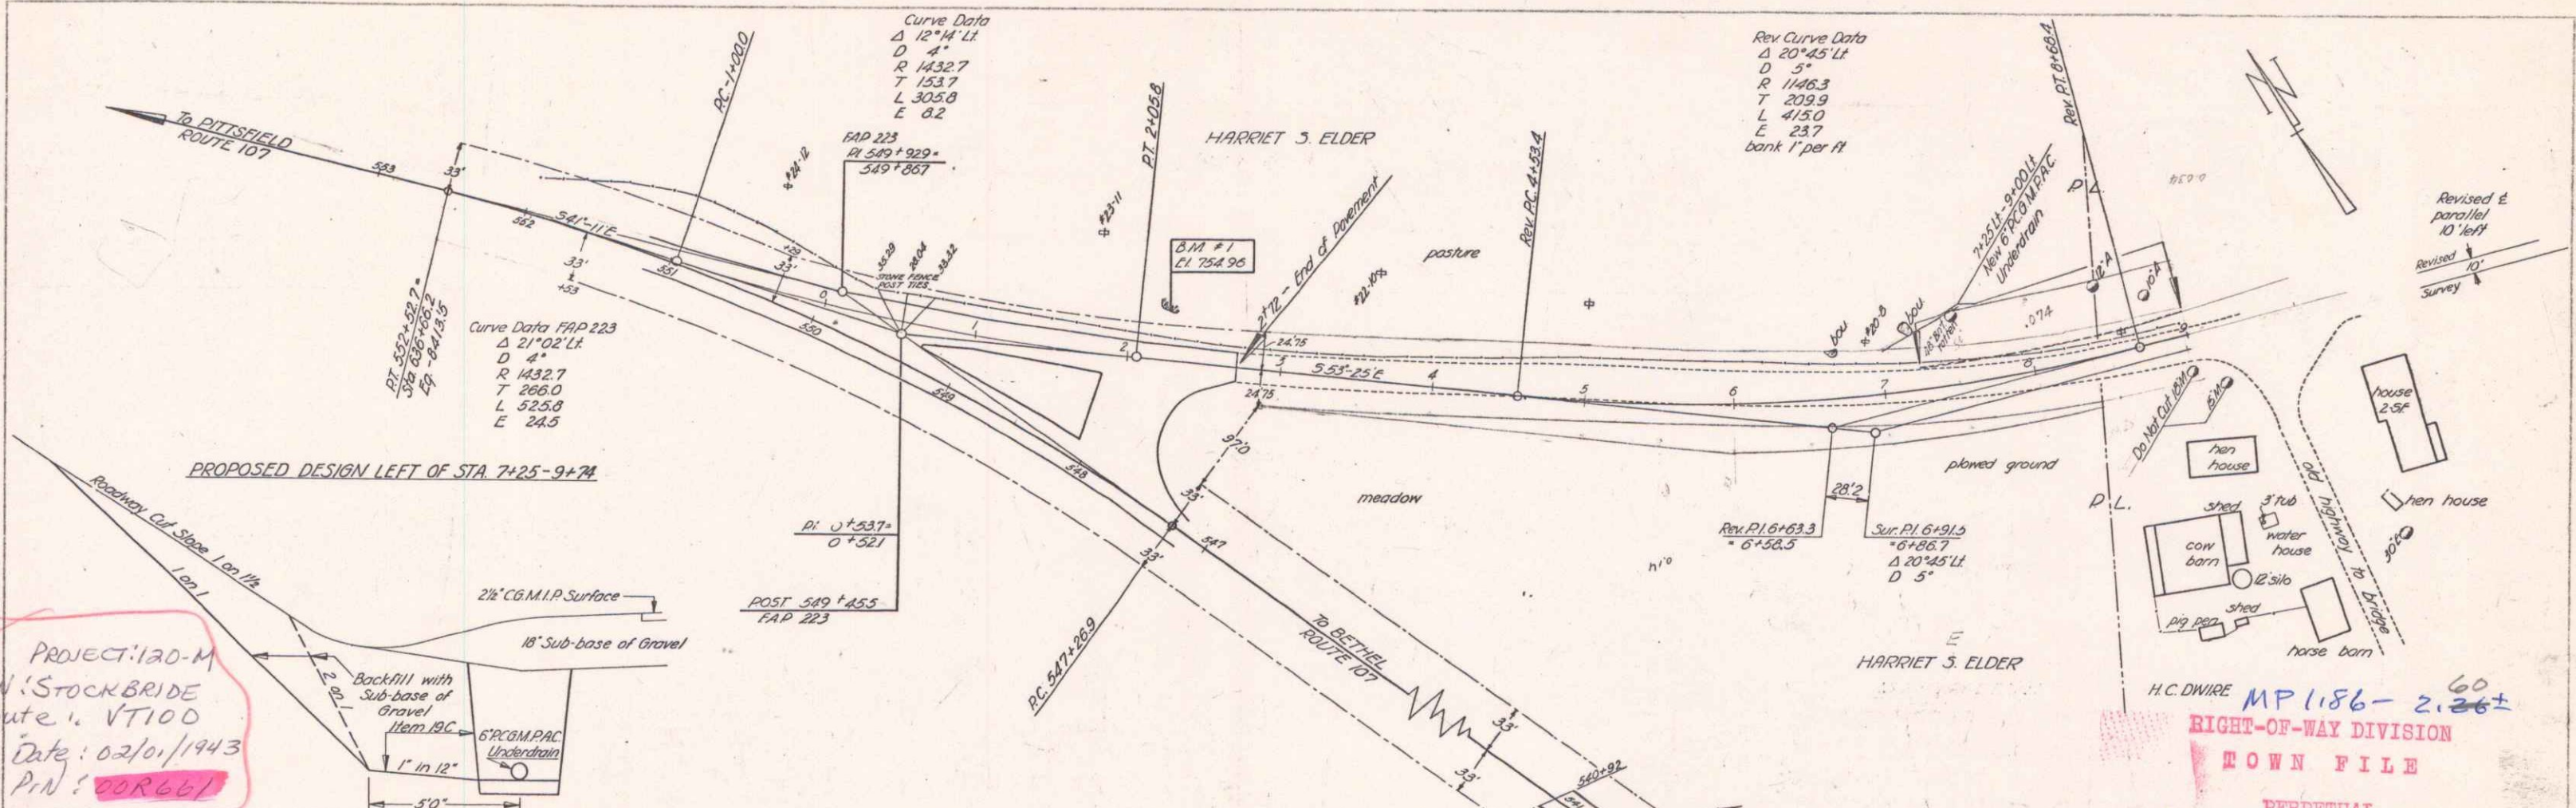

PROJECT 120-M
 TOWN STOCKBRIDGE
 Route 4, VT100
 Date: 02/01/1943
 P.N. 00R661

H.C. DWIRE MP 186-2.60±
 RIGHT-OF-WAY DIVISION
 TOWN FILE
 PERPETUAL
 Town of VT100
 (To Be Returned To R.O.W. Division)

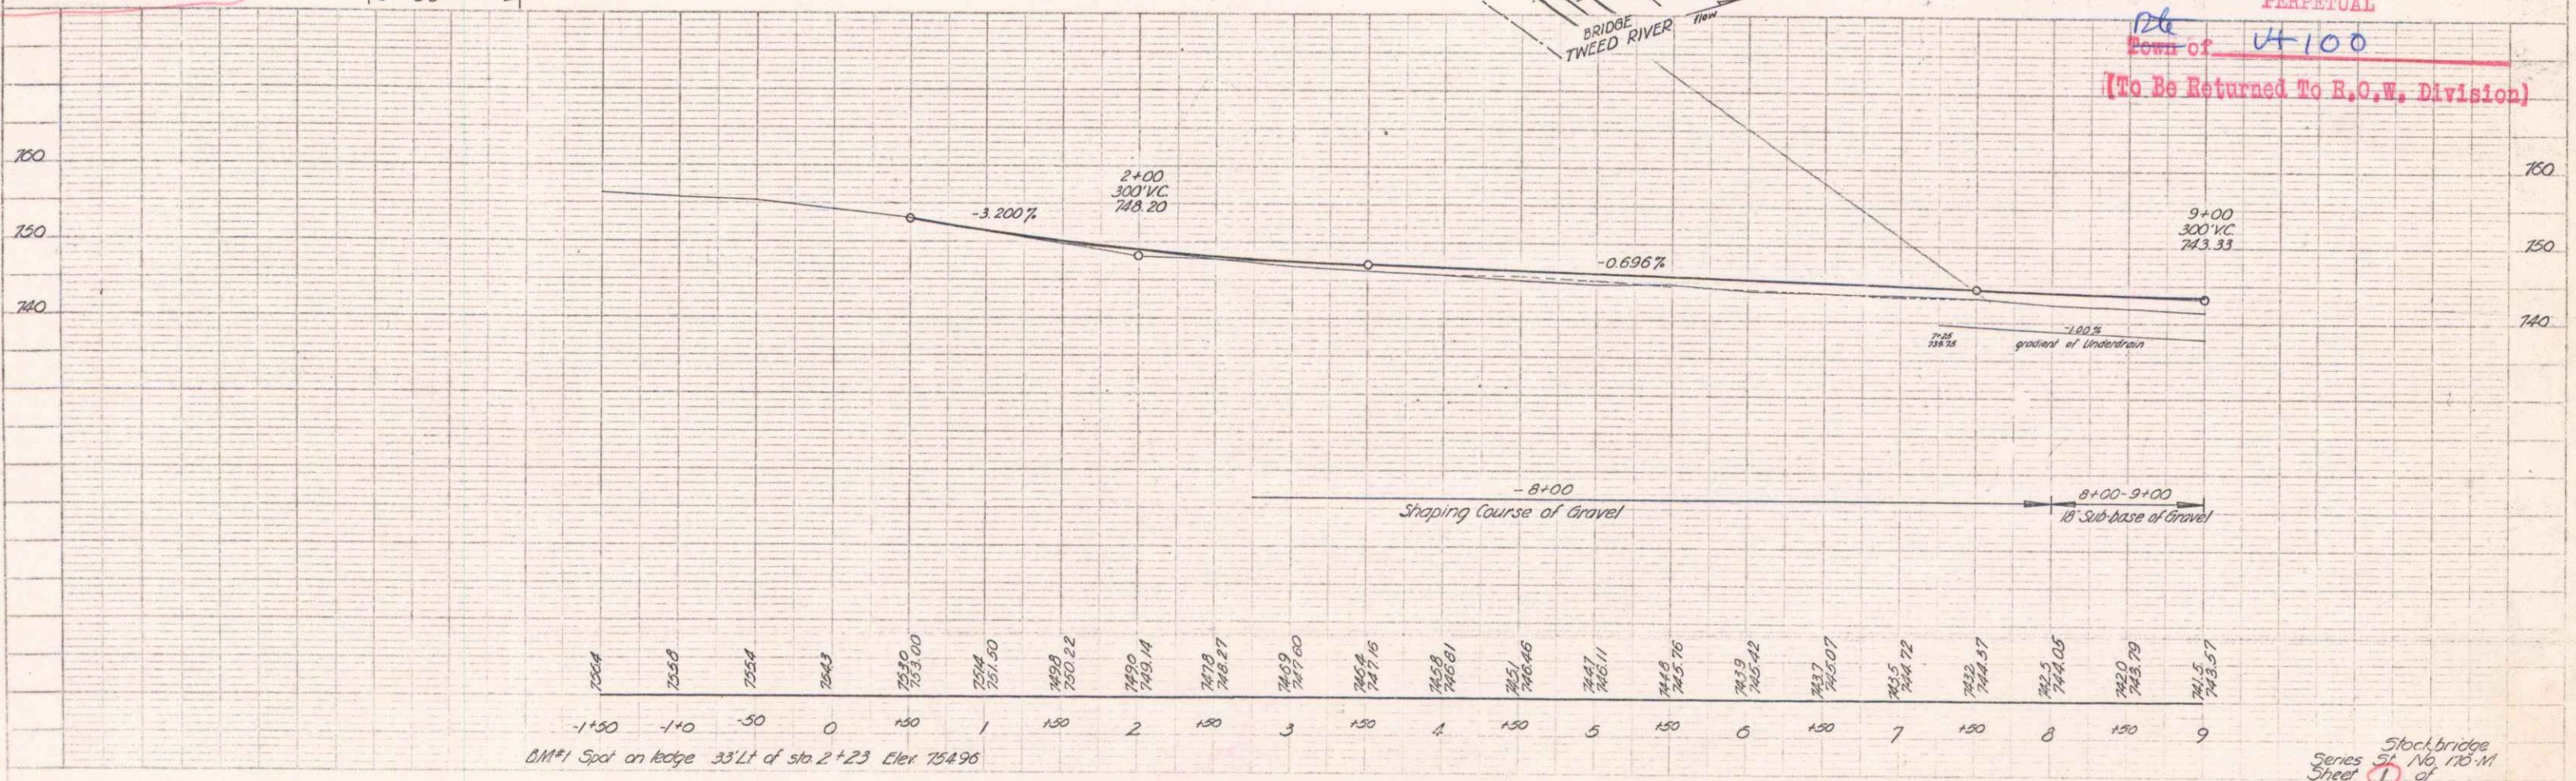

Stockbridge
 Series 51 No. 175-M
 Sheet 1 of 1