



PLAN  
 SUGGESTED  
 ABUTMENT  
 SHOW  
 HOW  
 TO  
 BE  
 USED  
 IN  
 THE  
 FIELD

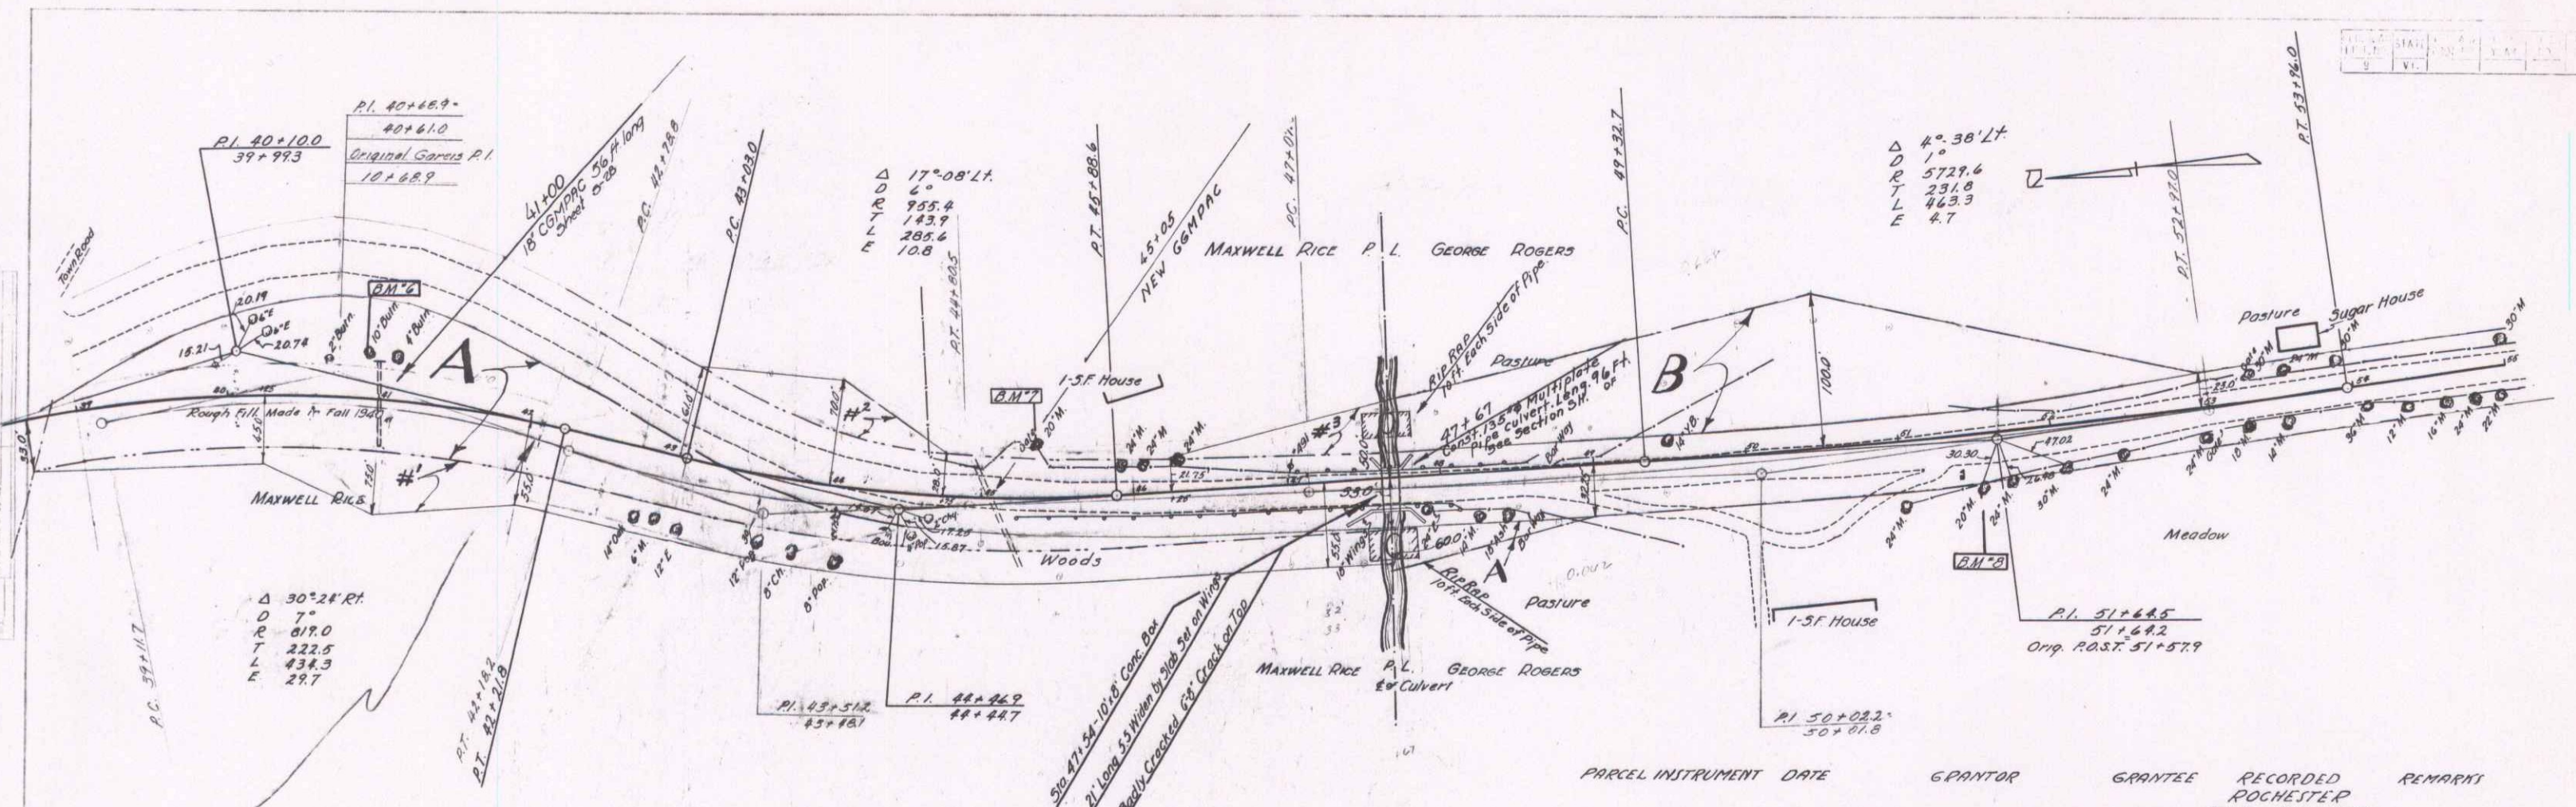

PARCEL	INSTRUMENT	DATE	GRANTOR	GRANTEE	RECORDED	REMARKS
A, B	W.D.O.E.	6-7-42	GEO. H. & HATTIE M. ROGERS	ST. OF VT.	29	256-78 6-11-42
A	W.D.O.E.	3-14-42	MAXWELL W. RICE	ST. OF VT.	29	276-77 10-3-42 SLOPE ERIG. W' H' M'

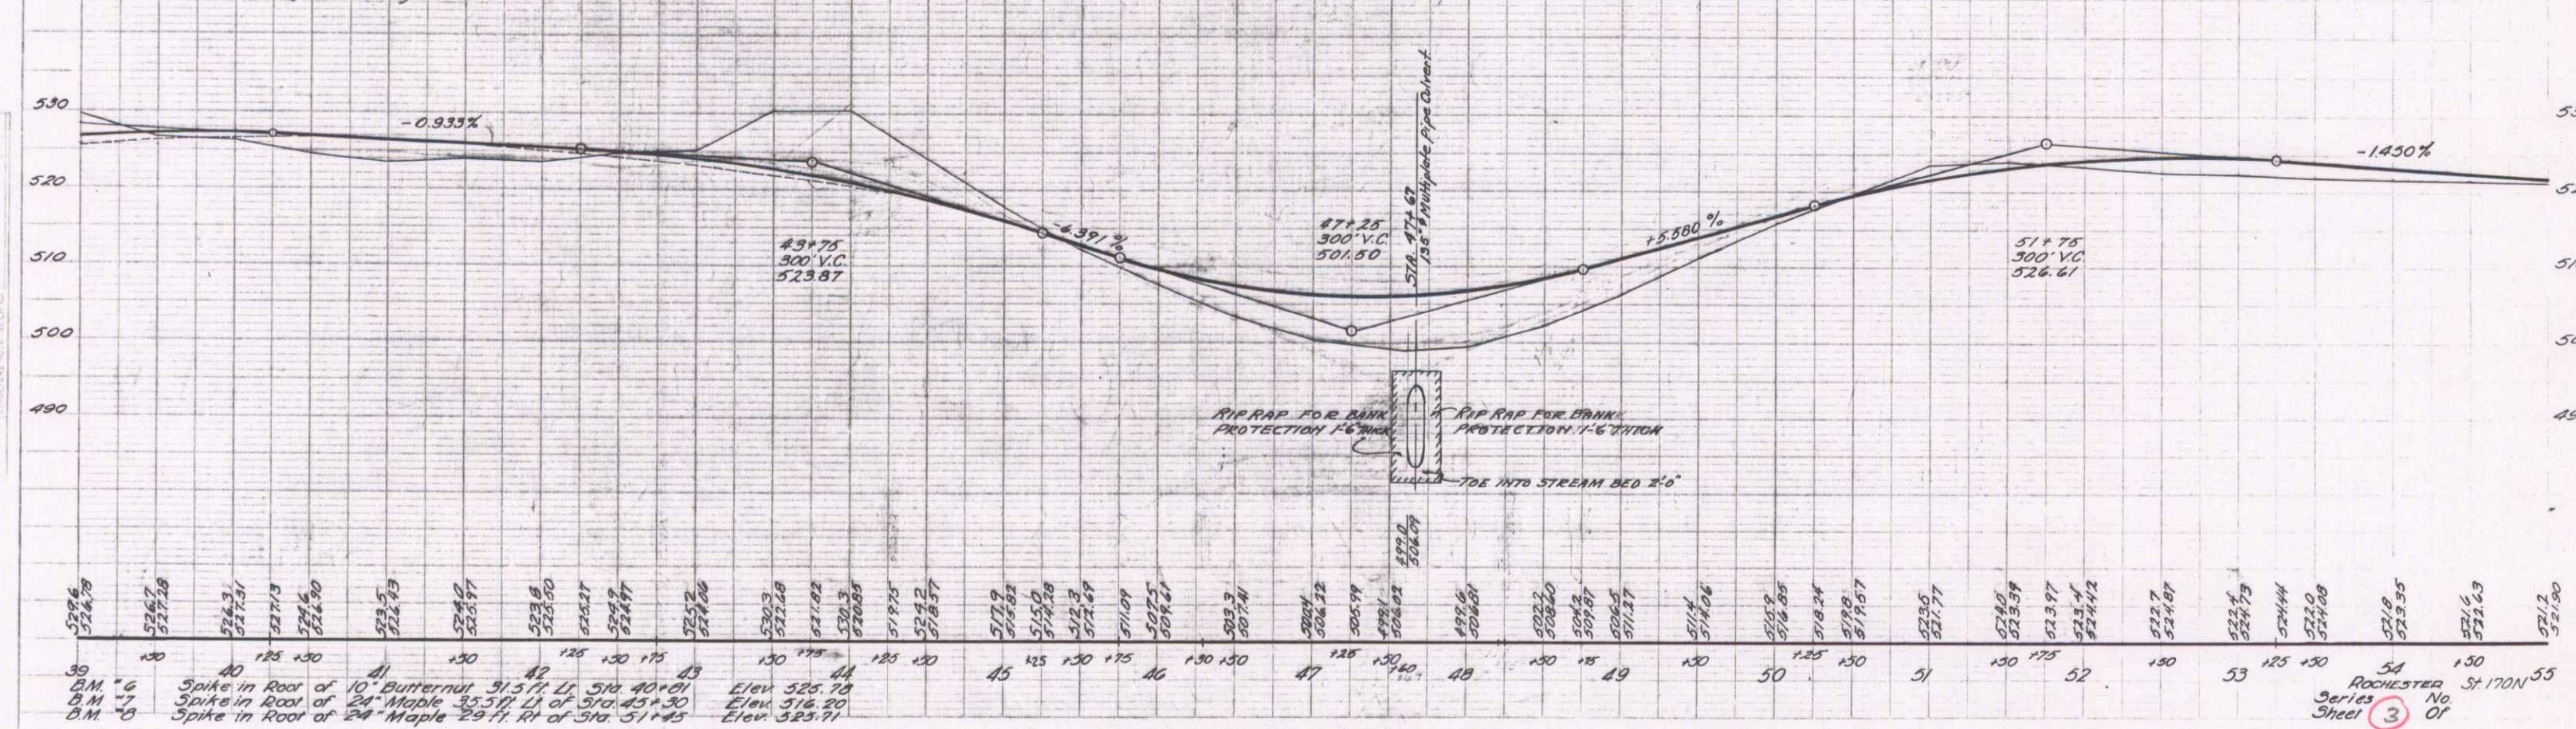

Station	Point	Description	Elevation
39	B.M. '6	Spike in Root of 10' Butternut	515.71
40	B.M. '7	Spike in Root of 24' Maple	514.45
41	B.M. '8	Spike in Root of 24' Maple	514.45
42		Butternut 31.5' LI of Sta 40+00	514.45
43		Maple 35.5' LI of Sta 45+30	516.20
44		Maple 29' RI of Sta 51+45	525.91

PLATE 1 - PLAN PROFILE 1:1 & 1:10  
 SHEET 3 OF 3  
 3