


- List of Sheets
 1-4 Plan & Profile Sheets
 5 Plan Sheet #28 (Pipe Culverts)
 6 Barricades Signs & Lights (JHO)
 6-21 Cross-Sections


DIST. NO.	STATE	FED. AID	FISCAL YEAR	SHEET NO.	TOTAL SHEETS
8	VT		1937	7	2

PLAN	DATE	BY
BARRETT	5/11/37	BARRETT

PROFILES	DATE	BY
BARRETT	5/11/37	BARRETT

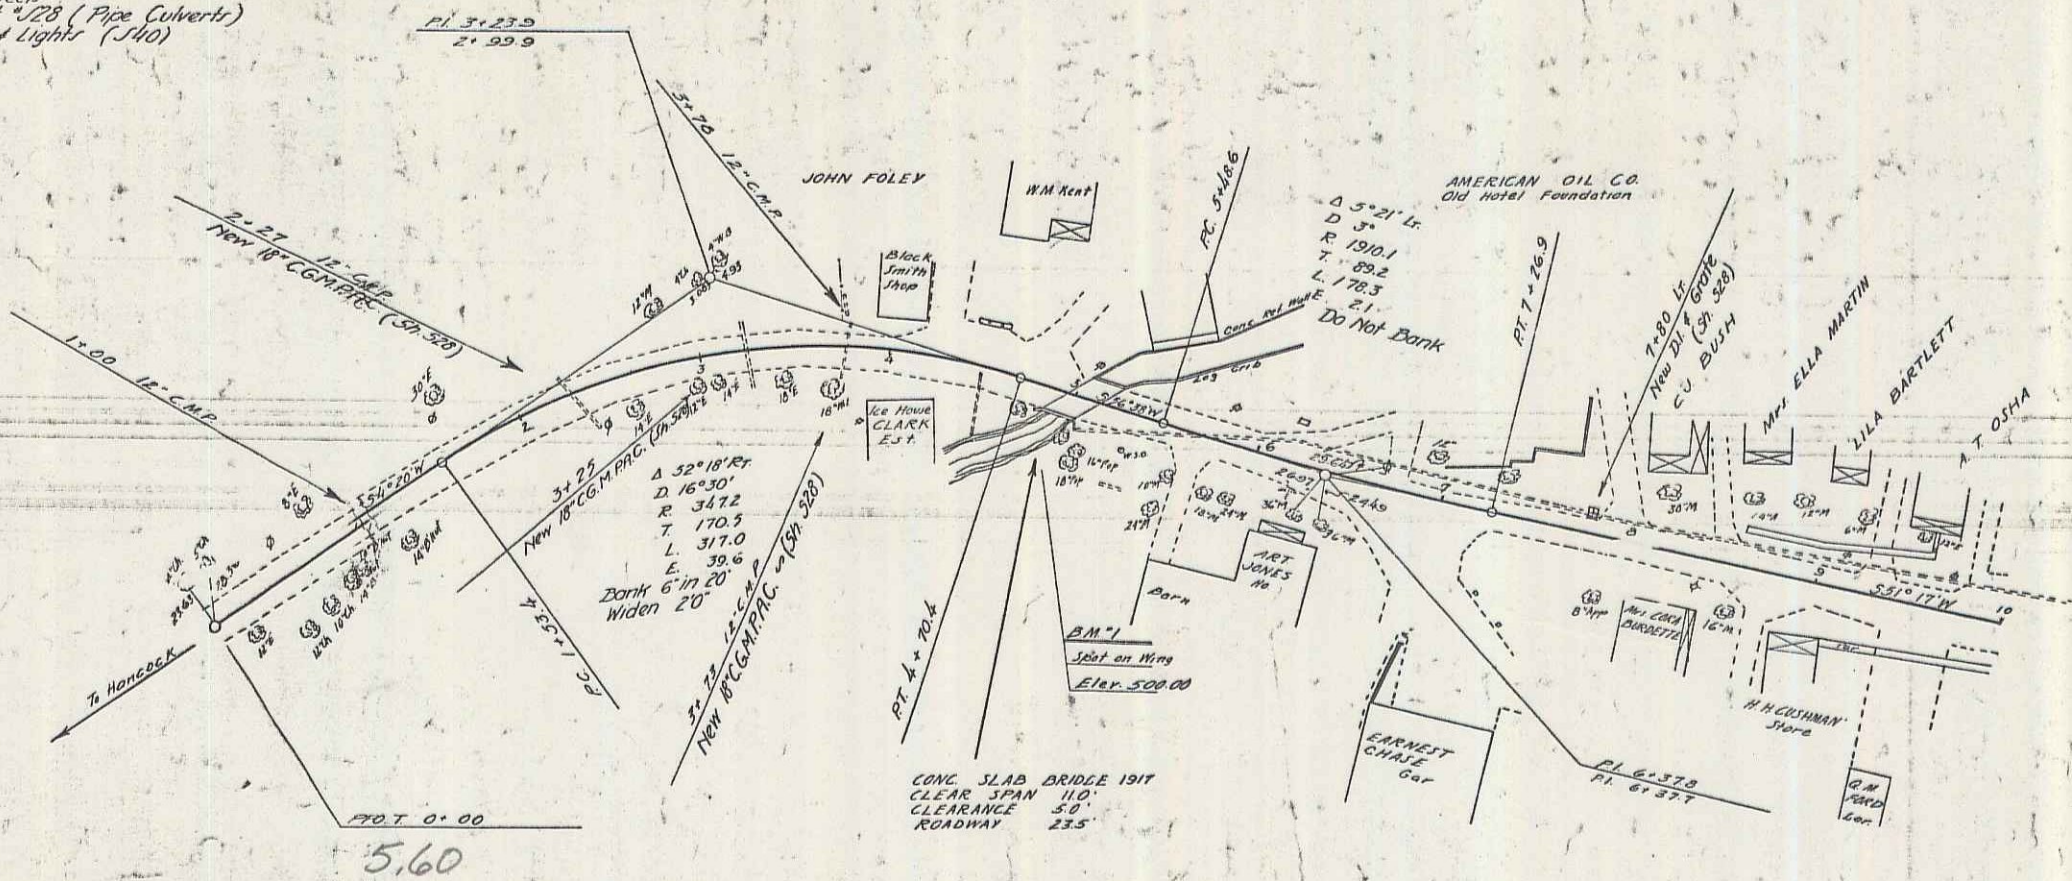

TOWN: ROCHESTER
 ROUTE: VT 100
 DATE: 05/01/1937
 PROJECT APP: 1019
 PIN: 208667

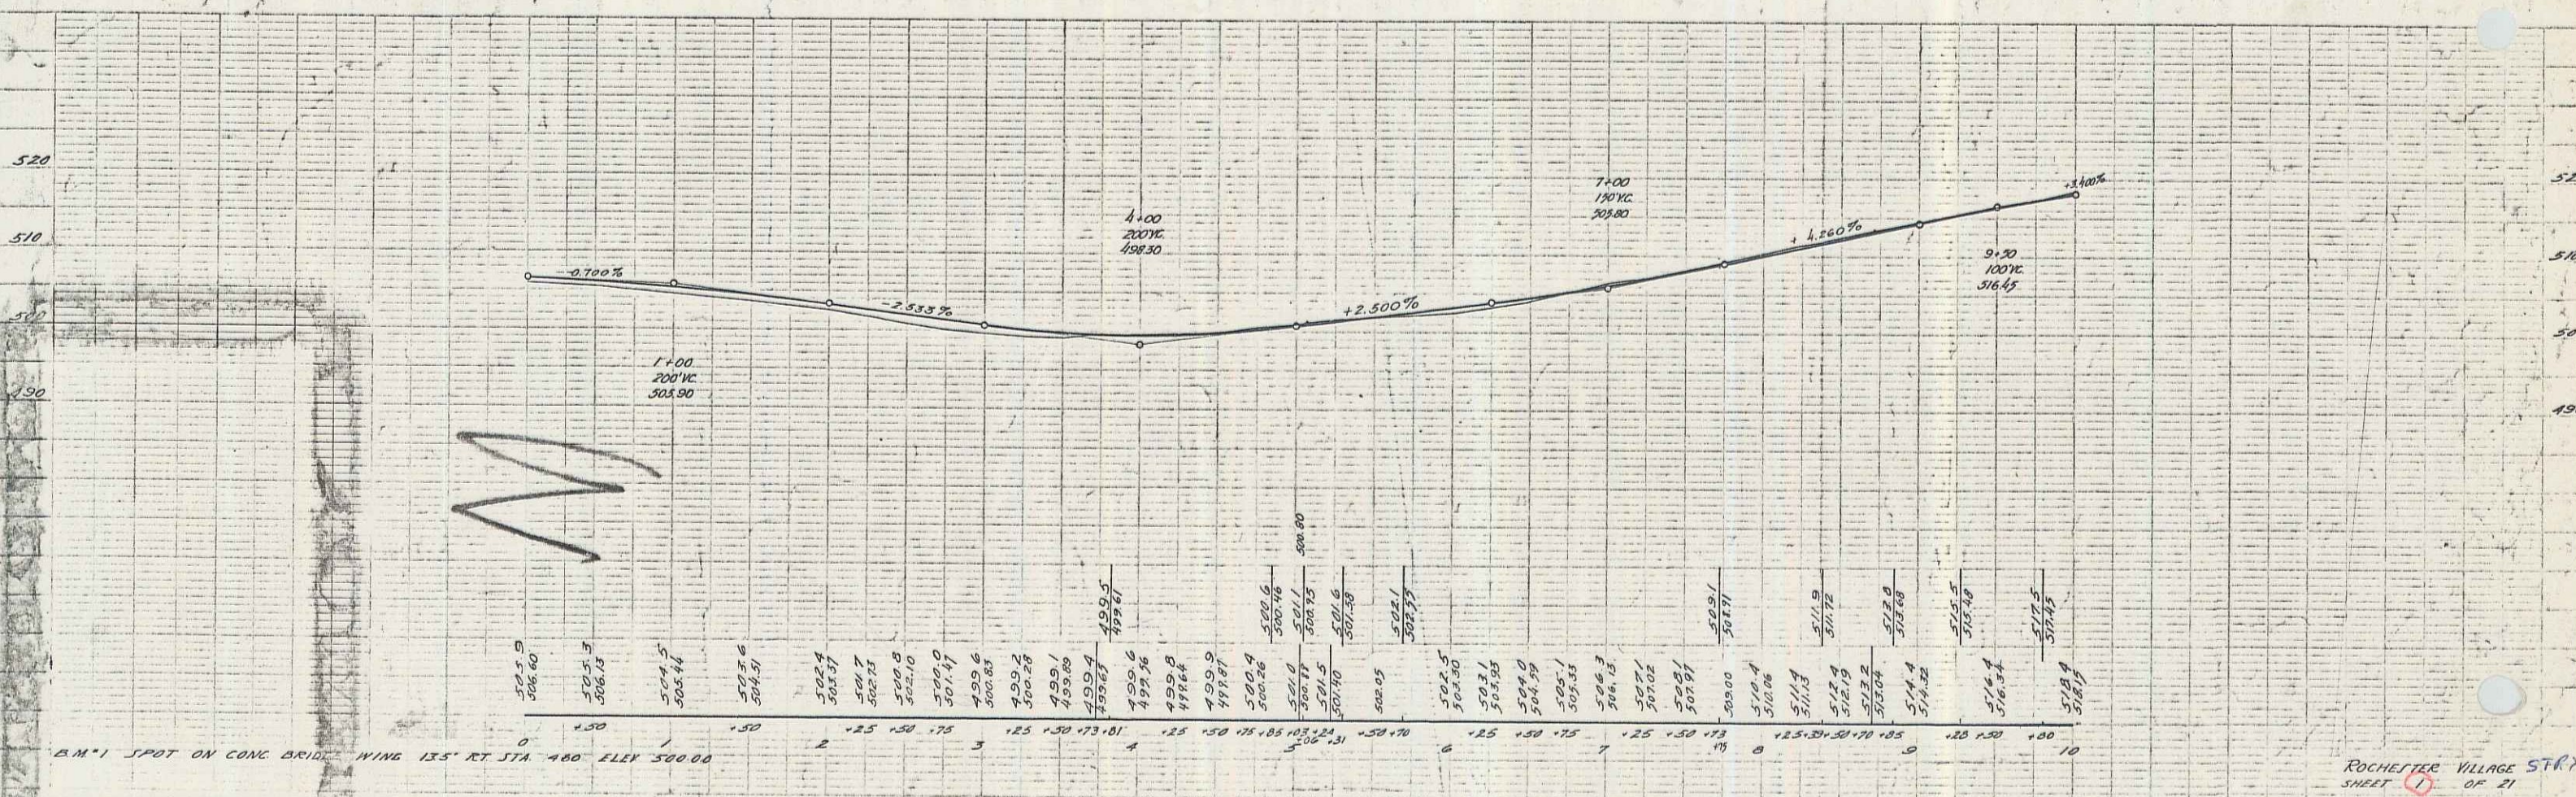

ROCHESTER VILLAGE STRY
 SHEET 7
 OF 21