

PLAN
DATE: 1/23/69
BY: J. H. HARRIS
CHECKED: J. H. HARRIS
NO. 1

PROFILE
DATE: 1/23/69
BY: J. H. HARRIS
CHECKED: J. H. HARRIS
NO. 1


PARCEL #1 - VICTOR B. BUTZ
BEG. STA. 15+31 LT.
END STA. 15+93 LT.
TAKING 900 SF. ±
REM. 2.08 AC.
RECORDED: 7-28-73 WD In the
Granville Land Records
Bk. 22 Pg. 87

REV. CURVE DATA
D = 115.30'
Δ = 43° 34'
R = 435.22'
T = 230.03'
L = 431.01'
E = 50.54'
BANK 12' / 11'

Rev. P.I. 14+45.0
Δ = 35° 52' L.A.
Rev. P.I. 15+16.17
14+87.12
Rev. P.O.C. 16+01.5
Widen Existing Br #153
to 32' 0" (Face to Face of Guardrail)

PRESENT BRIDGE DATA
Type 60T Beam
Spans 1860' Clear
Clear Height 8.0'
Waterway 309.18'
Overall Length 64'
Roadway Width 22.0'

- LIST OF SHEETS
1. PLAN AND PROFILE
 2. BRIDGE QUANTITY SHEET
 3. PLAN AND ELEVATION
 4. SUPERSTRUCTURE DETAILS
 5. ABUTMENT NO. 1
 6. ABUTMENT NO. 2
 7. REINFORCING SCHEDULE
 8. ROADWAY SECTIONS (STA 10+00-20+00)
 9. CHANNEL SECTIONS @ SURV STA 15+81.44
 10. CHANNEL SECTIONS @ SURV STA 16+40.56
 11. SCB-D1-67 1/24/68 APPR.
 12. SCB-D2-67 1/24/68 APPR.
 13. SCB-D3-67 1/24/68 APPR.
 14. STD SHT Q-3 9/1/66 REV
 15. STD SHT E-33 1/6/67 APPR.

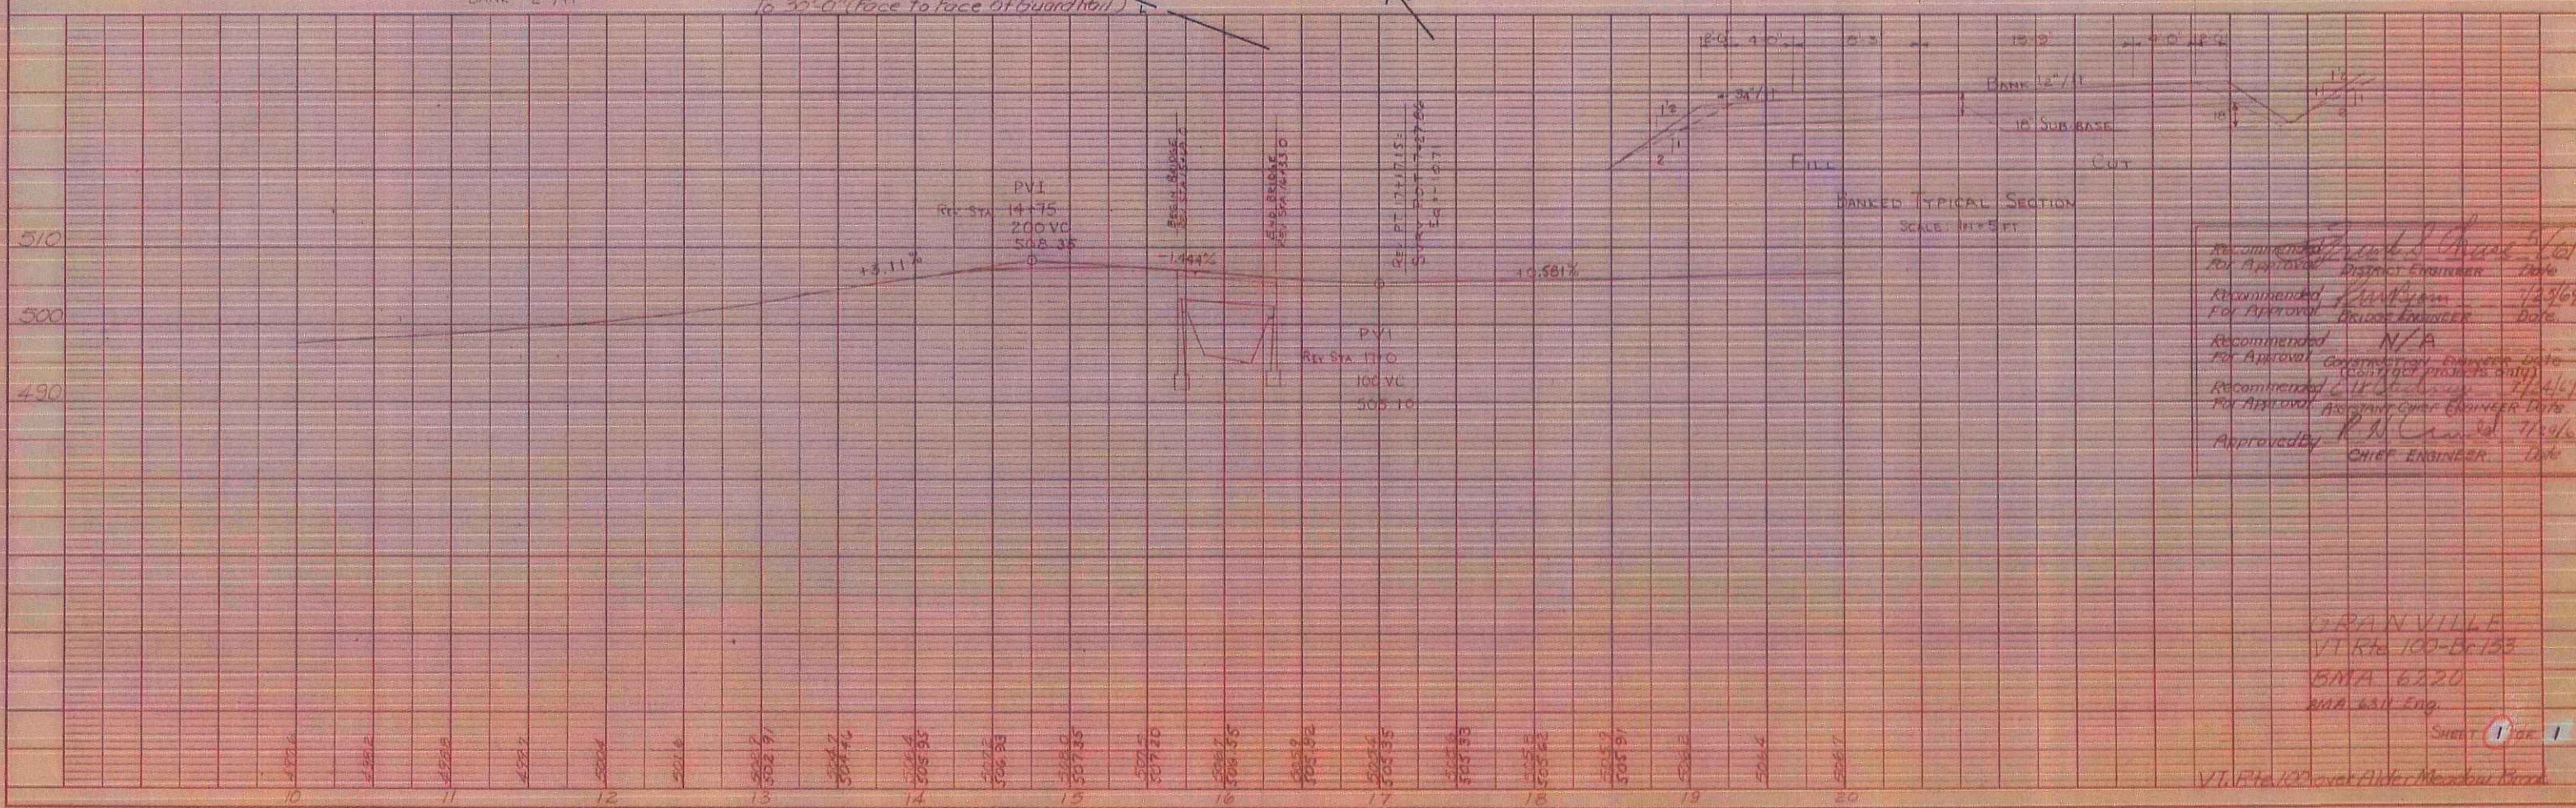

Recommended for Approval: *[Signature]* Date: 1/23/69
Recommended for Approval: *[Signature]* Date: 1/23/69
Recommended for Approval: *[Signature]* Date: 1/23/69
Recommended for Approval: *[Signature]* Date: 1/23/69
Approved by: *[Signature]* Date: 1/23/69
Chief Engineer

GRANVILLE
VT Rte 100-B-133
BMA 6820
RMA 6820 Eng.

SHEET 1 OF 1