


BMA-6811
BR #153 - Yt. Rte. 100
E.W. Bolkom
Room 418


PLAN
DATE BOOK
DRAWN BY
CHECKED BY

PROFILE
DATE BOOK
DRAWN BY
CHECKED BY

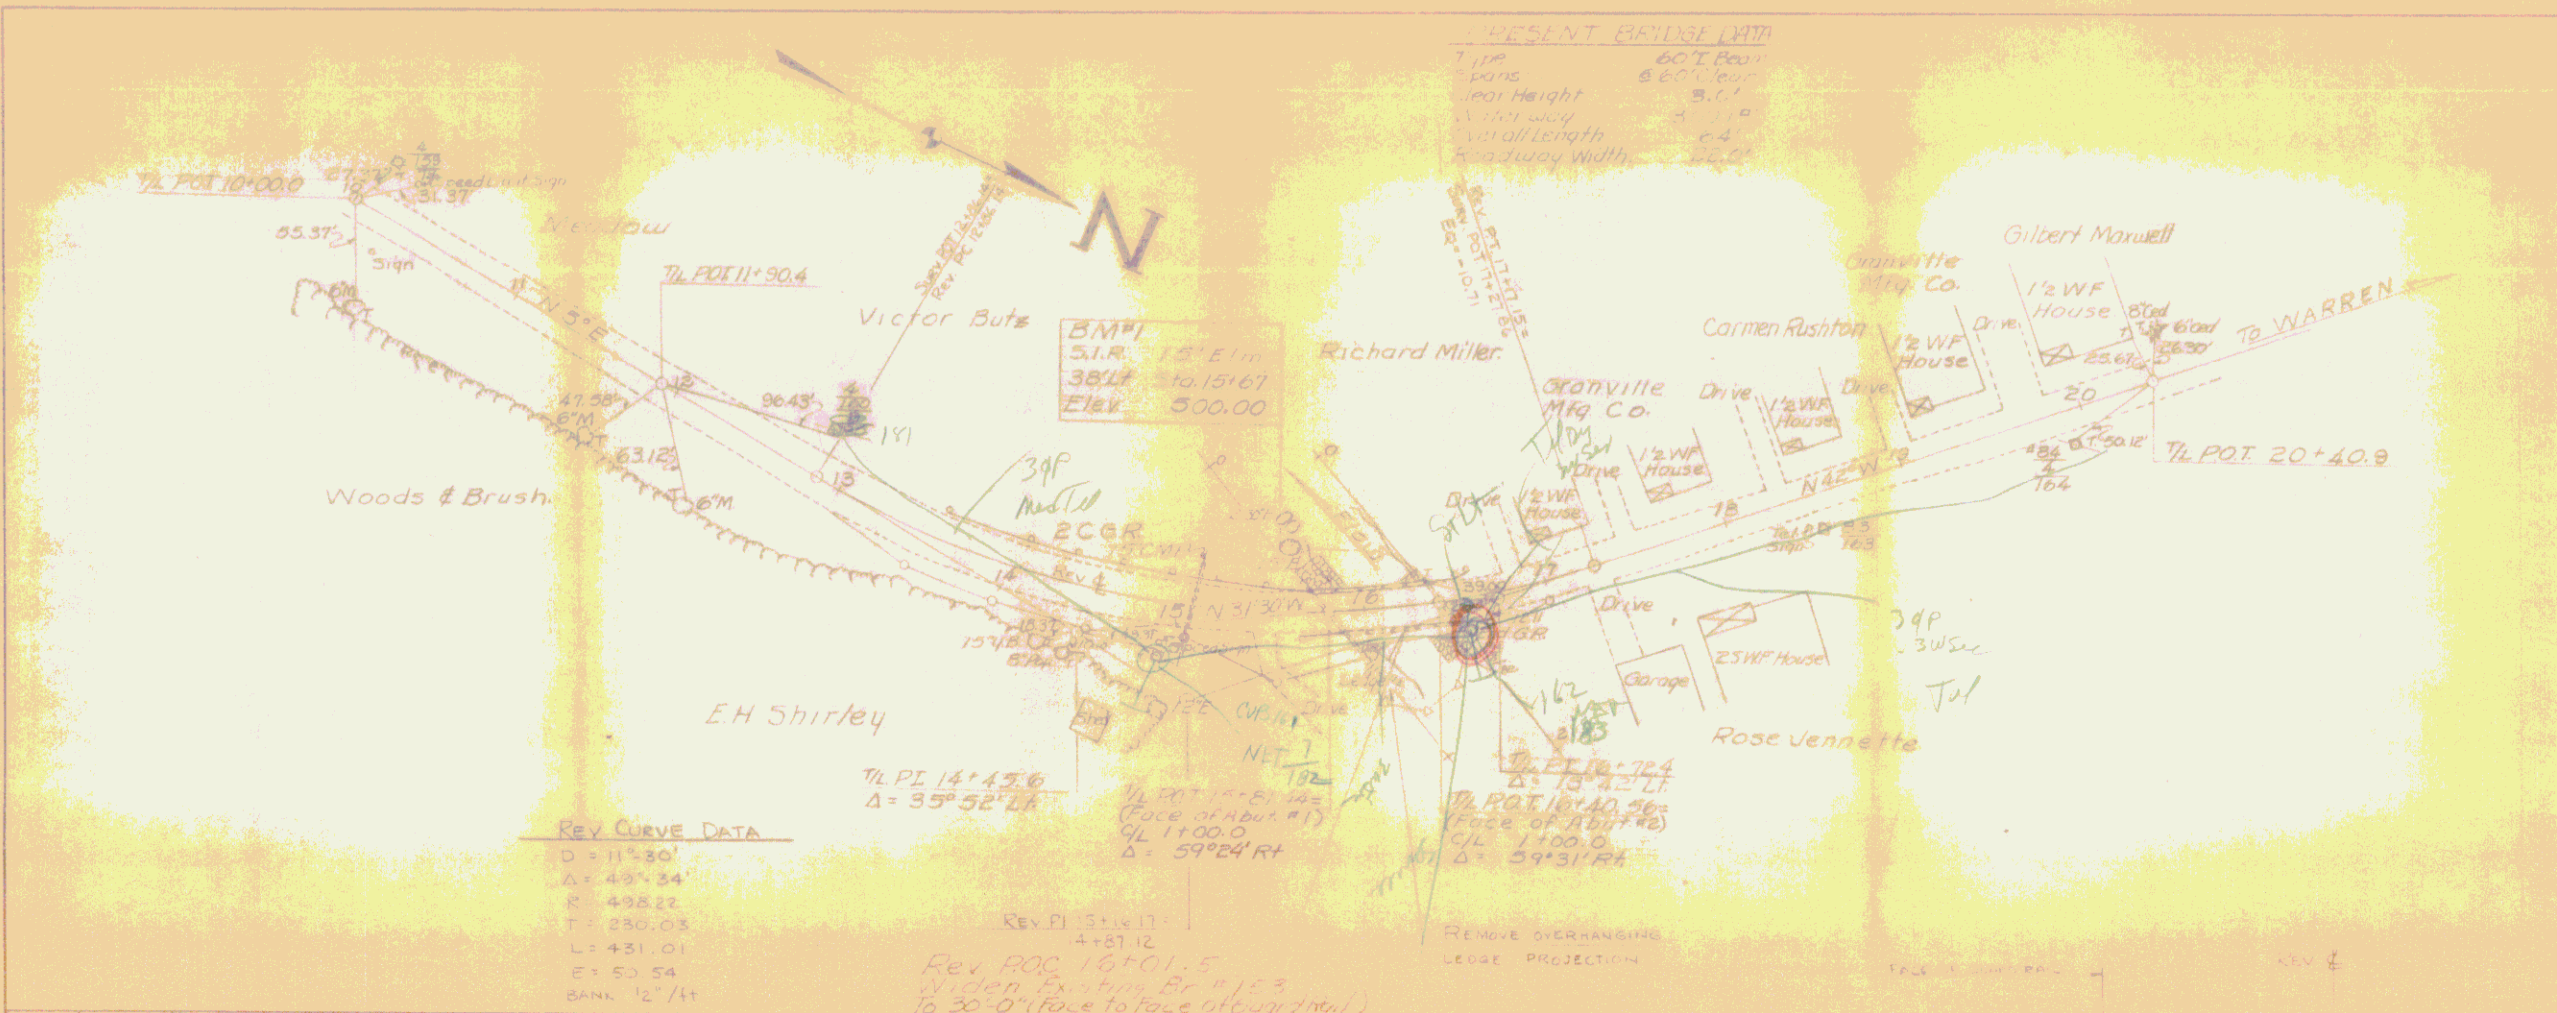

LIST OF SHEETS

1. PLAN AND PROFILE
2. BRIDGE QUANTITY SHEET
3. PLAN AND ELEVATION
4. SUPERSTRUCTURE DETAILS
5. ABUTMENT NO. 1
6. ABUTMENT NO. 2
7. REINFORCING SCHEDULE
8. ROADWAY SECTIONS (STA. 10+00-28+00)
9. CHANNEL SECTIONS @ SURV STA 15+00
10. CHANNEL SECTIONS @ SURV STA 16+00
11. SCB-D1-67 1/24/68 APPR.
12. SCB-D8-67 1/24/68 APPR.
13. SCB-D9-67 1/24/68 APPR.
14. STD. SHT. G-3 9/1/66 REV.
15. STD. SHT. E-33 1/6/67 APPR.

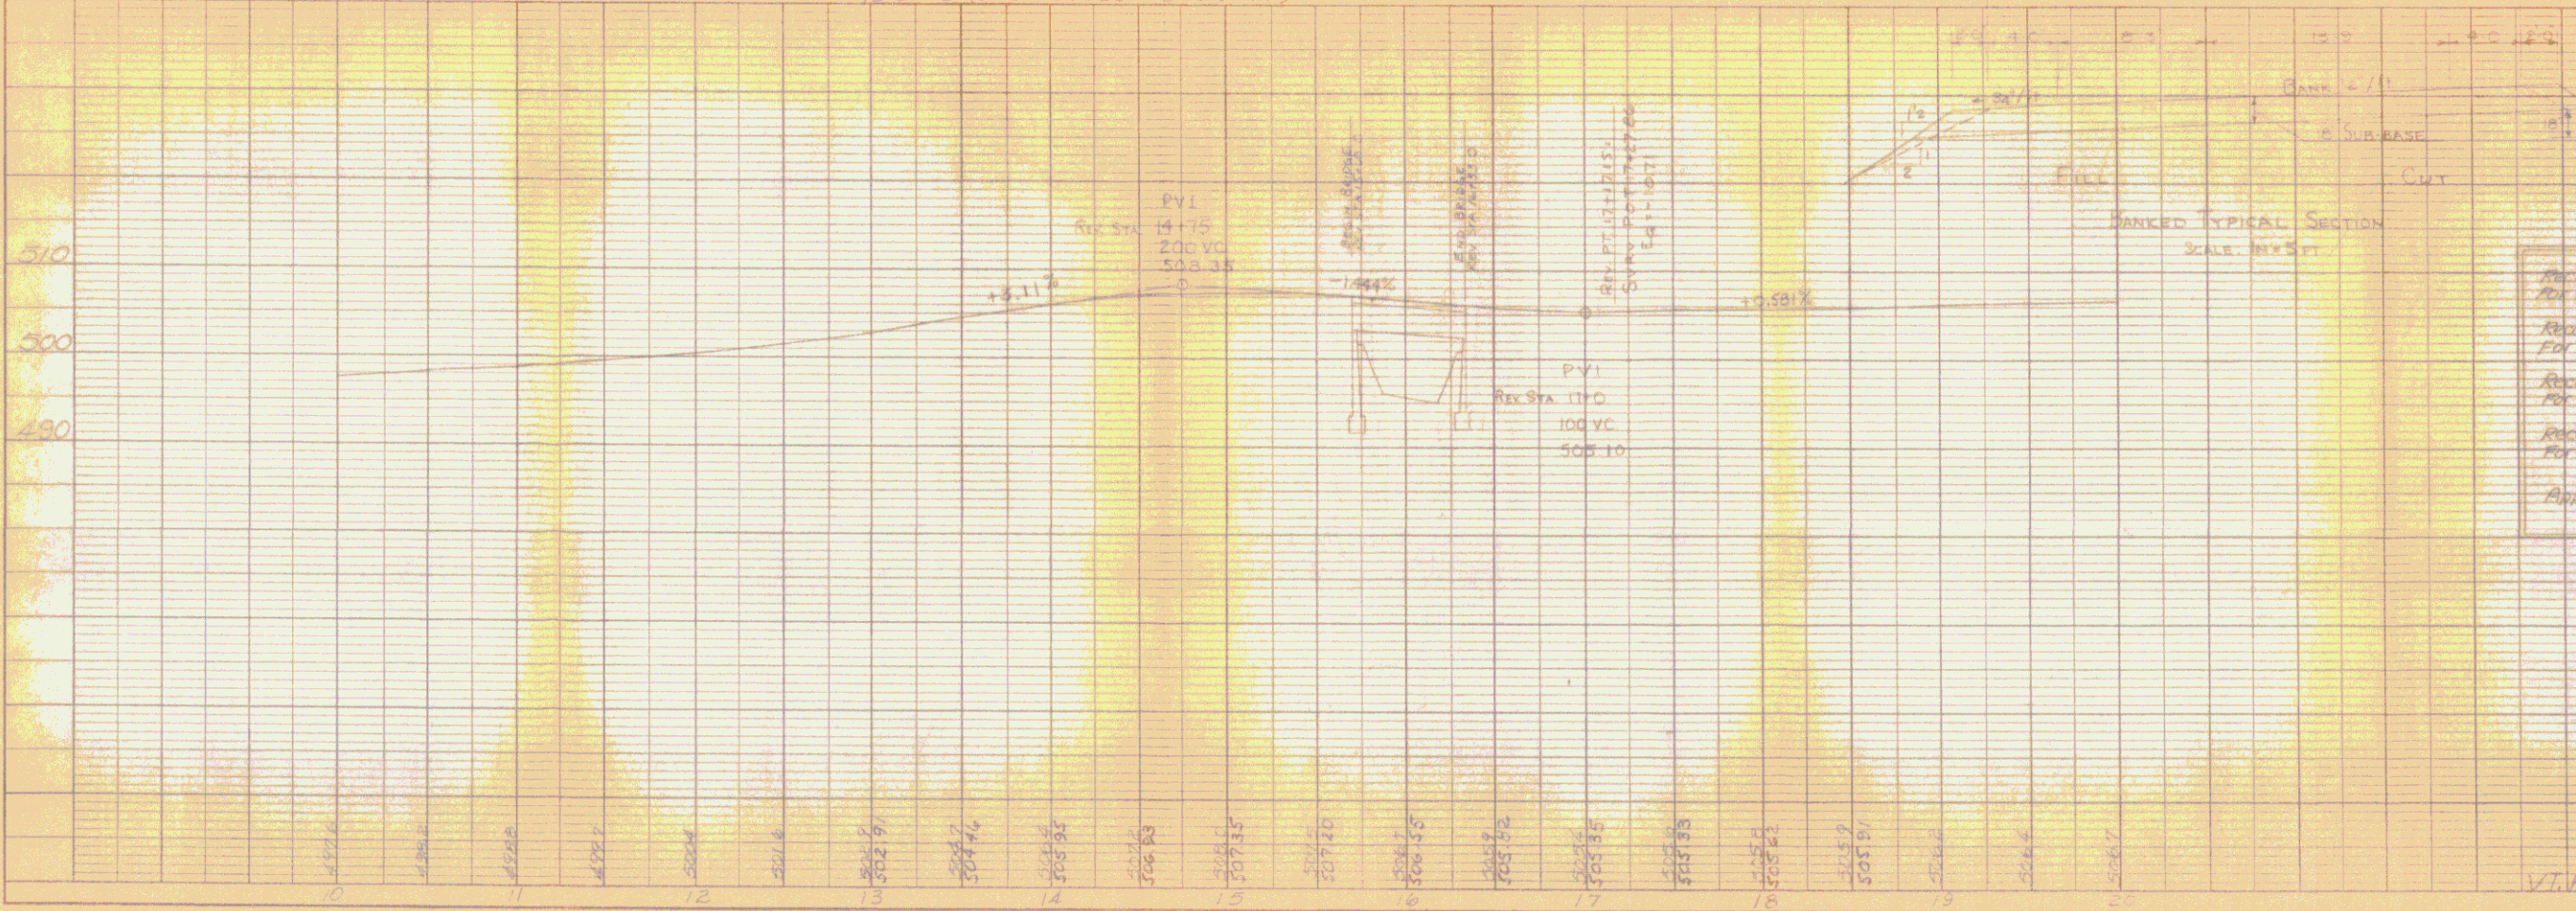

Recommended by *[Signature]*
 For Approval *[Signature]* 7/25/69
 Recommended by *[Signature]*
 For Approval *[Signature]* 7/25/69
 Recommended by *[Signature]*
 For Approval *[Signature]* 7/25/69
 Approved by *[Signature]*
 Chief Engineer

7/25/69
 Eng 6811
 GARY WILLET
 VT Rte 100-DC-133
 BMA-6811-6220