


INDEX OF SHEETS

SHEET NO.	
1	TITLE PAGE
2	TYPICAL CROSS-SECTION OF IMPROVEMENT (DOUBLE TACK COAT OF REFINED TAR WITH PEASTONE SEAL)
3	BANKING AND WIDENING TABLES BW-1
4	QUANTITY SHEET (ITEMS)
5-6	QUANTITY SHEET (DRAINAGE)
7-16	EARTHWORK SHEETS
17-29	PLAN AND PROFILE SHEETS
40	DETAILS OF SUPERSTRUCTURE WIDENING-BRIDGE NO.1
41	DETAILS OF ABUTMENT NO.1 - BRIDGE NO.1
42	DETAILS OF ABUTMENT NO.2 - BRIDGE NO.1
43	DETAILS OF SUPERSTRUCTURE WIDENING-BRIDGE NO.2
44	DETAILS OF ABUTMENT NO.1 - BRIDGE NO.2
45	DETAILS OF ABUTMENT NO.2 - BRIDGE NO.2
46-47	DETAILS OF SUPERSTRUCTURE WIDENING-BRIDGE NO.3
48	DETAILS OF ABUTMENT NO.1 - BRIDGE NO.3
49	DETAILS OF ABUTMENT NO.2 - BRIDGE NO.3
50	DETAILS OF SUPERSTRUCTURE WIDENING-BRIDGE NO.4
51	DETAILS OF ABUTMENT NO.1 - BRIDGE NO.4
52	DETAILS OF ABUTMENT NO.2 - BRIDGE NO.4
53	DETAILS OF SUPERSTRUCTURE WIDENING-BRIDGE NO.5
54	DETAILS OF ABUTMENT NO.1 - BRIDGE NO.5
55	DETAILS OF ABUTMENT NO.2 - BRIDGE NO.5
56	DETAILS OF SUPERSTRUCTURE WIDENING-BRIDGE NO.6
57	DETAILS OF ABUTMENT NO.1 - BRIDGE NO.6
58	DETAILS OF ABUTMENT NO.2 - BRIDGE NO.6
59	DETAILS OF 9'-9" X 6'-7" C.G.M.P.R. ARCH AT STA. 190+50
60	DETAILS OF 7'-8" X 5'-5" C.G.M.P.R. ARCH AT STA. 282+50
61	DETAILS OF 10'-3" X 6'-9" C.G.M.P.R. ARCH AT STA. 300+90
62-63	REINFORCING STEEL DETAILS
64	STANDARD DRAWING 58-20-56
65	STANDARD DRAWING 55-56-2 (BARRICADES, SIGNS & LIGHTS FOR BRIDGES)
66	ROADWAY STANDARD SHEET RS 56-3 (MARKERS)
67	ROADWAY STANDARD SHEET RS 56-4 (DRAINAGE)
68	ROADWAY STANDARD SHEET RS 56-6 (SLOPE GRADING)
69	ROADWAY STANDARD SHEET RS 56-9 (DRILLING & BLASTING OF SOLID ROCK SUBGRADE)
70	ROADWAY STANDARD SHEET RS 56-11 (THREE CABLE GUARD RAIL)
71	ROADWAY STANDARD SHEET RS 56-12 (BARRICADES, SIGNS & LIGHTS FOR ROADWAY)
72	ROADWAY STANDARD SHEET RS 56-14 (PRECAST R.C.P. DROP INLET)
73-105	CROSS SECTIONS
186-202	CHANNEL SECTIONS

STATE OF VERMONT
DEPARTMENT OF HIGHWAYS
PROPOSED IMPROVEMENT
TOWN OF GRANVILLE
COUNTY OF ADDISON
VERMONT ROUTE 100
WARREN-HANCOCK ROAD

BEGINNING AT A POINT APPROXIMATELY 30 MILES NORTHERLY FROM THE GRANVILLE-HANCOCK TOWN LINE AND EXTENDING 35,524.9 FEET NORTHERLY ALONG STATE HIGHWAY 100 TO THE GRANVILLE-WARREN TOWN LINE.
LENGTH OF BRIDGES 143.17 FEET + 0.02"
LENGTH OF ROADWAY 35,381.7 FEET + 6.701 MILES
LENGTH OF PROJECT 35,524.9 FT. = 6.728 MILES

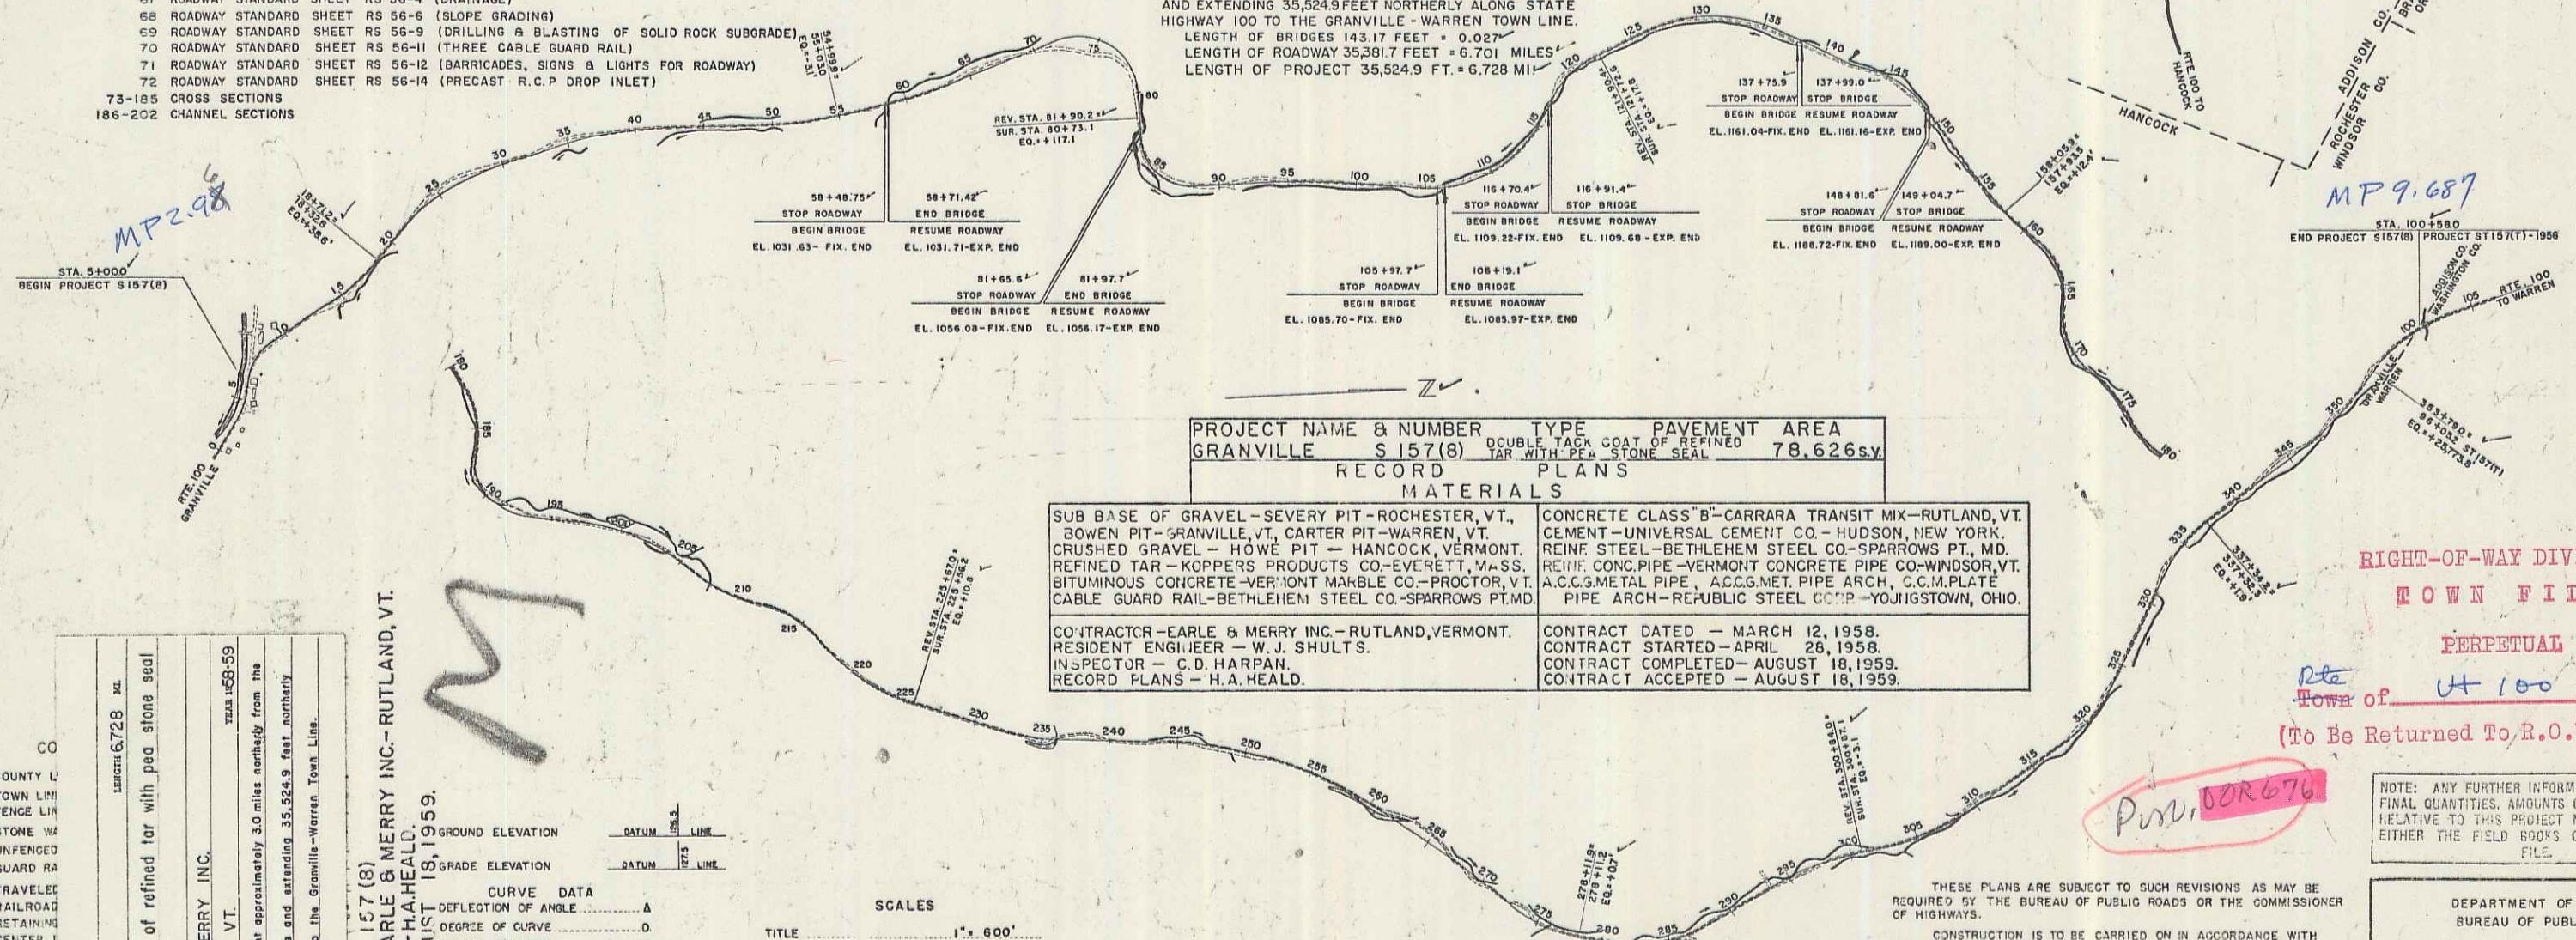

PROJECT NAME & NUMBER	TYPE	PAVEMENT AREA
GRANVILLE S 157(8)	DOUBLE TACK COAT OF REFINED TAR WITH PEASTONE SEAL	78,626 sq. yd.

SUB BASE OF GRAVEL - SEVERY PIT - ROCHESTER, VT.		CONCRETE CLASS "B" - CARRARA TRANSIT MIX - RUTLAND, VT.
SOWEN PIT - GRANVILLE, VT. CARTER PIT - WARREN, VT.		CEMENT - UNIVERSAL CEMENT CO. - HUDSON, NEW YORK.
CRUSHED GRAVEL - HOWE PIT - HANCOCK, VERMONT.		REIN. STEEL - BETHLEHEM STEEL CO. - SPARROWS PT., MD.
REFINED TAR - KOPPERS PRODUCTS CO. - EVERETT, MASS.		REIN. CONC. PIPE - VERMONT CONCRETE PIPE CO. - WINDSOR, VT.
BITUMINOUS CONCRETE - VERMONT MARBLE CO. - PROCTOR, VT.		A.C.C. METAL PIPE, A.C.C. MET. PIPE ARCH, C.C.M. PLATE
CABLE GUARD RAIL - BETHLEHEM STEEL CO. - SPARROWS PT., MD.		PIPE ARCH - REPUBLIC STEEL CORP. - YOUNGSTOWN, OHIO.

CONTRACTOR - EARLE & MERRY INC. - RUTLAND, VERMONT.
RESIDENT ENGINEER - W. J. SHULTS.
INSPECTOR - C. D. HARPAN.
RECORD PLANS - H. A. HEALD.


CONTRACT DATED - MARCH 12, 1958.
CONTRACT STARTED - APRIL 26, 1958.
CONTRACT COMPLETED - AUGUST 18, 1959.
CONTRACT ACCEPTED - AUGUST 18, 1959.

TOWN	GRANVILLE
COUNTY	ADDISON
ROUTE	100
PROJECT NO.	S 157(8)
DATE	2/14/58
CONTRACTOR	EARLE & MERRY INC., RUTLAND, VT.
RESIDENT ENGINEER	W. J. SHULTS
INSPECTOR	C. D. HARPAN
RECORD ENGINEER	H. A. HEALD

CONTRACTOR - EARLE & MERRY INC. - RUTLAND, VT.
RECORD PLANS - H. A. HEALD
COMPLETED AUGUST 19, 1959.

CURVE DATA	
DEFLECTION OF ANGLE	Δ
DEGREE OF CURVE	D
RADIUS OF CURVE	R
TANGENT DISTANCE	T
LENGTH OF CURVE	L
EXTERNAL DISTANCE	E
POINT OF INTERSECTION	P.I.
POINT OF CURVE	P.C.
POINT OF TANGENT	P.T.
POINT ON TANGENT	P.O.T.
POINT ON SUB-TANGENT	P.O.S.T.

SCALES	
TITLE	1" = 600'
TYPICAL	1" = 200'
PLAN	1" = 50'
PROFILE HORIZONTAL	1" = 50'
PROFILE VERTICAL	1" = 10'
CROSS-SECTIONS	1" = 5'

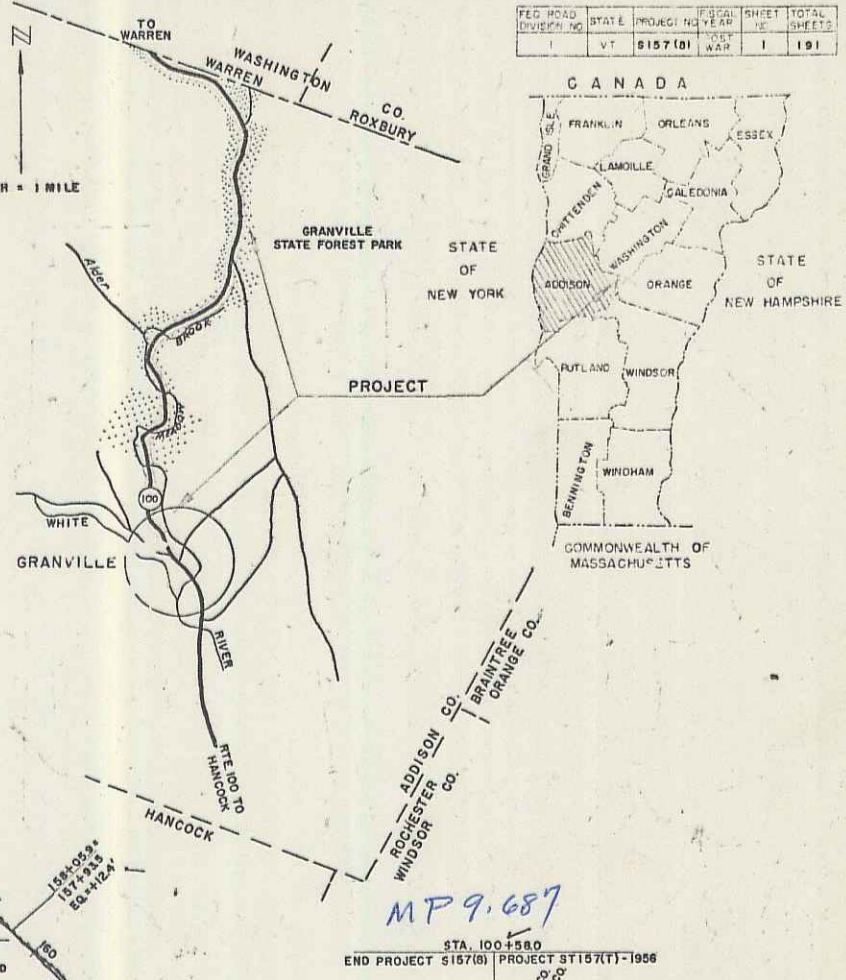

RIGHT-OF-WAY DIVISION
TOWN FILE
PERPETUAL
Town of Ut 100
(To Be Returned To R.O.W. Division)

NOTE: ANY FURTHER INFORMATION CONCERNING FINAL QUANTITIES, AMOUNTS OR OTHER DETAILS RELATIVE TO THIS PROJECT MAY BE FOUND IN EITHER THE FIELD BOOKS OR THE ESTIMATE FILE.

DEPARTMENT OF HIGHWAYS
BUREAU OF PUBLIC ROADS
APPROVED
DISTRICT ENGINEER DATE

APPROVED RECORDING ENGINEER DATE 2/13/58	APPROVED DISTRICT ENGINEER DATE 2/14/58	APPROVED BRIDGE ENGINEER DATE 2/11/58	APPROVED DISTRICT ENGINEER DATE 2/14/58	APPROVED HIGHWAY ENGINEER DATE 2/14/58	APPROVED DISTRICT ENGINEER DATE 2/14/58	PROJECT S NO. 157(8) SHEET 1 OF 191 SHEETS WEBSTER-MARTIN INC. CONSULTING ENGINEERS SOUTH BURLINGTON, VERMONT.
--	---	---	---	--	---	---