
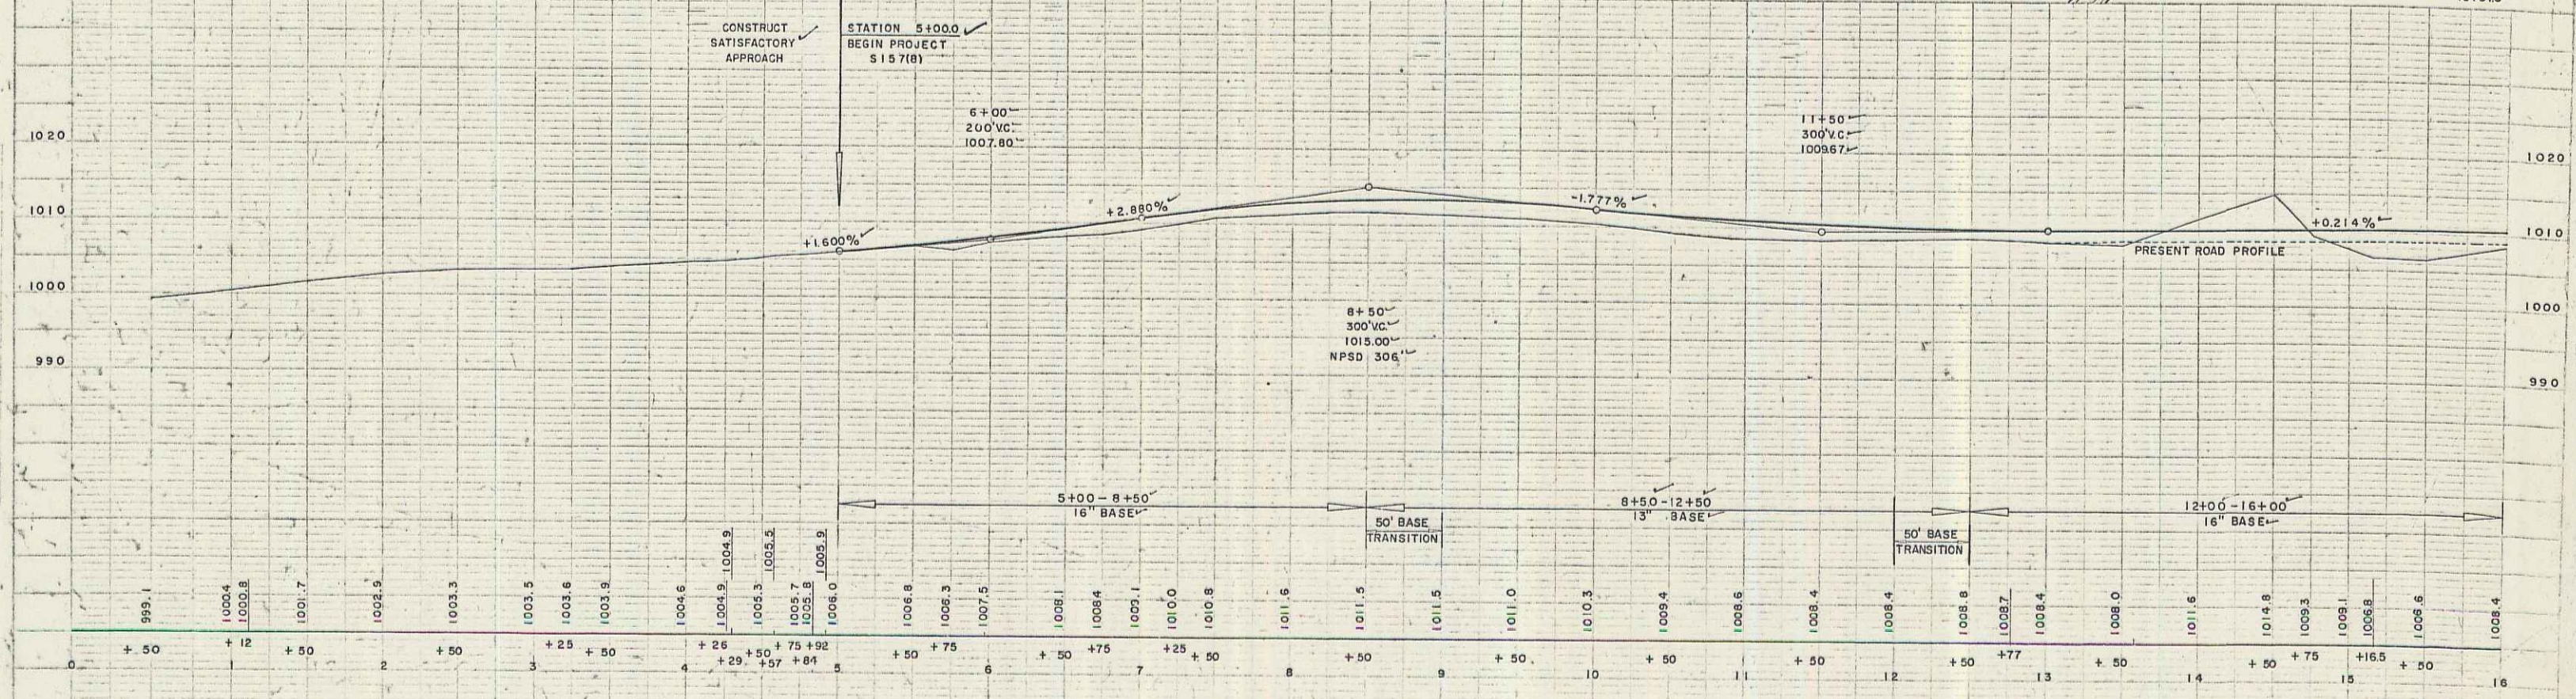


TWO CABLE GUARD RAIL
LT 4485 6473
RT

CONSTRUCT DRIVES		THREE CABLE GUARD RAIL (WASTE POST)	
14+50	RT	14+50	RT
616	LT	11+00	LT
11+00	LT		

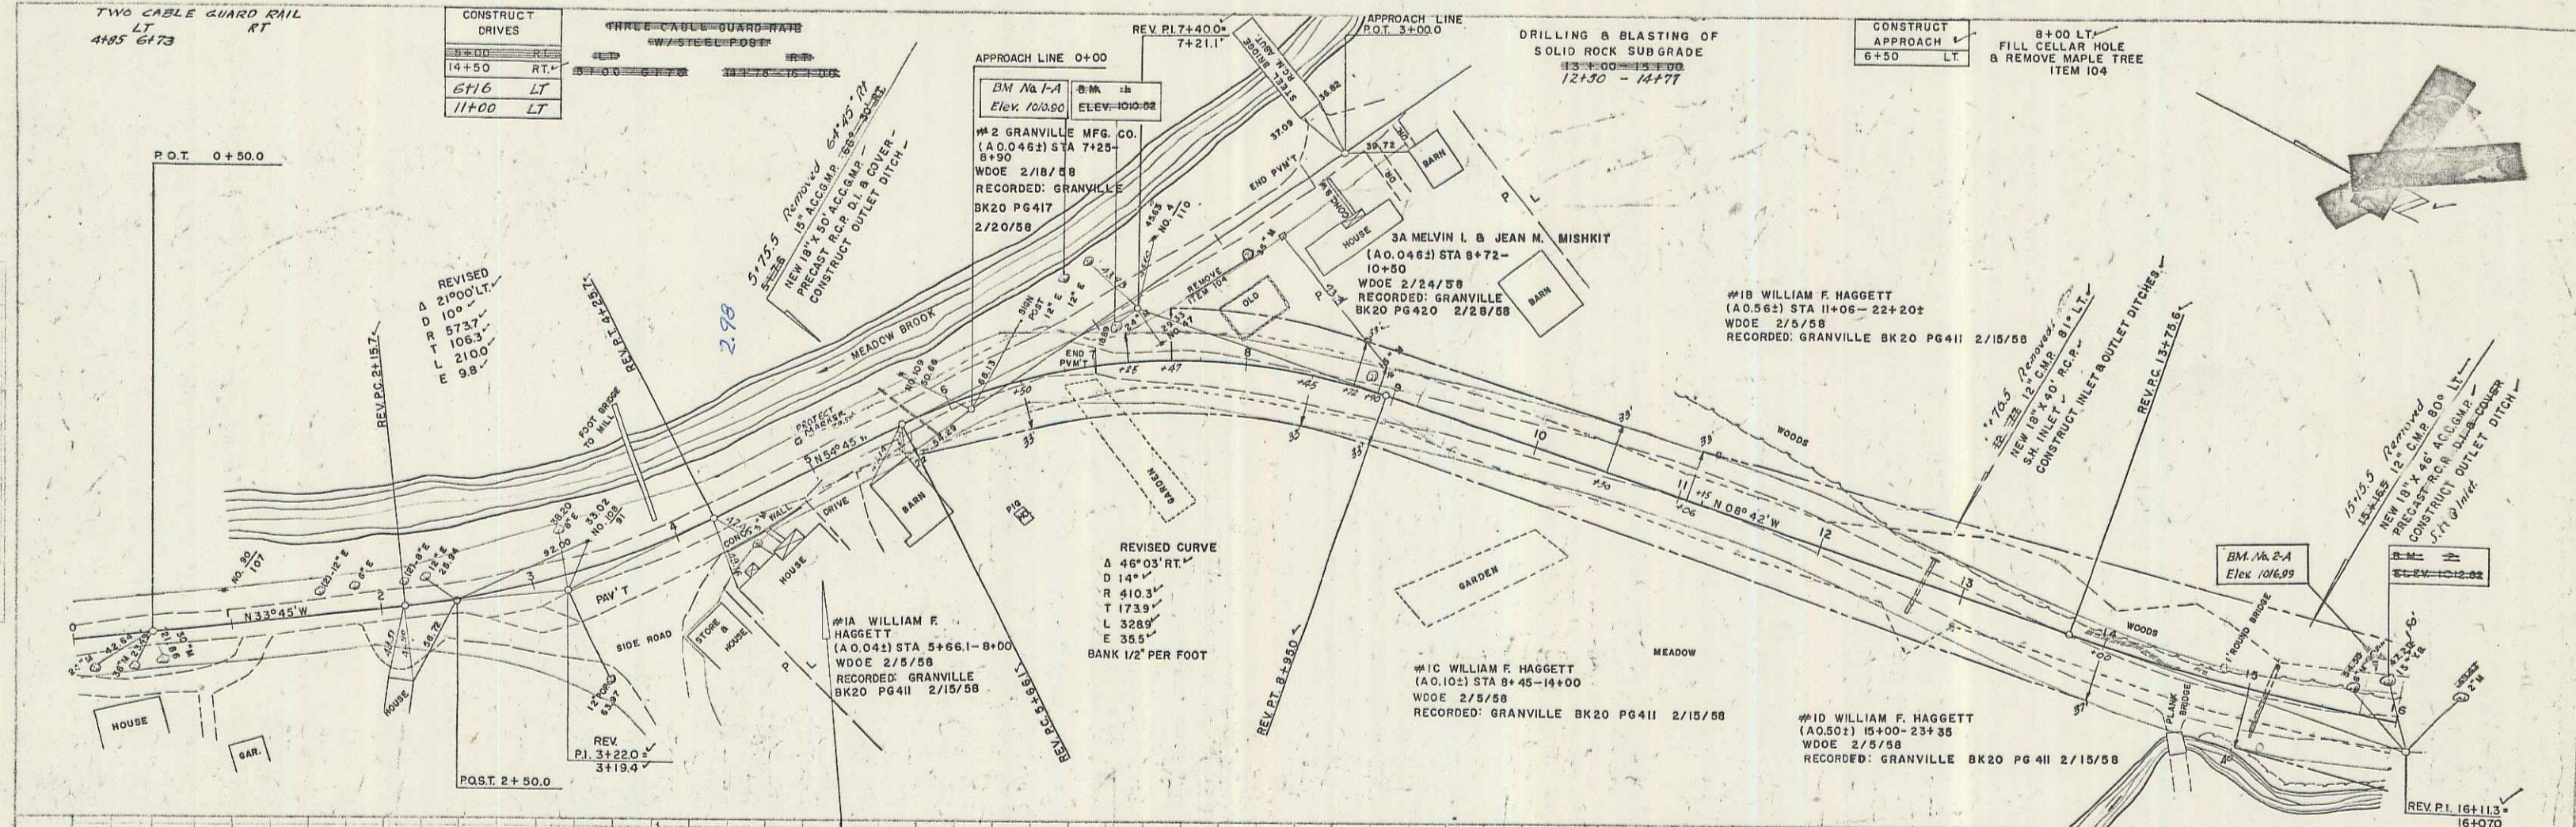

BM 1-A SLT 12' Elm. 55' Lt. Sta. 6+90 Elev. 1010.80
BM 1-B SLT 24' MAPLE 34' Lt. Sta. 7+17 Elev. 1010.58

BM 2-A SLT 6' Spr. 40' Lt. Sta. 15+75 Elev. 1016.39
BM 2-B SLT 14' BIRCH 56' Lt. Sta. 15+30 Elev. 1012.39

GRANVILLE S 157 (B)
SHEET 17 OF 202

9-58
PALMER
WEBSTER-MARTIN INC. 11-58
SCALE: 1" = 40'

9-58
PALMER
WEBSTER-MARTIN INC. 11-58

2