



PALMER 8-56  
 WEBSTER-MARTIN INC. 11-56  
 PROJECT NO. 100-100-100  
 SHEET NO. 21 OF 202

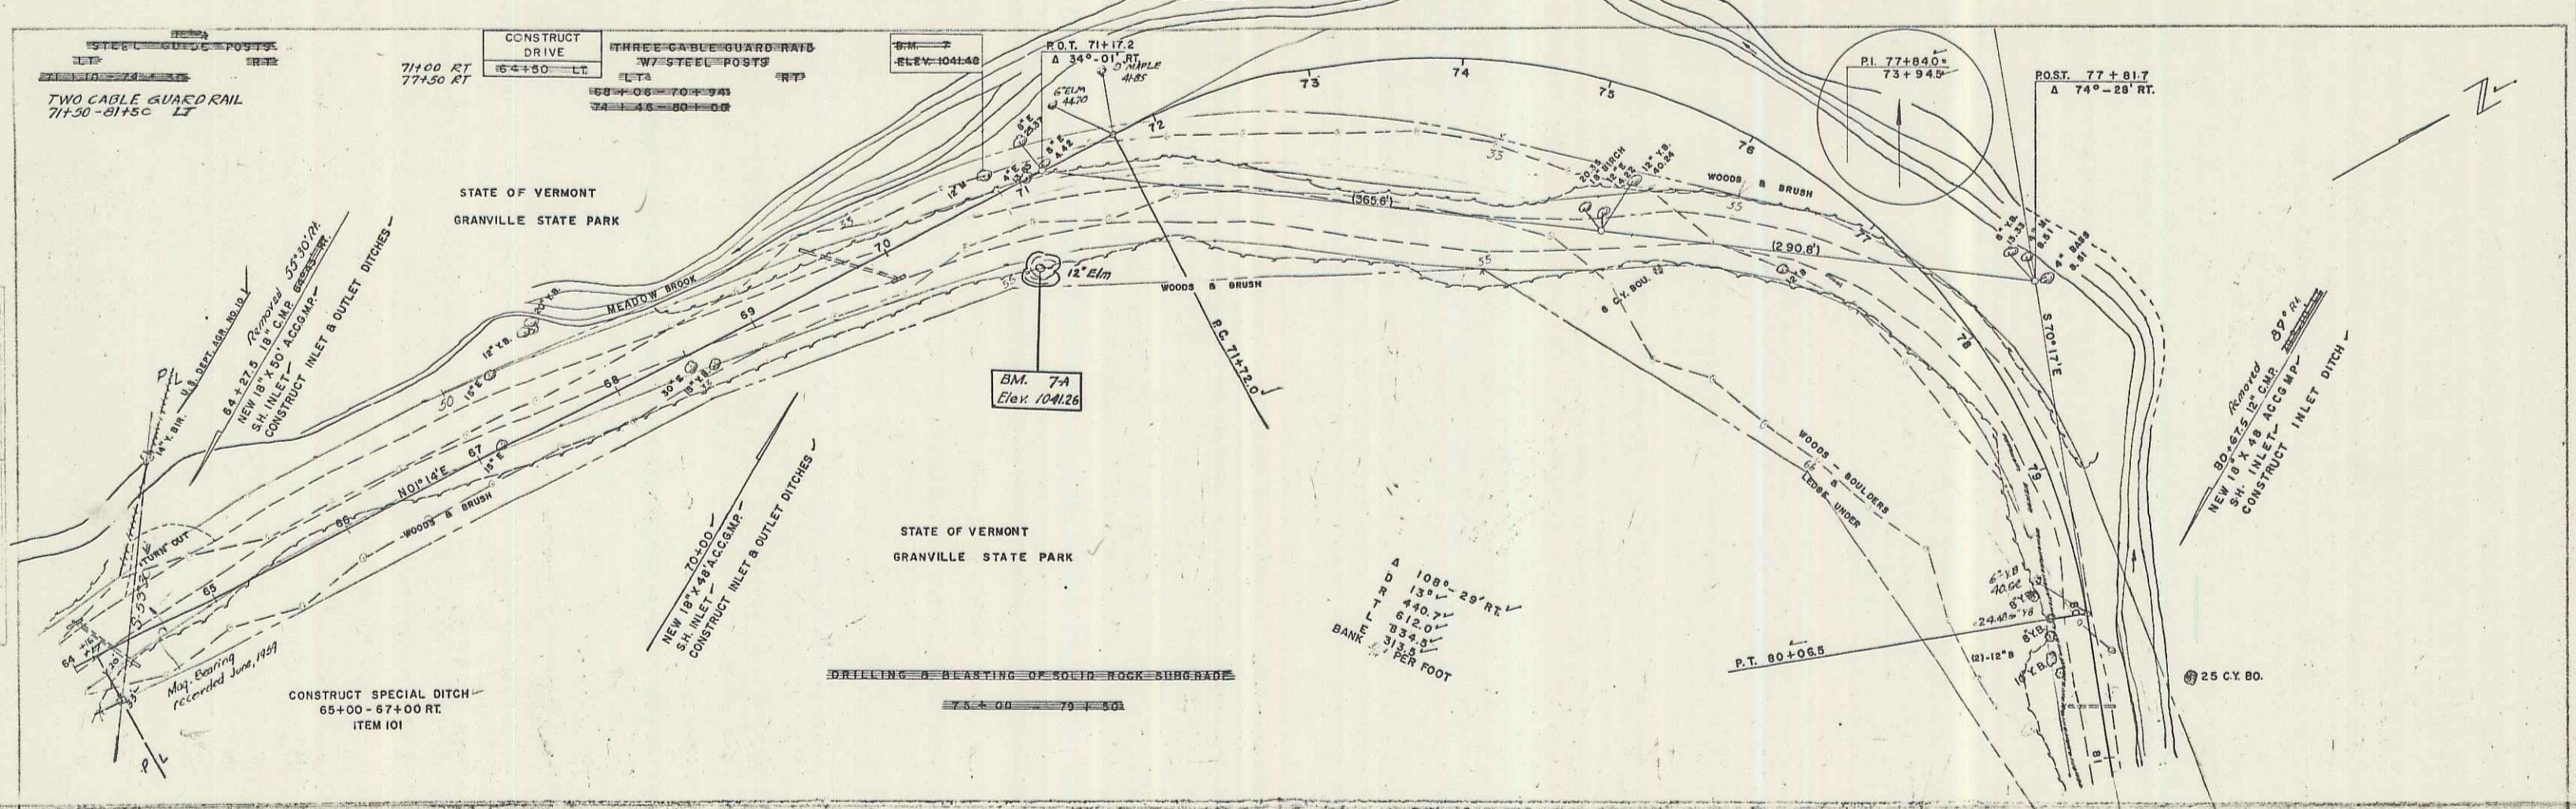

PALMER 8-56  
 WEBSTER-MARTIN INC. 11-56  
 PROJECT NO. 100-100-100  
 SHEET NO. 21 OF 202

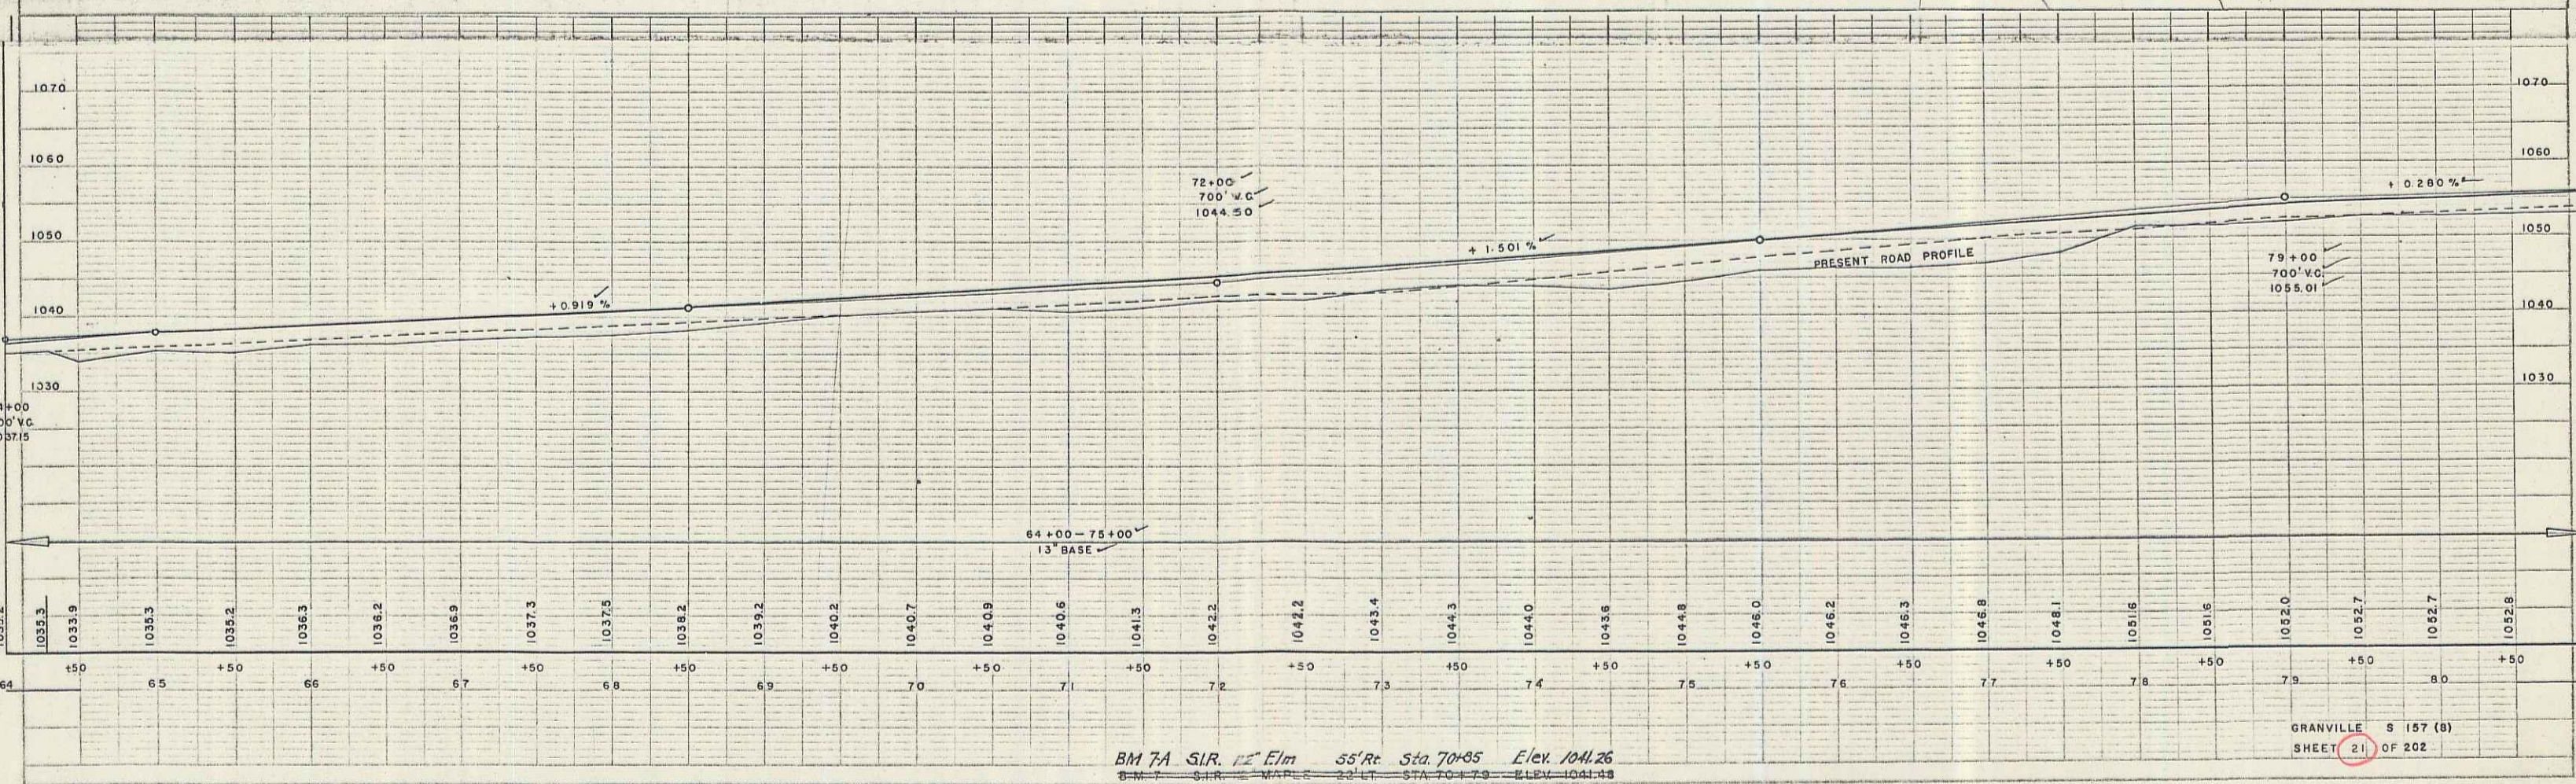

B.M. 7A S.I.R. 12' Elm 55' Rt. Sta. 70+65 Elev. 1041.26  
 8-56 11-56  
 GRANVILLE S 157 (B)  
 SHEET 21 OF 202