
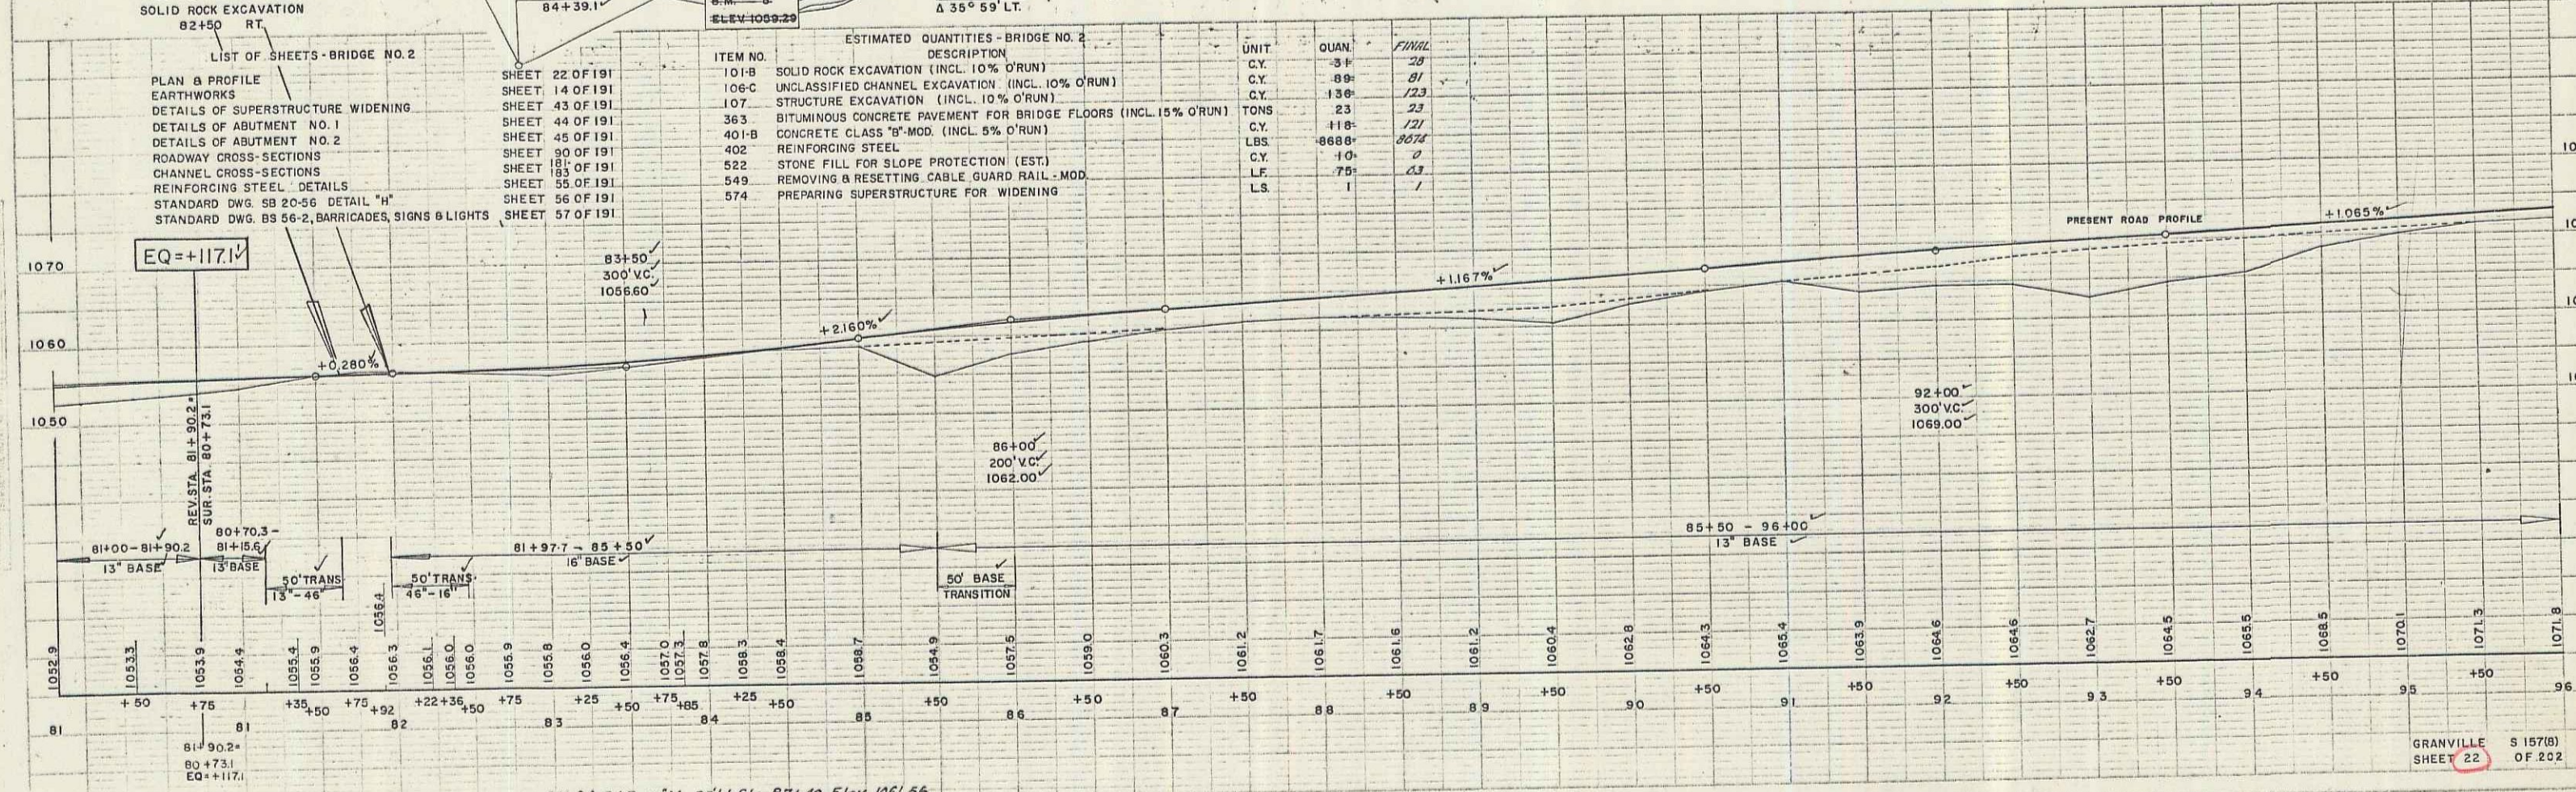


REV. STA. 81+90.2
 SUR. STA. 80+73.1
 E.O. = +117.1 FT.

REV. STA. 81+90.2
 SUR. STA. 80+73.1
 E.O. = +117.1 FT.

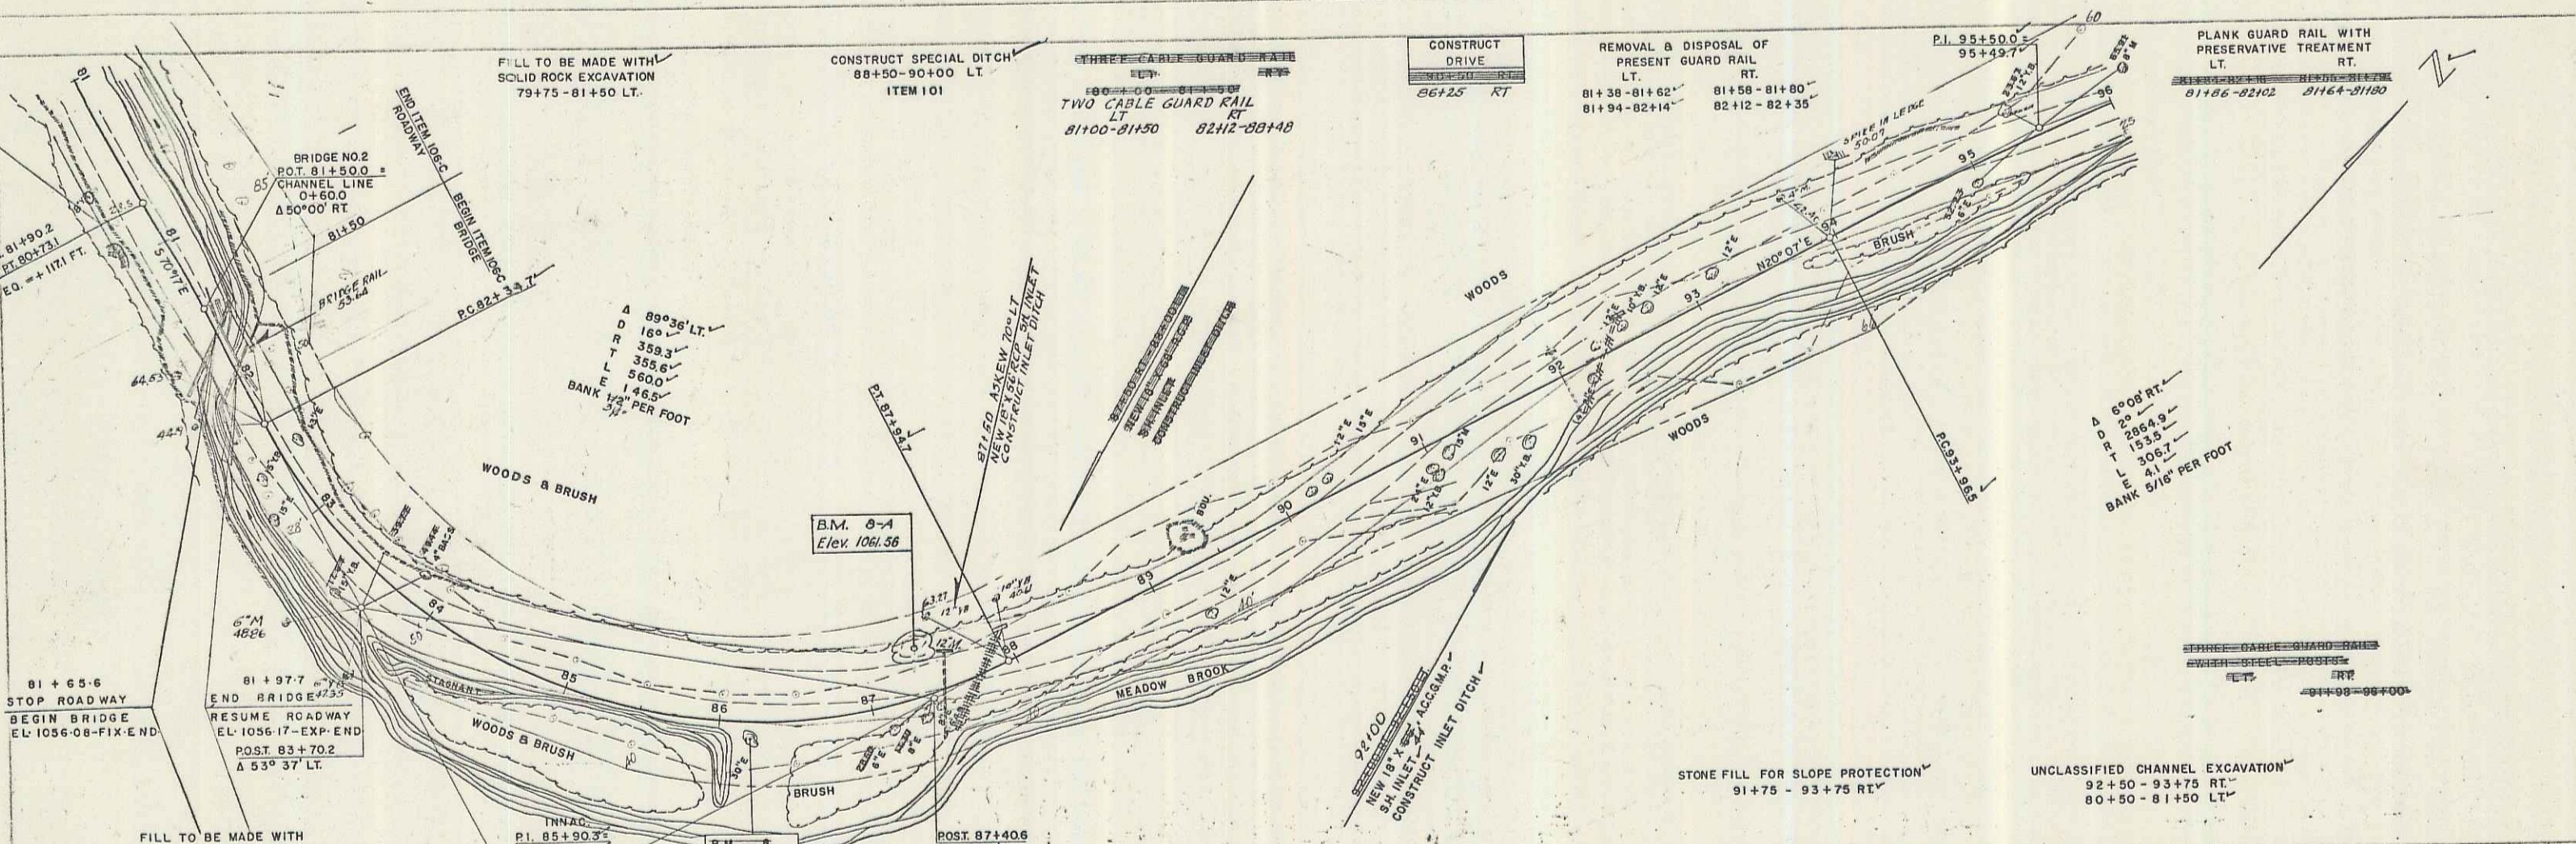

LIST OF SHEETS - BRIDGE NO. 2

PLAN & PROFILE	SHEET 22 OF 191
EARTHWORKS	SHEET 14 OF 191
DETAILS OF SUPERSTRUCTURE WIDENING	SHEET 43 OF 191
DETAILS OF ABUTMENT NO. 1	SHEET 44 OF 191
DETAILS OF ABUTMENT NO. 2	SHEET 45 OF 191
ROADWAY CROSS-SECTIONS	SHEET 90 OF 191
CHANNEL CROSS-SECTIONS	SHEET 181 OF 191
REINFORCING STEEL DETAILS	SHEET 55 OF 191
STANDARD DWG. 88 20-56 DETAIL "H"	SHEET 56 OF 191
STANDARD DWG. 88 56-2, BARRICADES, SIGNS & LIGHTS	SHEET 57 OF 191

ESTIMATED QUANTITIES - BRIDGE NO. 2

ITEM NO.	DESCRIPTION	UNIT	QUAN.	FINAL
101-B	SOLID ROCK EXCAVATION (INCL. 10% O'RUN)	CY	84	81
106-C	UNCLASSIFIED CHANNEL EXCAVATION (INCL. 10% O'RUN)	CY	130	123
107	STRUCTURE EXCAVATION (INCL. 10% O'RUN)	TONS	23	23
363	BITUMINOUS CONCRETE PAVEMENT FOR BRIDGE FLOORS (INCL. 15% O'RUN)	CY	118	121
401-B	CONCRETE CLASS "B" MOD. (INCL. 5% O'RUN)	LBS	8688	8624
402	REINFORCING STEEL	CY	10	0
522	STONE FILL FOR SLOPE PROTECTION (EST)	LF	75	0
549	REMOVING & RESETTING CABLE GUARD RAIL - MOD.	LS	1	1
574	PREPARING SUPERSTRUCTURE FOR WIDENING			

B.M. 0A S.I.R. 12" M. 35' Lt. Sta. 87+40 Elev. 1061.56
 B.M. 0-2 S.I.R. 30" ELM. 11' ST. STA. 86+20 Elev. 1009.29