
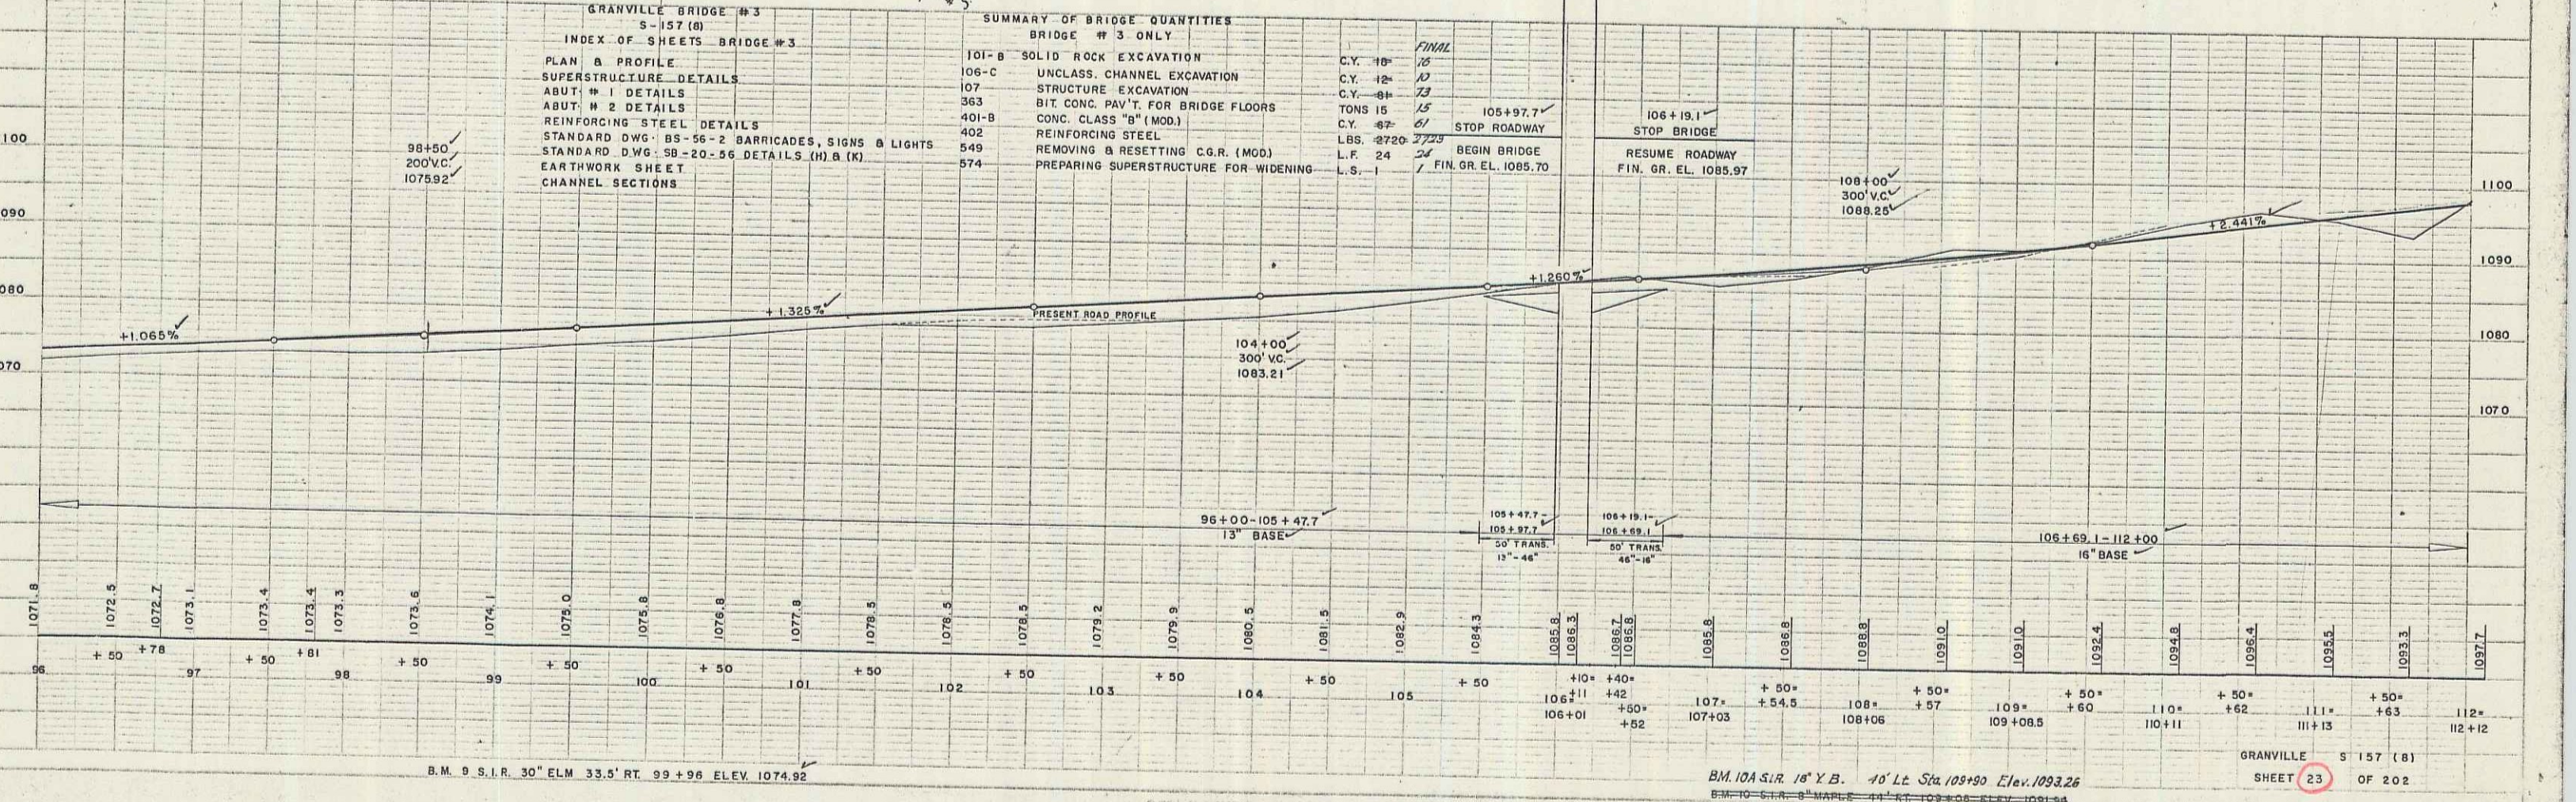


PLAN
WEBSTER-MARTIN INC. 11-56

PLAN
WEBSTER-MARTIN INC. 11-56

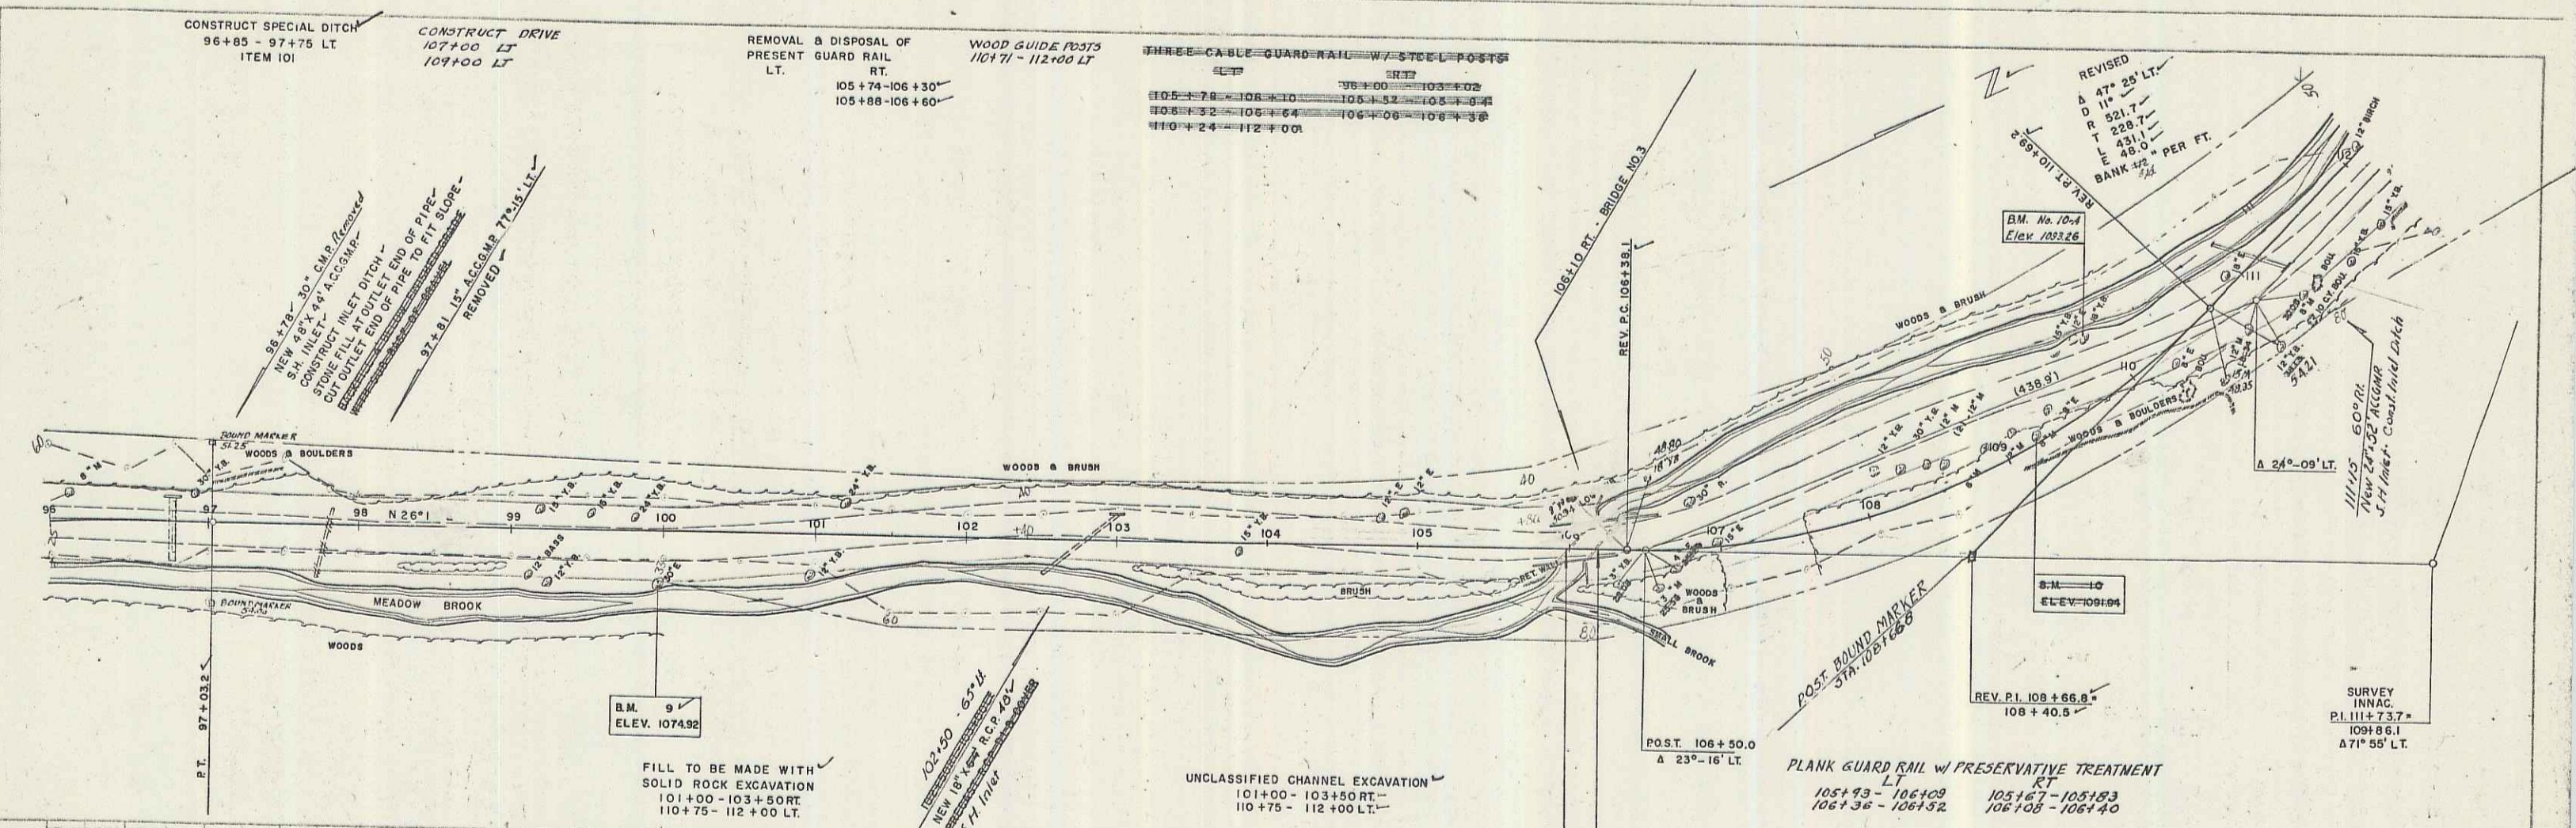

GRANVILLE BRIDGE #3
S-157 (B)

INDEX OF SHEETS BRIDGE #3

PLAN & PROFILE
SUPERSTRUCTURE DETAILS
ABUT # 1 DETAILS
ABUT # 2 DETAILS
REINFORCING STEEL DETAILS
STANDARD DWG. BS-56-2 BARRICADES, SIGNS & LIGHTS
STANDARD DWG. SB-20-56 DETAILS (H) & (K)
EARTHWORK SHEET
CHANNEL SECTIONS

SUMMARY OF BRIDGE QUANTITIES
BRIDGE # 3 ONLY

ITEM	DESCRIPTION	FINAL
101-B	SOLID ROCK EXCAVATION	C.Y. 10' 15'
106-C	UNCLASS. CHANNEL EXCAVATION	C.Y. 18' 40'
107	STRUCTURE EXCAVATION	C.Y. 88' 73'
363	BIT. CONC. PAV'T. FOR BRIDGE FLOORS	TONS 15' 15'
401-B	CONC. CLASS "B" (MOD.)	C.Y. 67' 61'
402	REINFORCING STEEL	LBS. 8720' 723'
549	REMOVING & RESETTING C.G.R. (MOD.)	L.F. 24' 24'
574	PREPARING SUPERSTRUCTURE FOR WIDENING	L.S. 1' 1'

B.M. 9 S.I.R. 30' ELM 33.5' RT. 99+96 ELEV. 1074.92

B.M. 10A S.I.R. 15' Y.B. 15' Lt. Sta. 109+90 Elev. 1093.26

GRANVILLE S 157 (B)
SHEET 23 OF 202

8