
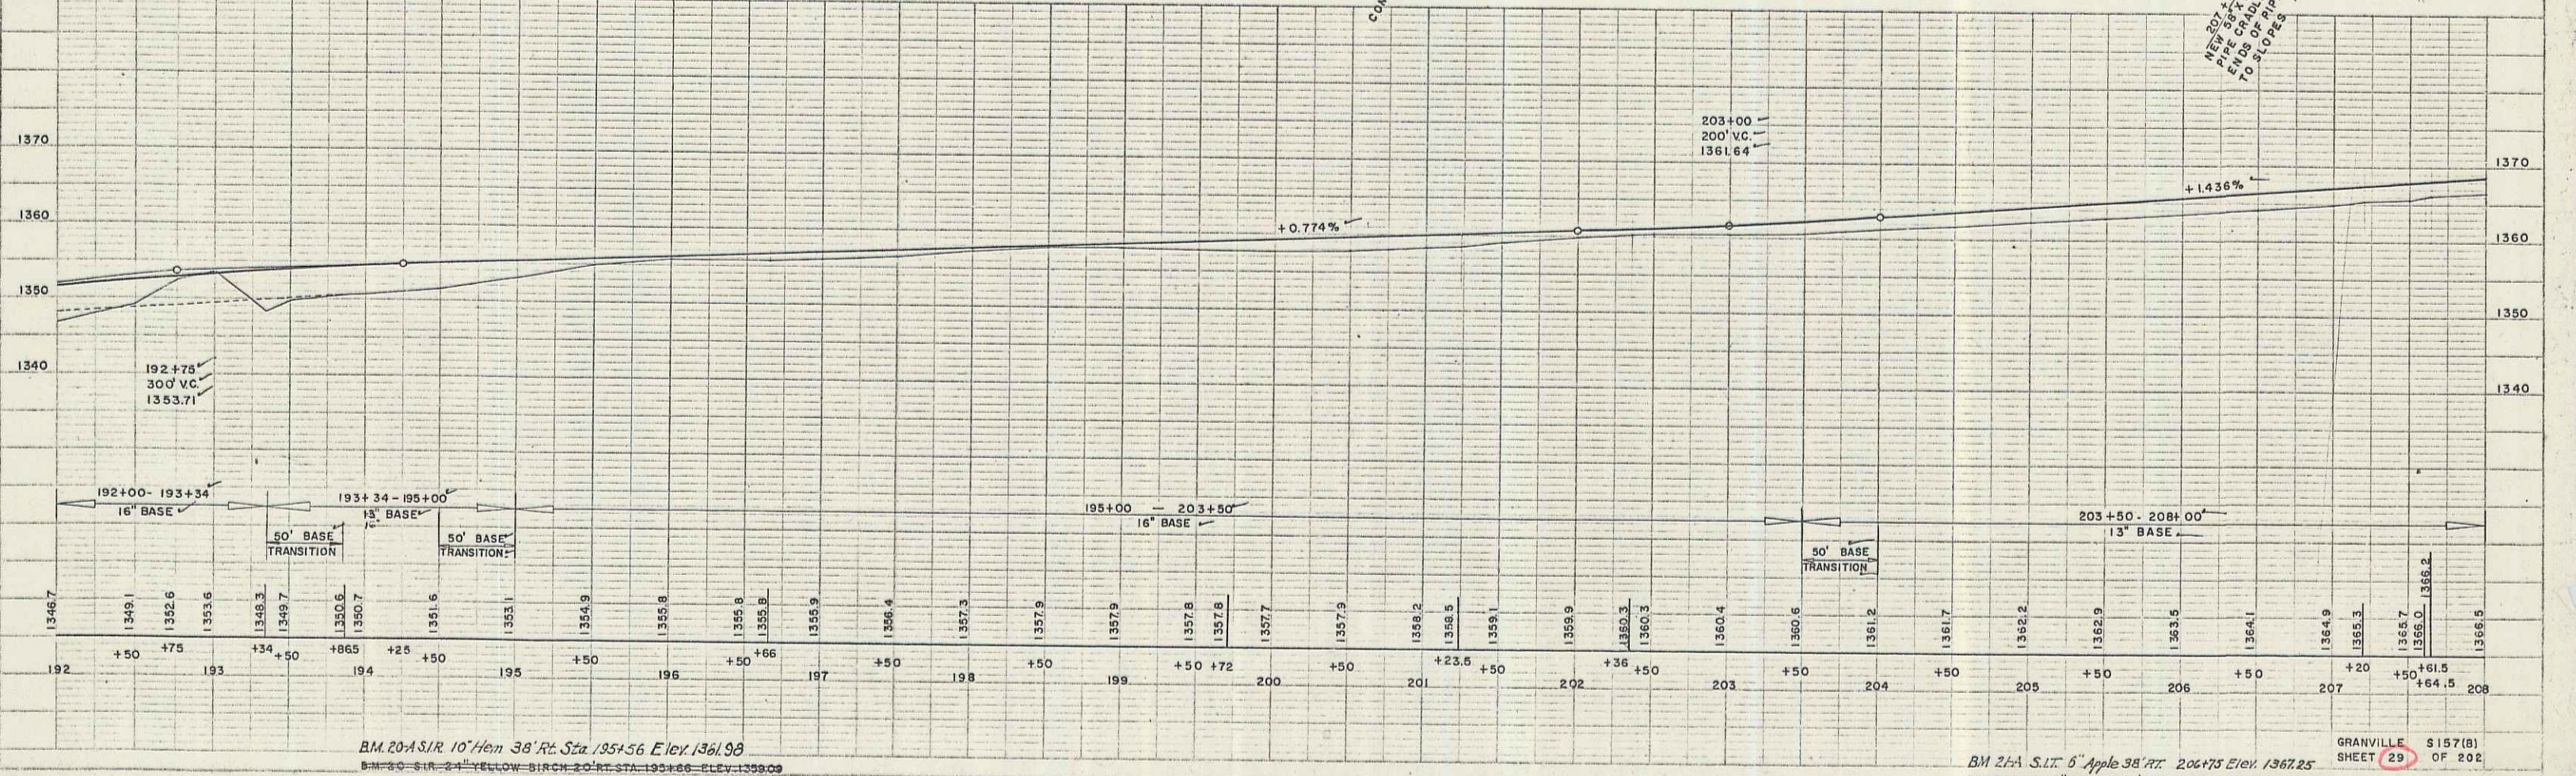


PLAN  
 WESTER, MARTIN INC. 11-56  
 100 LINDSEY ST. W. WINDSOR, ONT. L9S 4K1  
 TEL. 533-1111

PROFILE  
 PALMER, FARMER & WESTER, MARTIN INC. 11-56  
 100 LINDSEY ST. W. WINDSOR, ONT. L9S 4K1  
 TEL. 533-1111

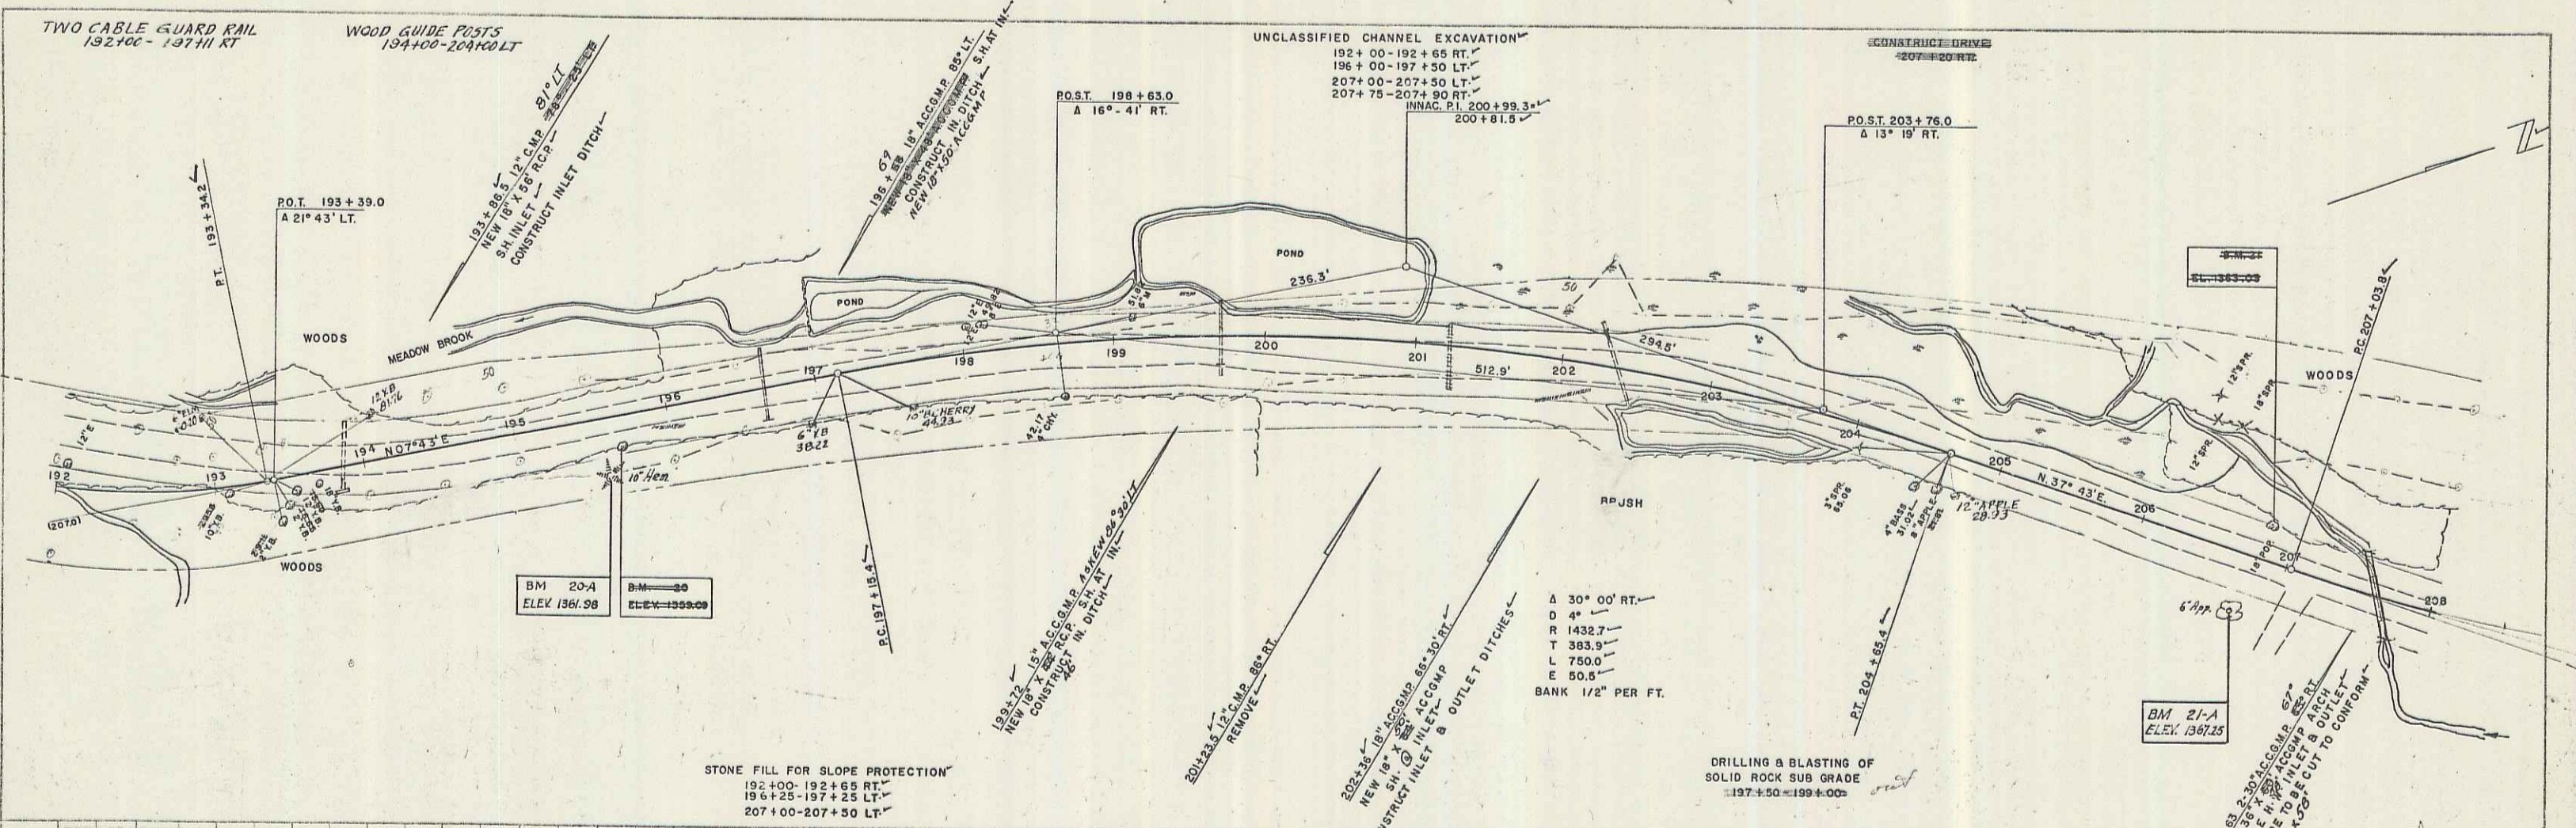

BM 20-A SIR 10' Hem 38' Rt Sta 195+56 Elev 1361.98  
 BM 20-B SIR 2" Yellow Birch 20' Rt Sta 195+66 Elev 1359.09

BM 21-A SIR 6' Apple 38' Rt Sta 206+75 Elev 1367.25  
 GRANVILLE \$157(B) SHEET 29 OF 202