

PLAN
 PALMER
 WEBSTER-MARTIN, INC.
 11-56
 15' X 30'

PROFILE
 PALMER
 WEBSTER-MARTIN, INC.
 11-56
 15' X 30'

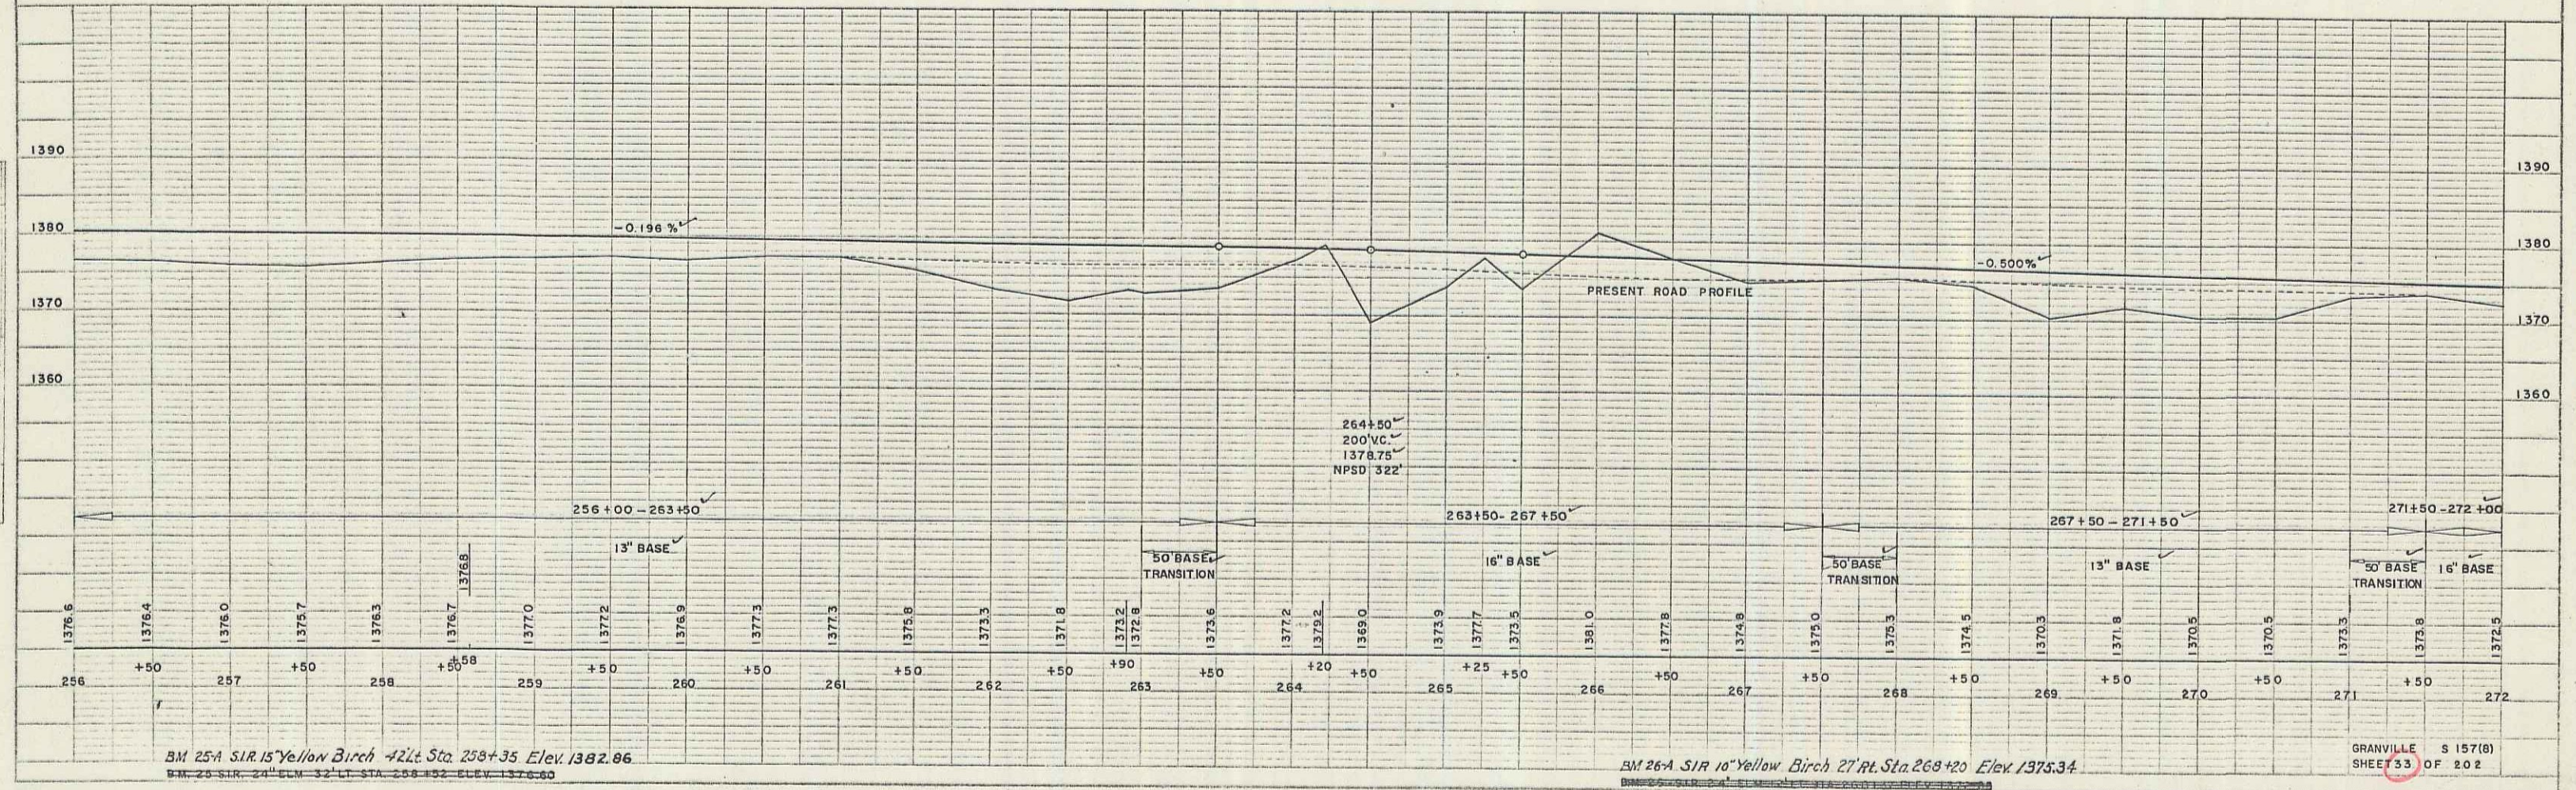
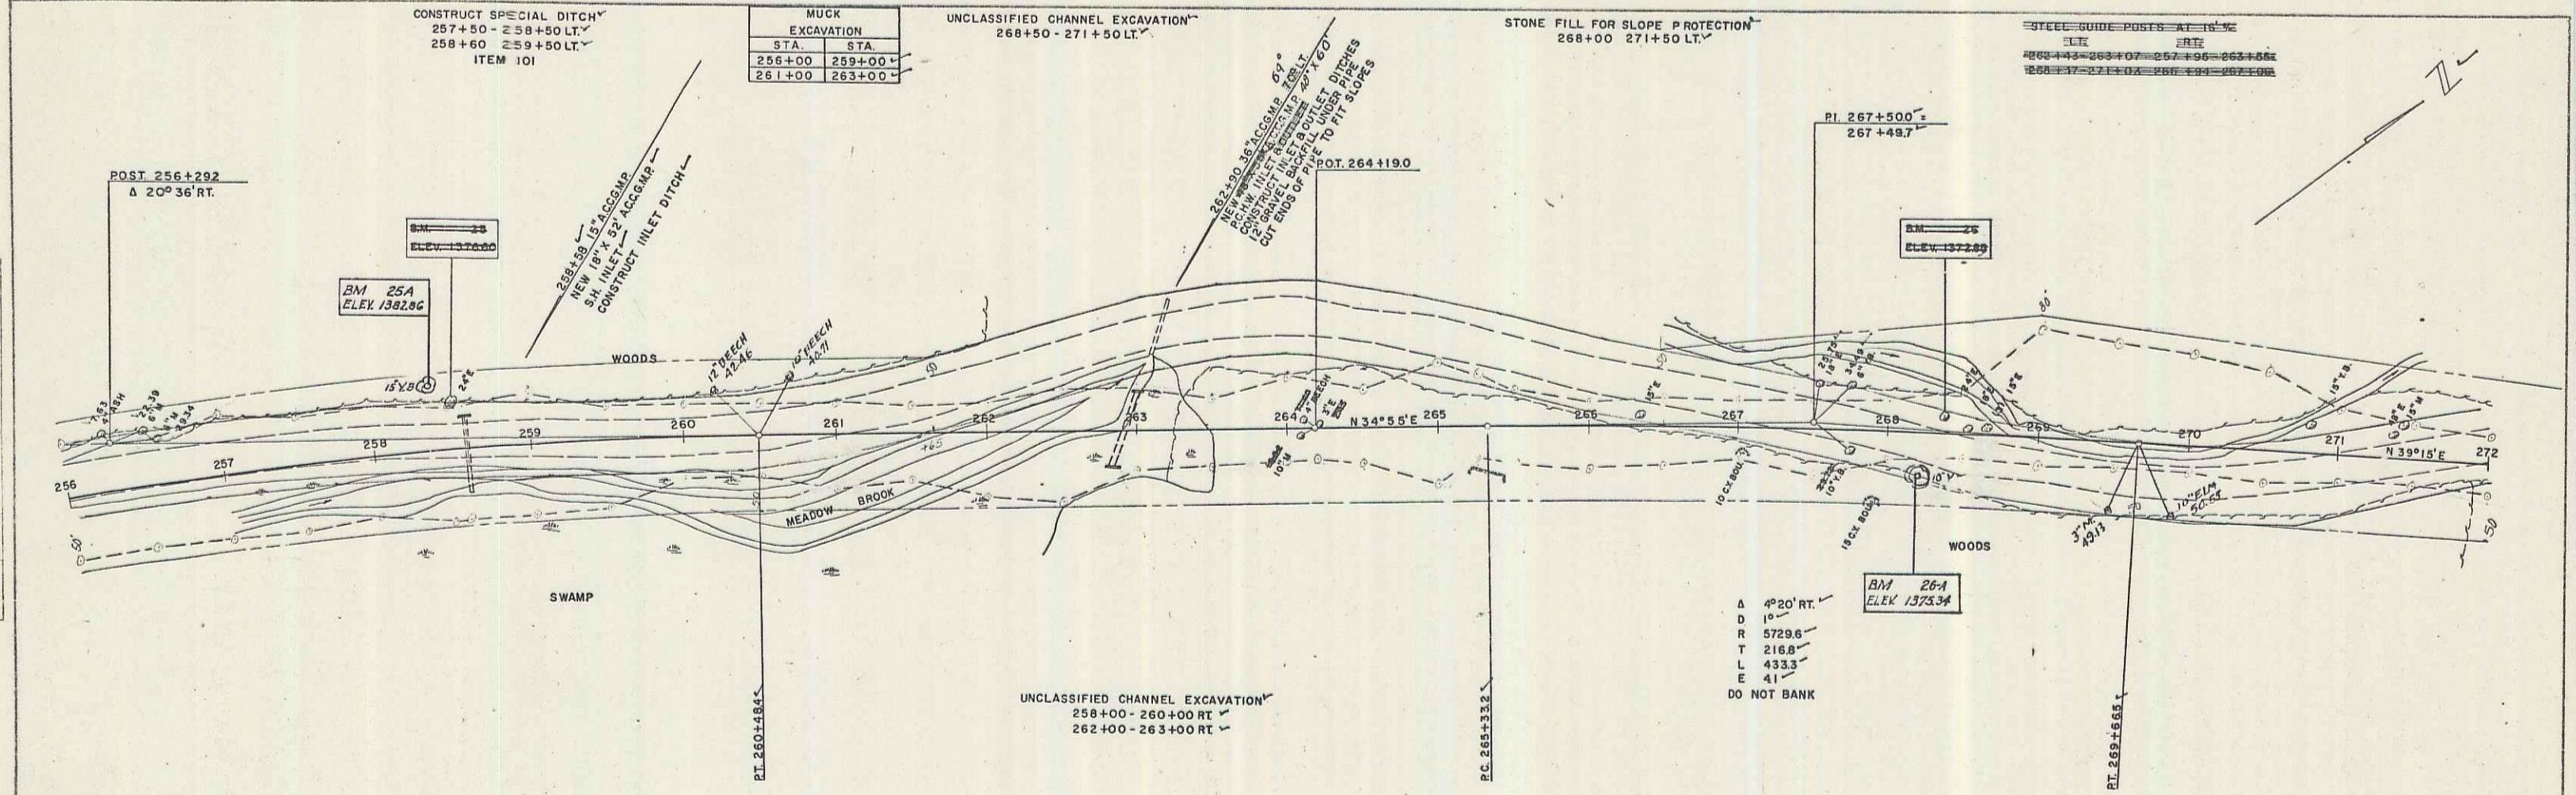


PLATE 1 - PLAN - PROFILE
 PALMER
 WEBSTER-MARTIN, INC.
 11-56