
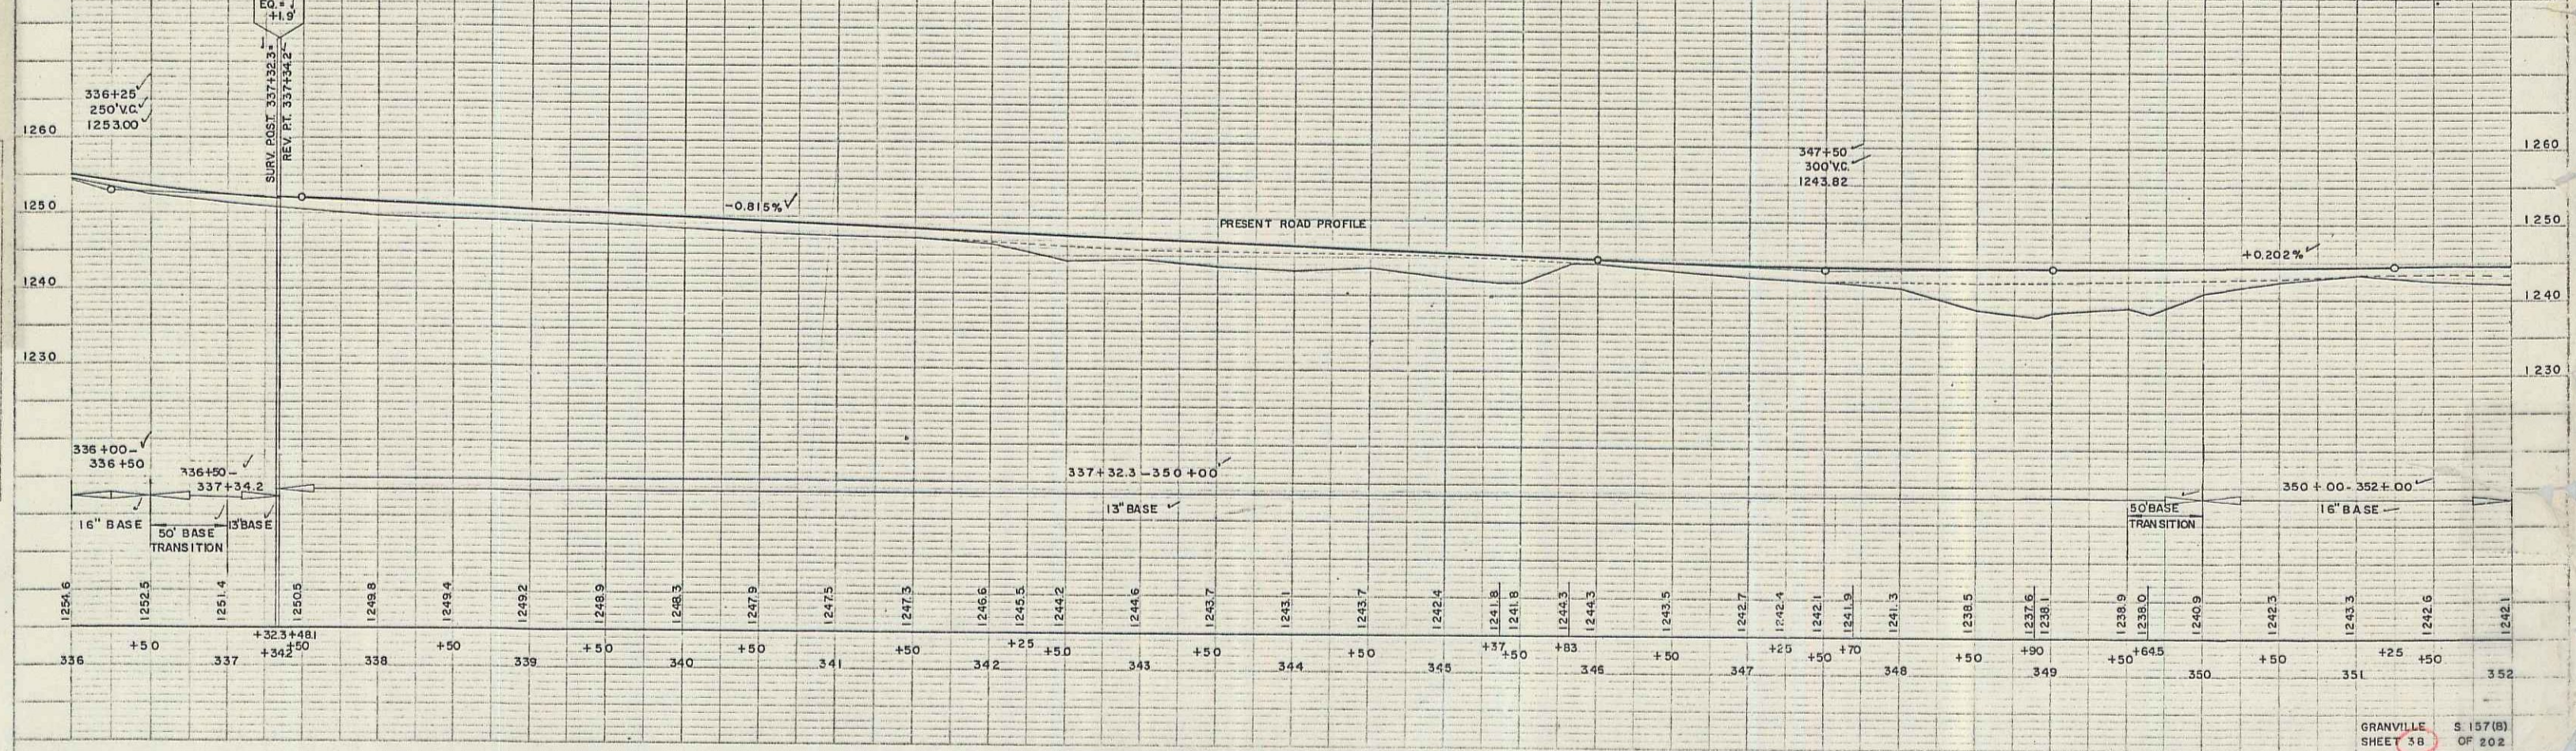


PLAN
 PALMER
 WEBSTER-MARTIN, INC.
 6-16
 11-58
 1150 W. 42ND ST. NEW YORK 19, N.Y.

PROFILE
 PALMER
 WEBSTER-MARTIN, INC.
 6-16
 11-58
 1150 W. 42ND ST. NEW YORK 19, N.Y.

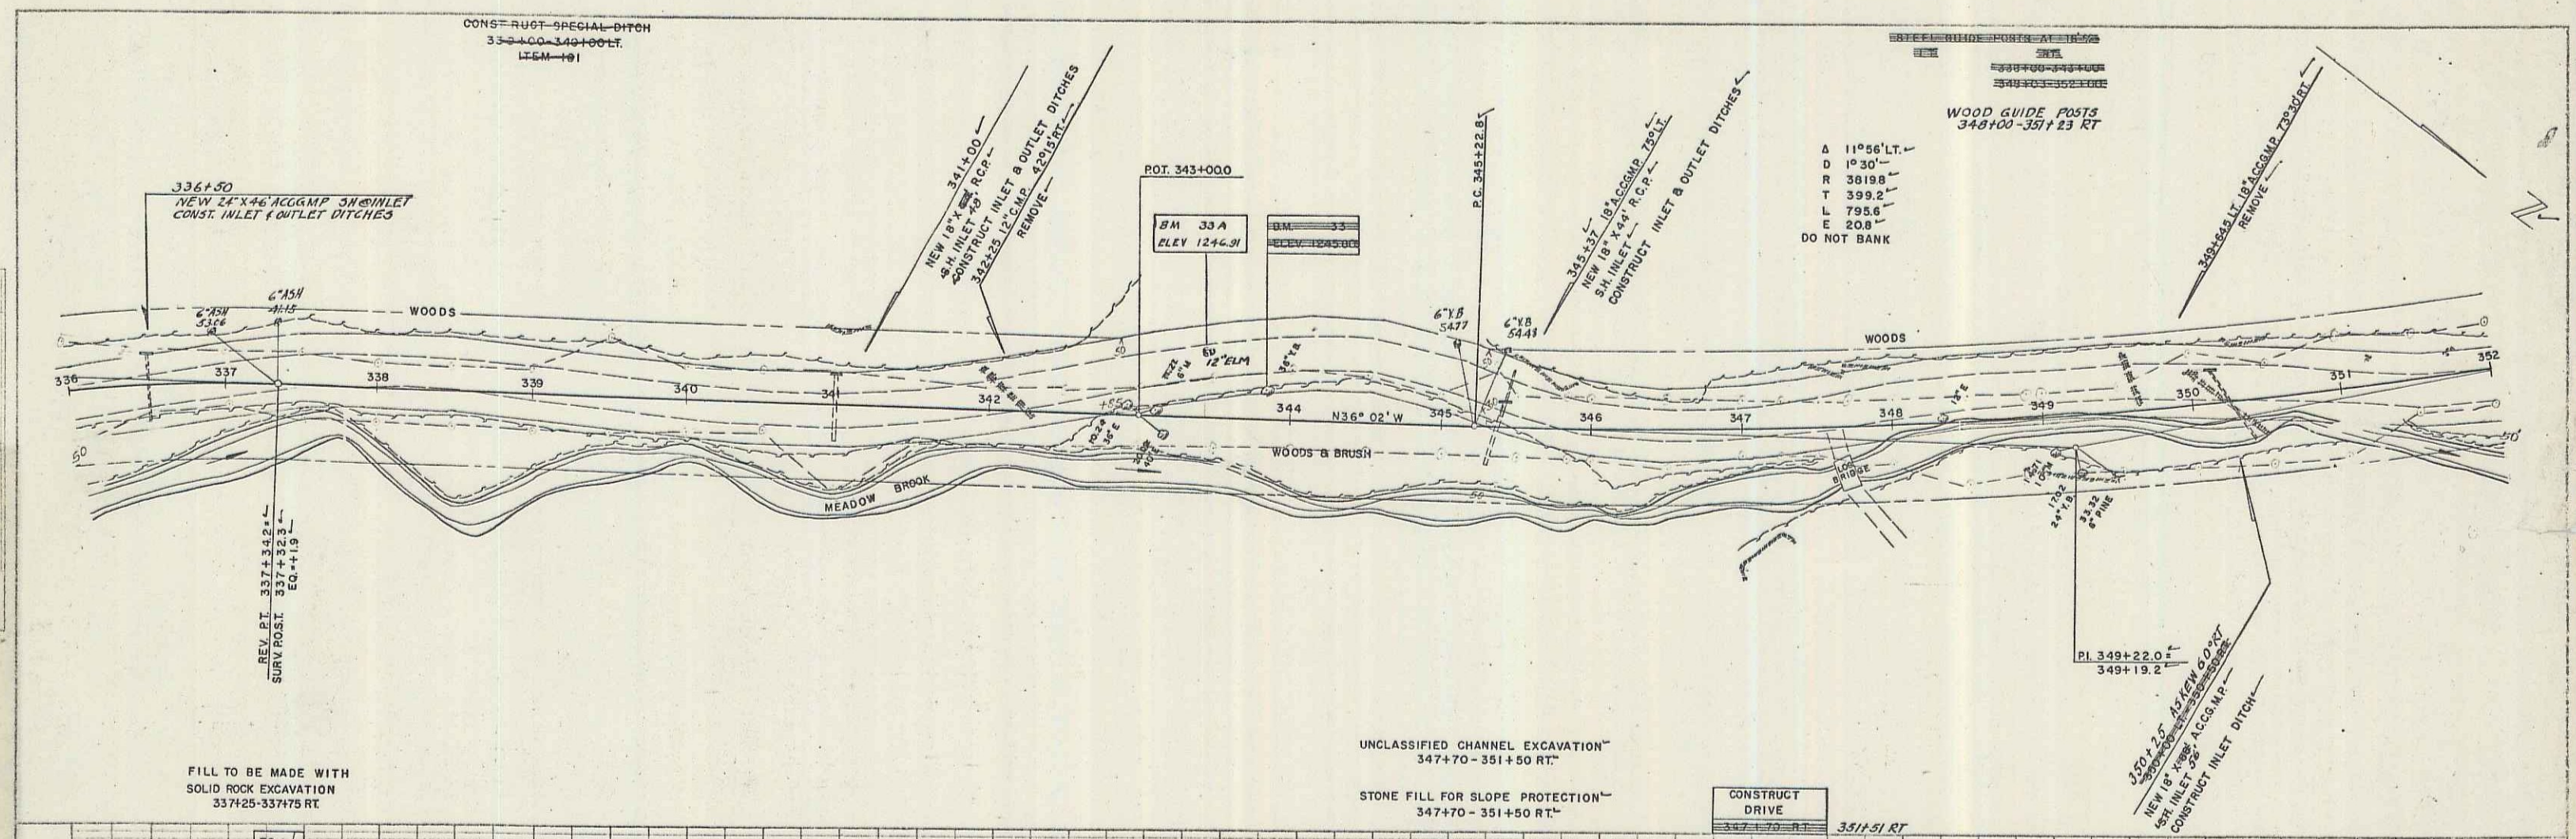

B.M. 33A 42' 12" ELM 42' LT. 343+43 ELEV. 1246.91

GRANVILLE
 SHEET 58
 OF 202