
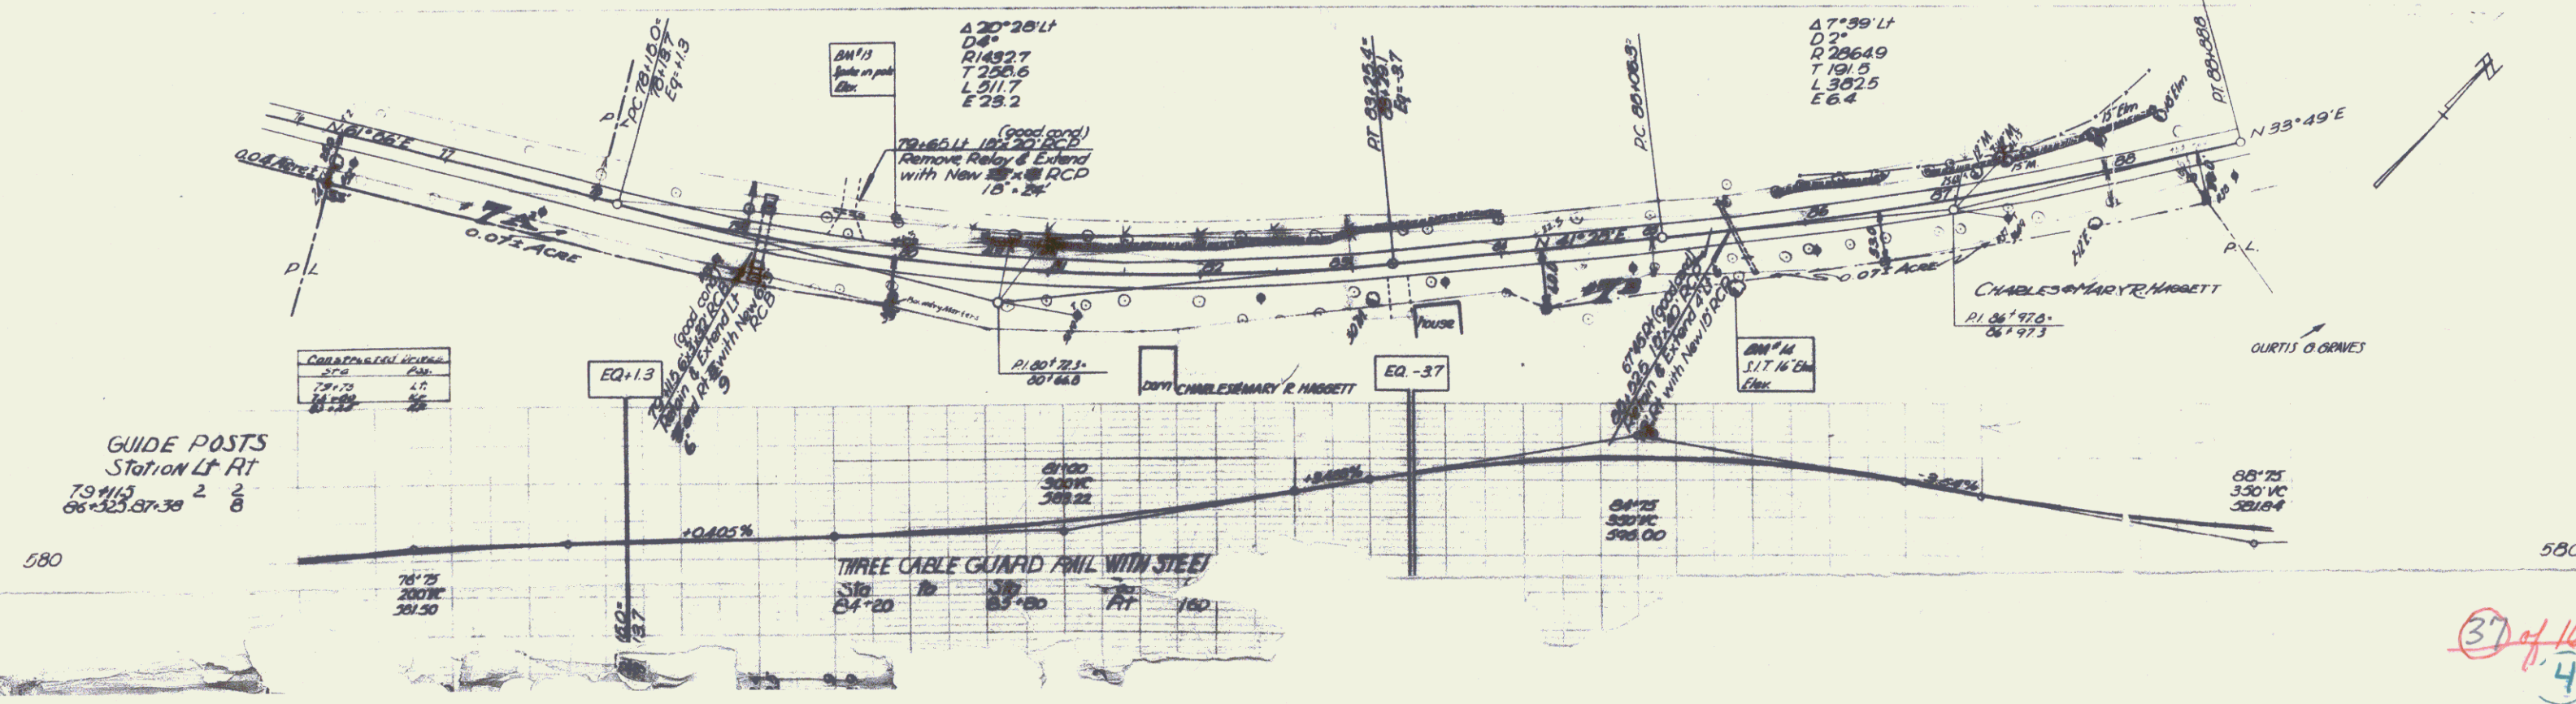


VT Rte 100

Waterbury Stone F-116(6)

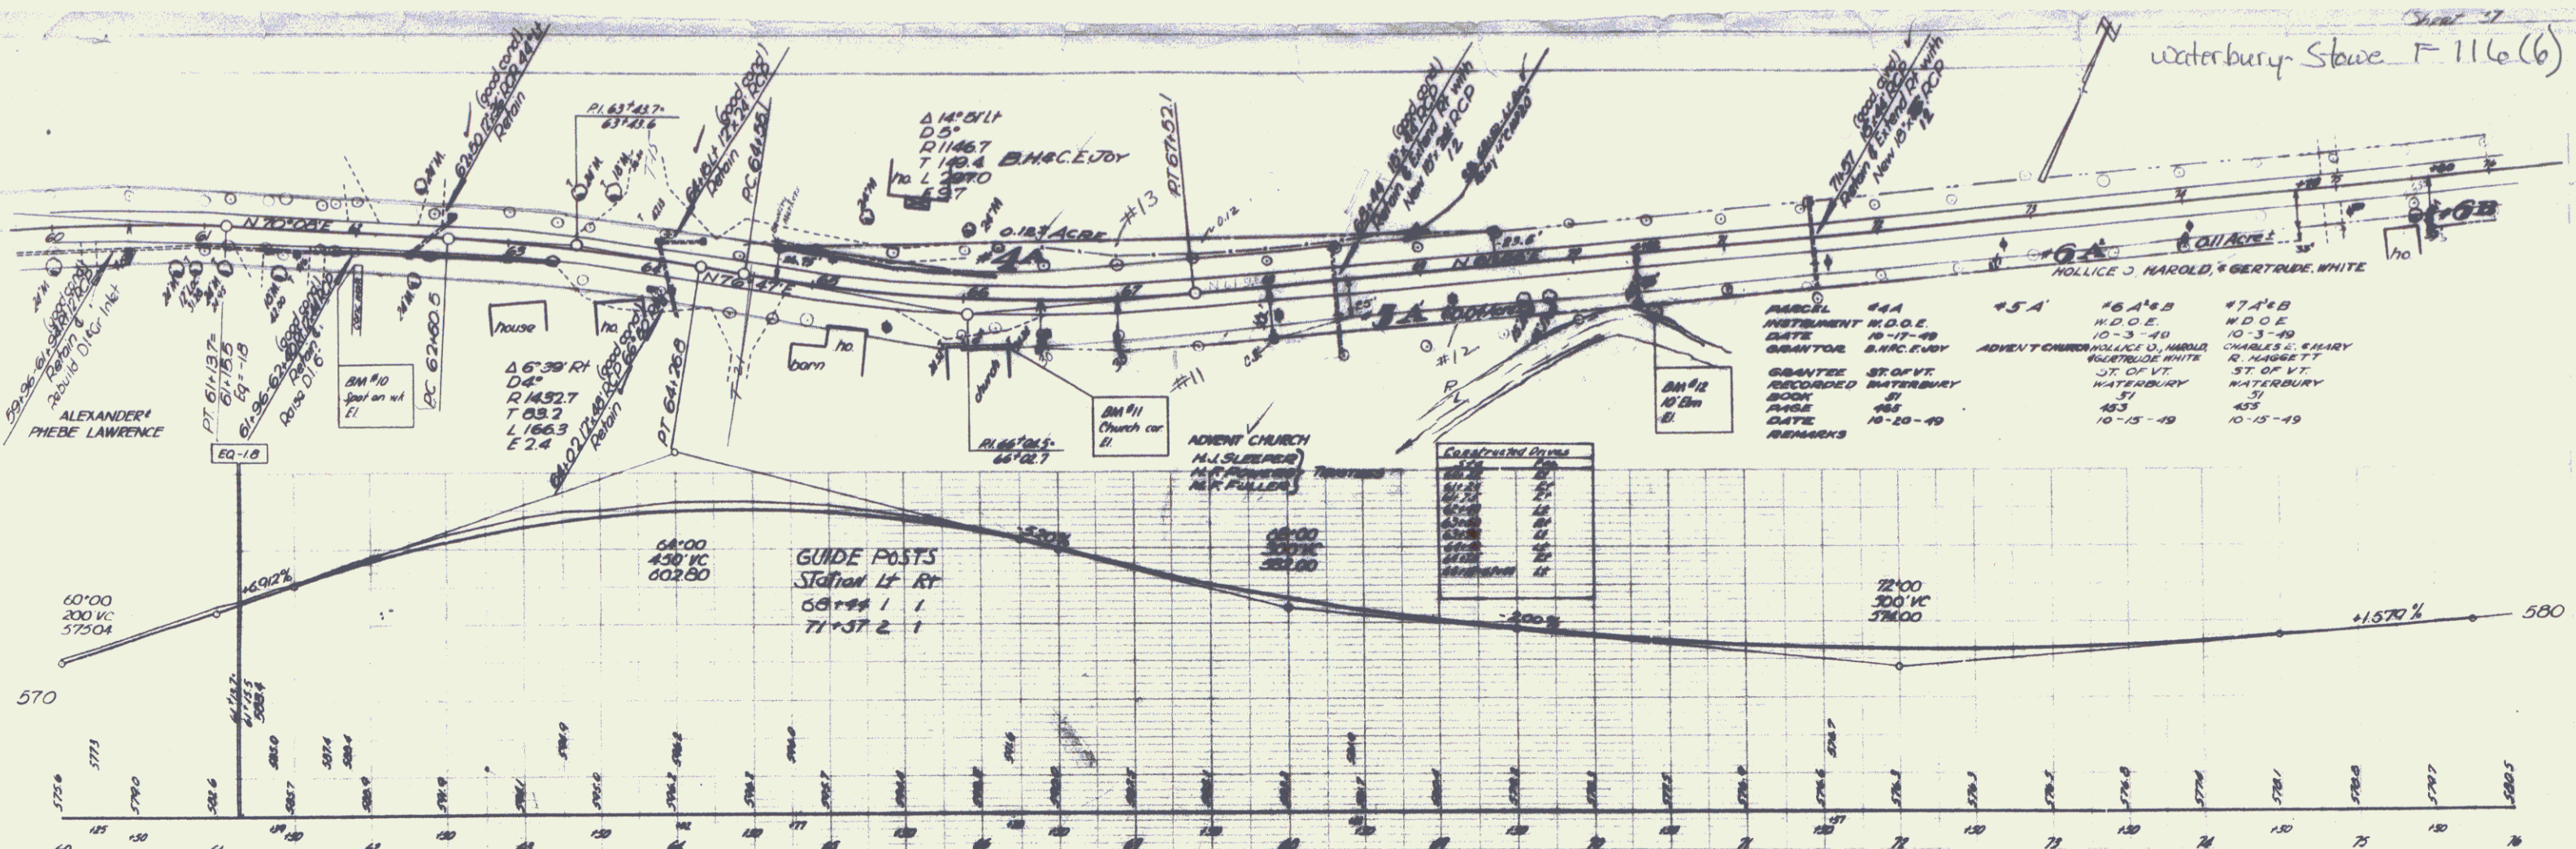

37 of 169  
4