

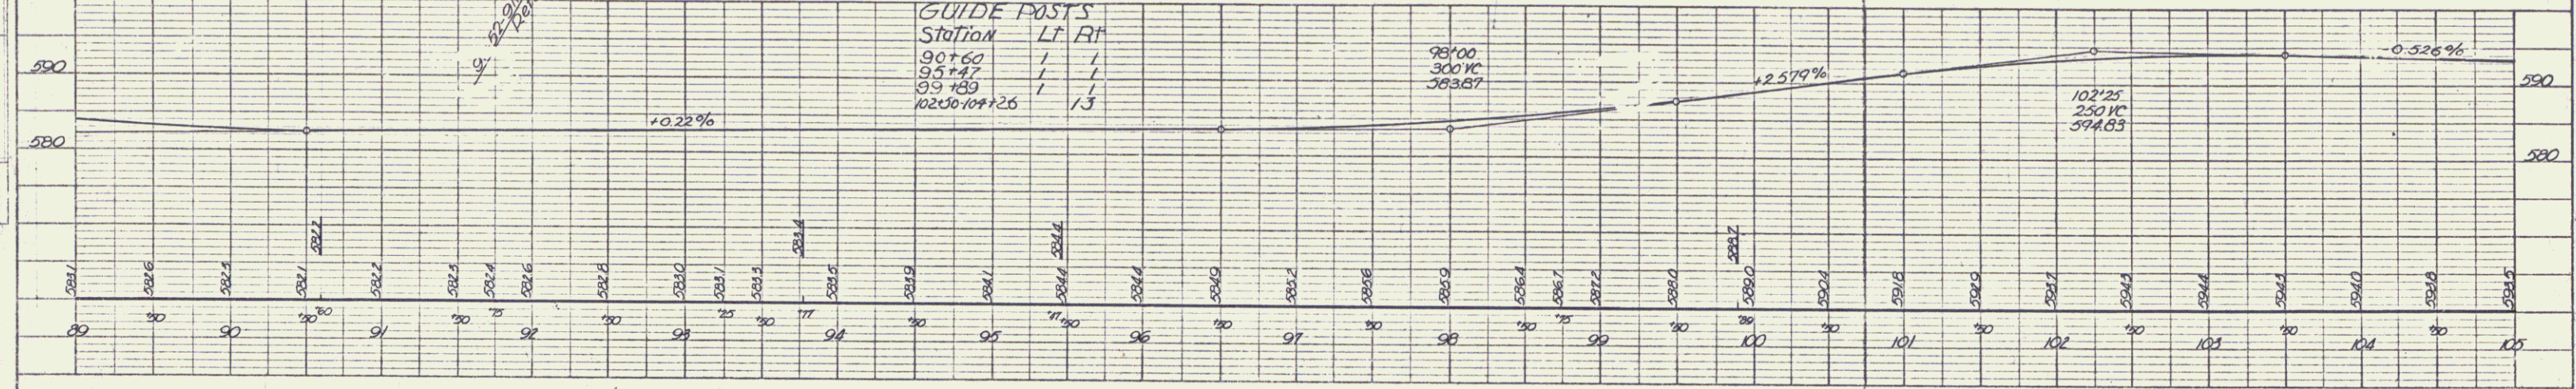


GUIDE POSTS

Station	LT	RT
90+60	1	1
95+47	1	1
99+89	1	1
10250+04+26	1	1/3
98+00		
300+00		
303+67		

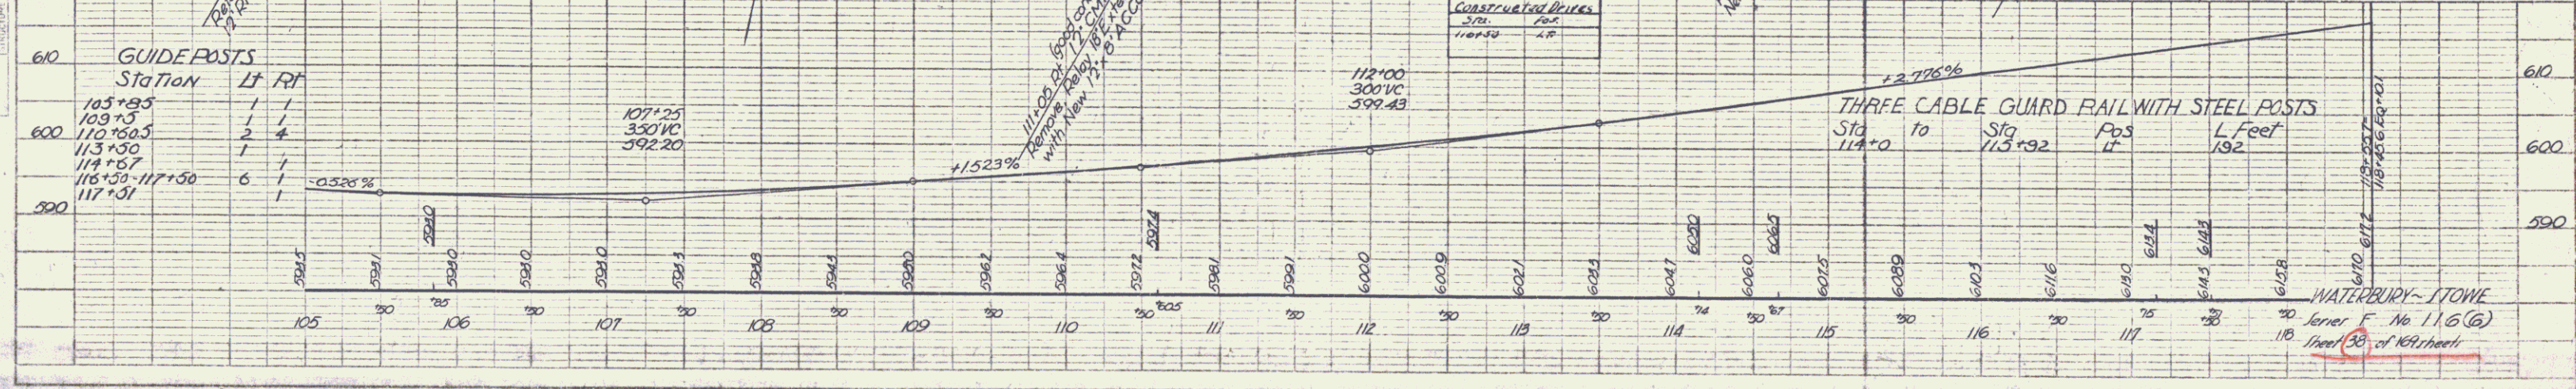

PLAN
 SHEET NO. 38
 DATE 10-15-49
 DRAWN BY [illegible]
 CHECKED BY [illegible]

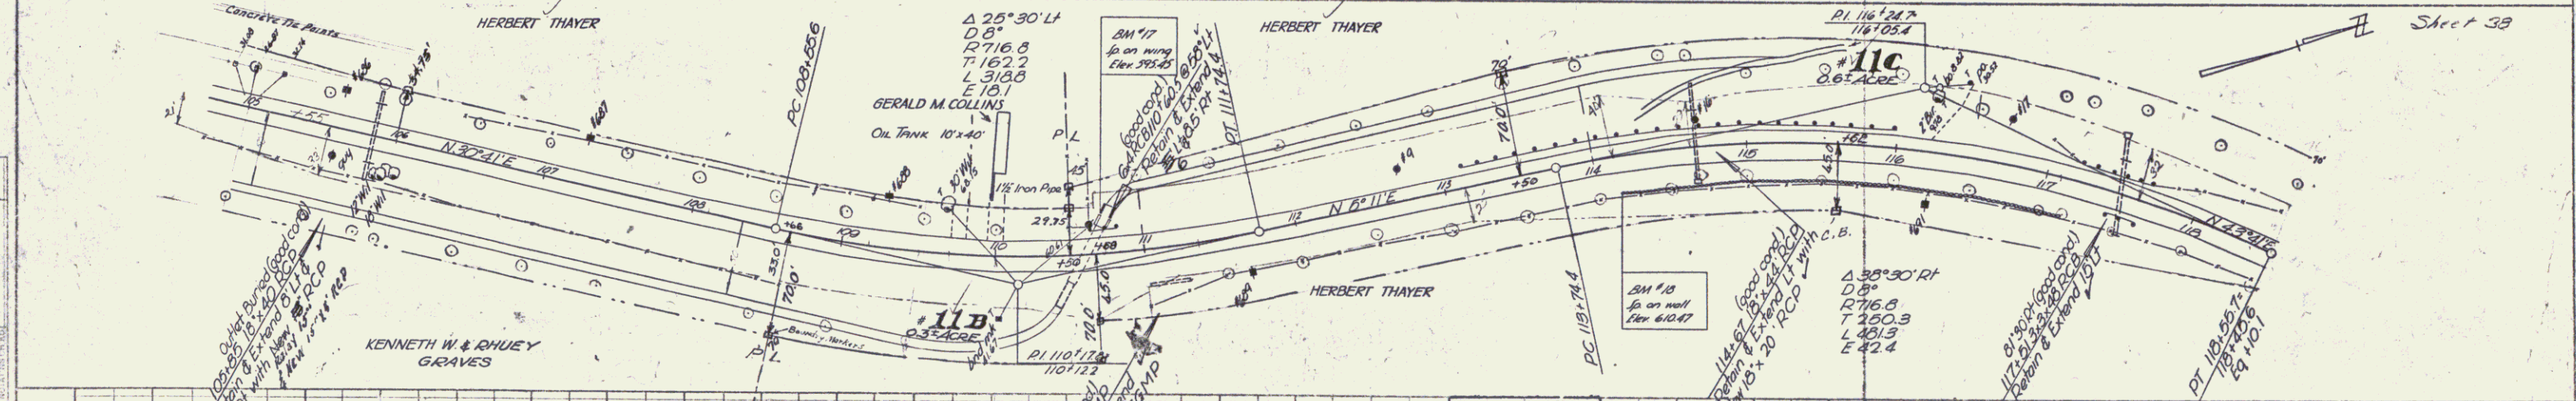

GUIDE POSTS

Station	LT	RT
105+95	1	1
109+05	2	2
113+50	1	1
114+67	6	6
116+50-117+50		
117+51		
107+25		
350+00		
592+20		
112+00		
300+00		
599+43		

THREE CABLE GUARD RAIL WITH STEEL POSTS

Sta	Stg	Pos	L Feet
114+0	10	113+92	192