


PARCEL	#16A	#17A	#A
INSTRUMENT	W.D.O.E.	CORR D.O.E.	W.D.O.E.
DATE	10-3-49	10-21-49	6-30-51
GRANTOR	FRANK H & B. EARL, FC LUCE CO. INC., K & C Gibbs		
GRANTEE	ST. OF VT.	ST. OF VT.	ST. OF VT.
RECORDED BOOK	WATERBURY 51	WATERBURY 51	WATERBURY 53
PAGE	443	464	238B
DATE	10-15-49	10-25-49	1-27-51
REMARKS	LATEST 8th		

PLAN
 SURVEYOR
 ALL RIGHTS RESERVED
 NOT BE LOANED, REPRODUCED, COPIED, OR IN ANY MANNER USED WITHOUT THE WRITTEN CONSENT OF THE SURVEYOR

PROFILE
 SURVEYOR
 ALL RIGHTS RESERVED
 NOT BE LOANED, REPRODUCED, COPIED, OR IN ANY MANNER USED WITHOUT THE WRITTEN CONSENT OF THE SURVEYOR

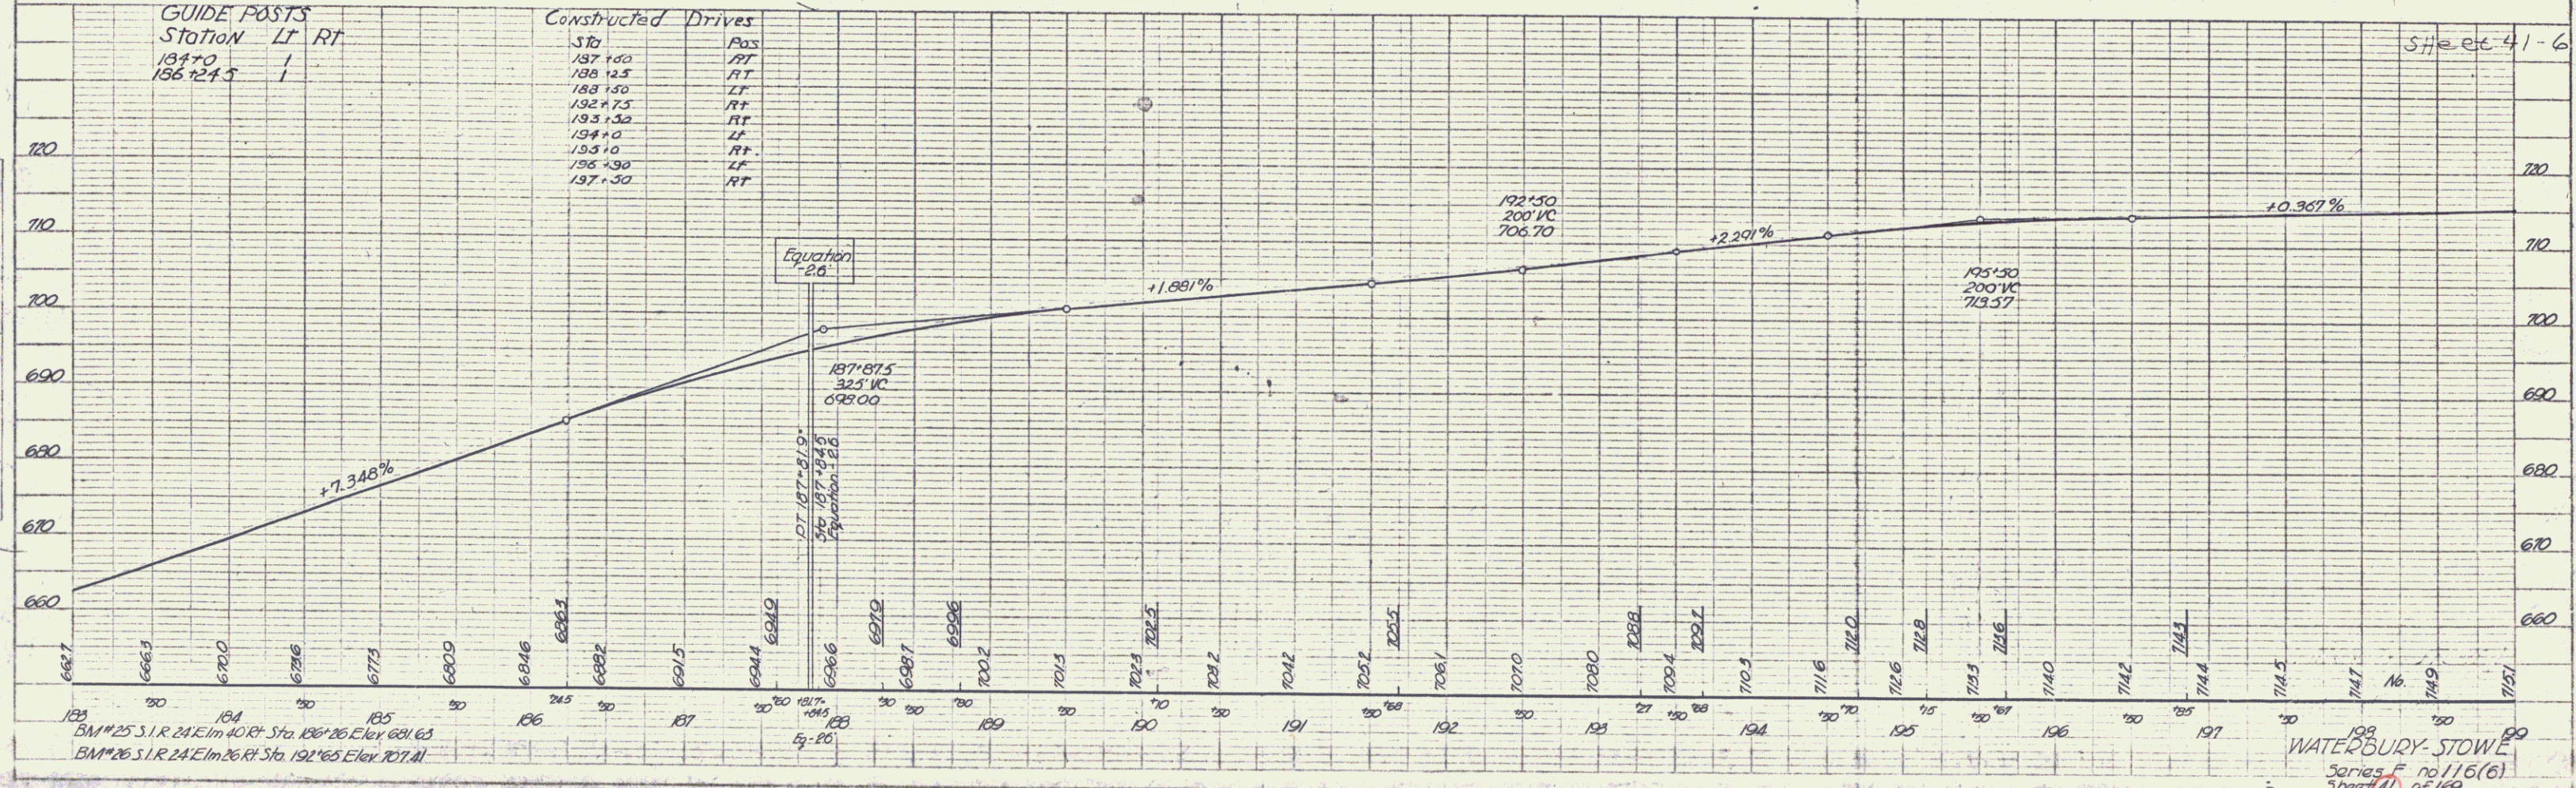

GUIDE POSTS	Station	LT	RT
	187+0		1
	186+24.5		1

Constructed Drives	Sta	Pass
	187+40	RT
	188+25	RT
	189+50	LT
	192+75	RT
	193+30	RT
	194+10	LT
	195+10	RT
	196+30	LT
	197+30	RT

BM 125 S.I.R. 24' E. in 40' R. Sta. 186+26 Elev. 691.63
 BM 126 S.I.R. 24' E. in 26' R. Sta. 192+65 Elev. 707.11

WATERBURY STOWE
 Series F no 116(6)
 Sheet (4) of 169