



PLAN
 DATE: _____
 DRAWN BY: _____
 CHECKED BY: _____
 SCALE: _____

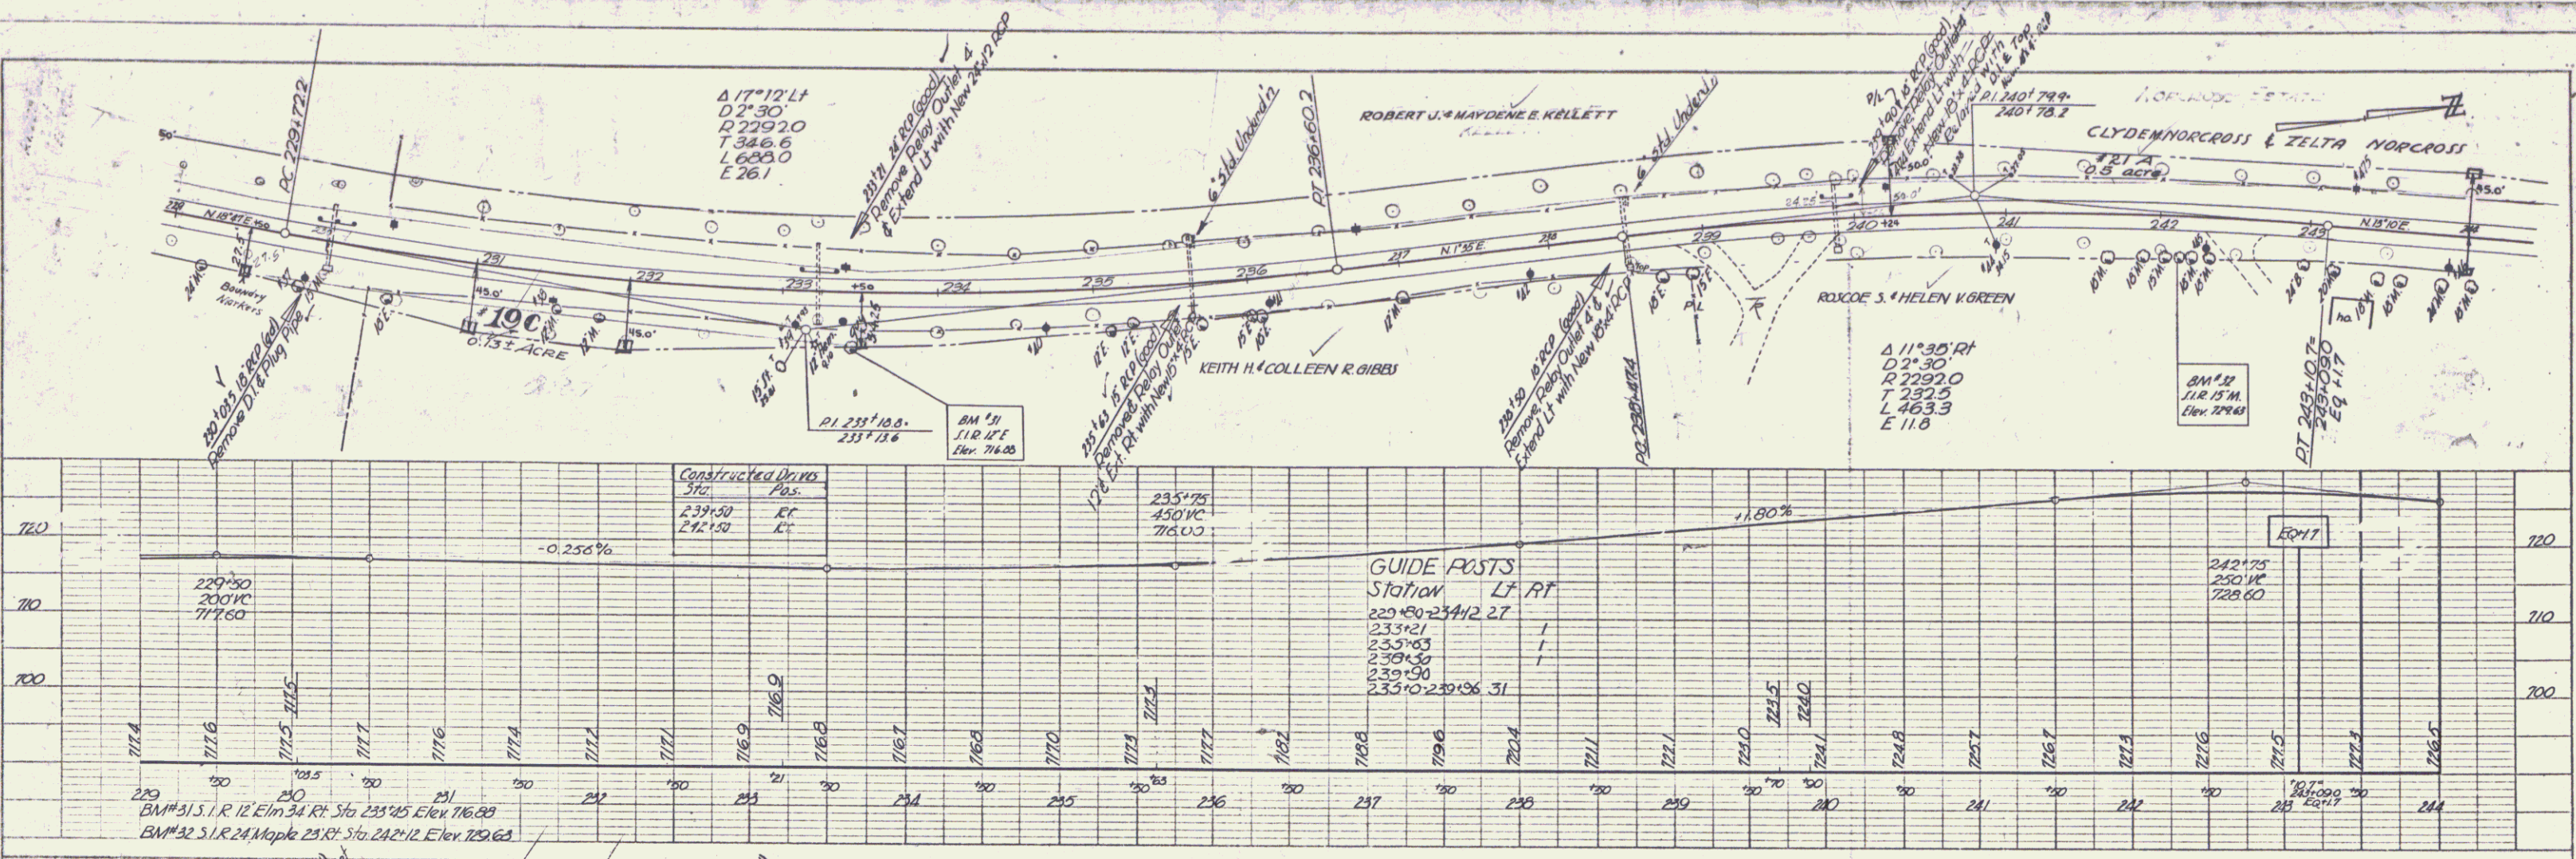

PROFILE
 DATE: _____
 DRAWN BY: _____
 CHECKED BY: _____
 SCALE: _____

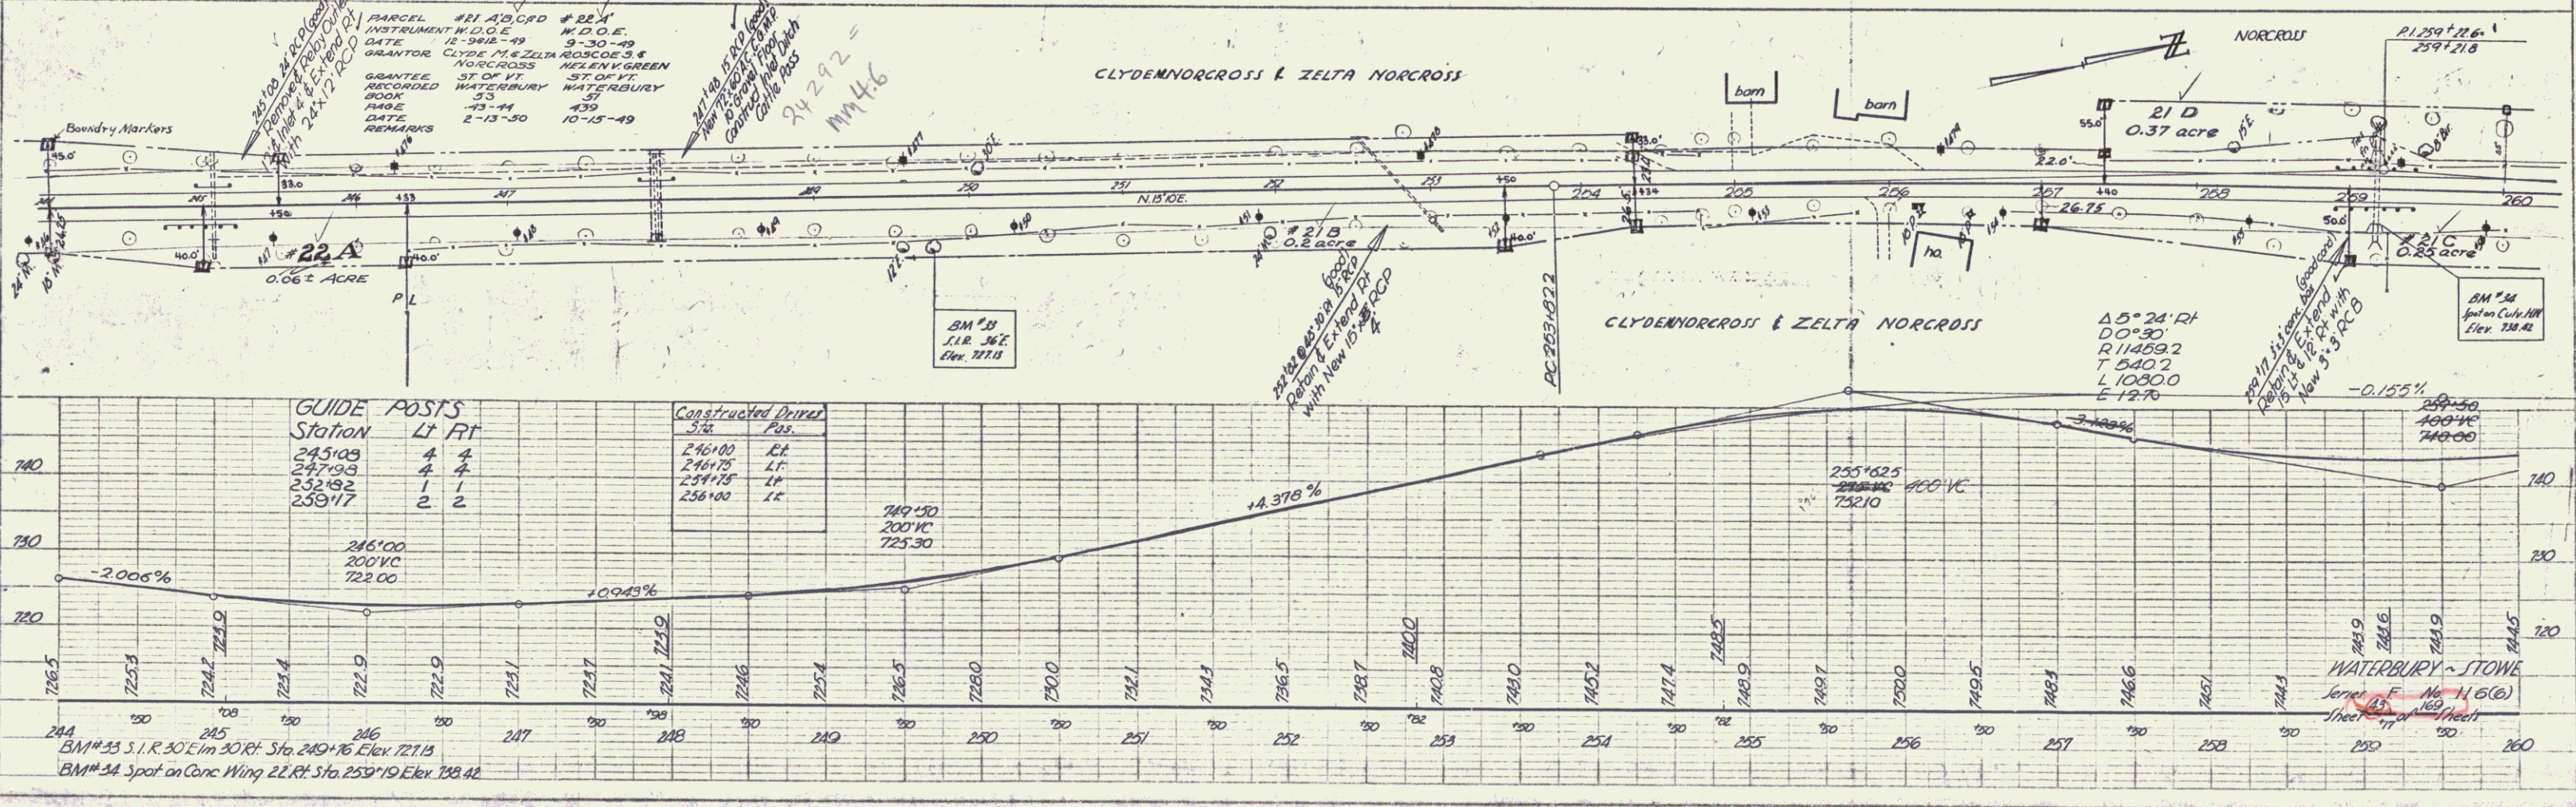

PLANNED PROFILE C.P. & P. STATIONS
 REVISIONS
 DATE: _____