

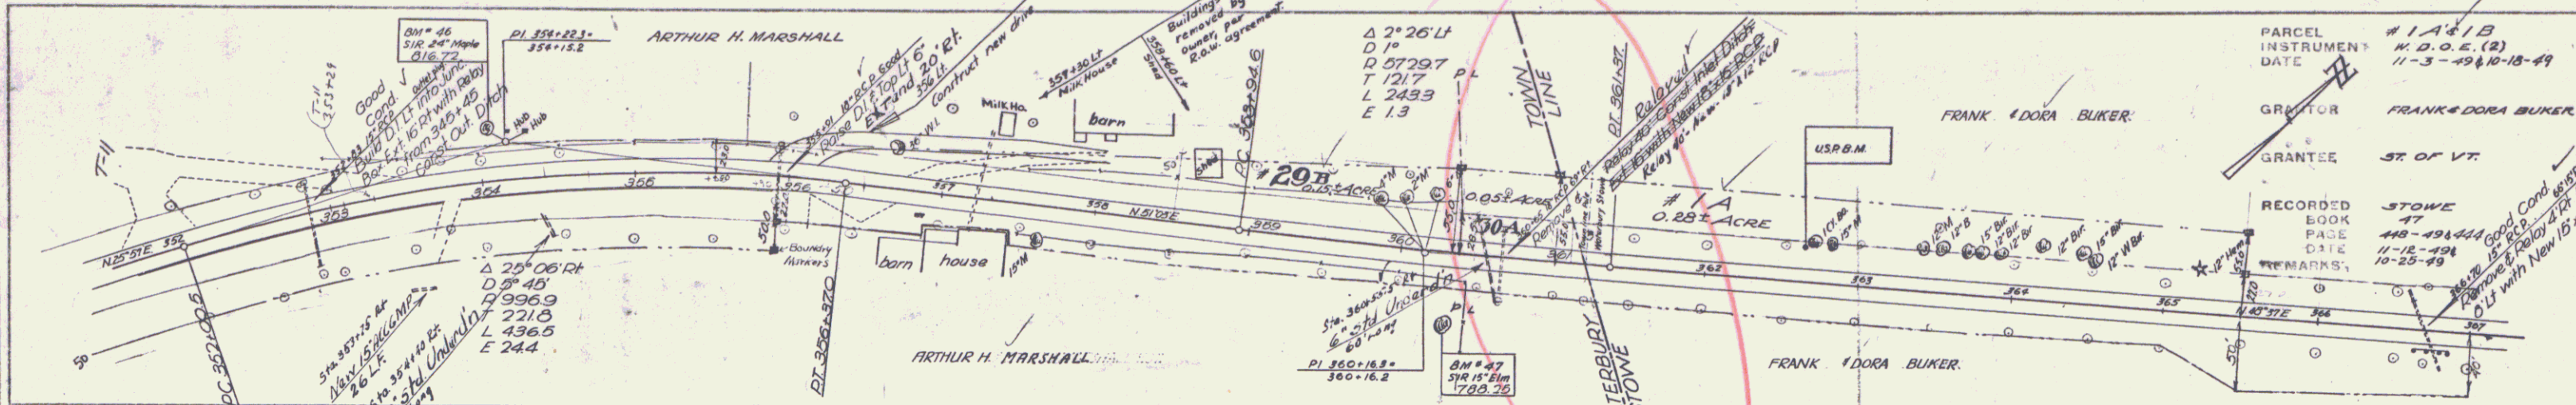


PLAN
 DATE: 11-12-49
 DRAWN BY: [illegible]
 CHECKED BY: [illegible]


PROFILE
 DATE: 11-12-49
 DRAWN BY: [illegible]
 CHECKED BY: [illegible]

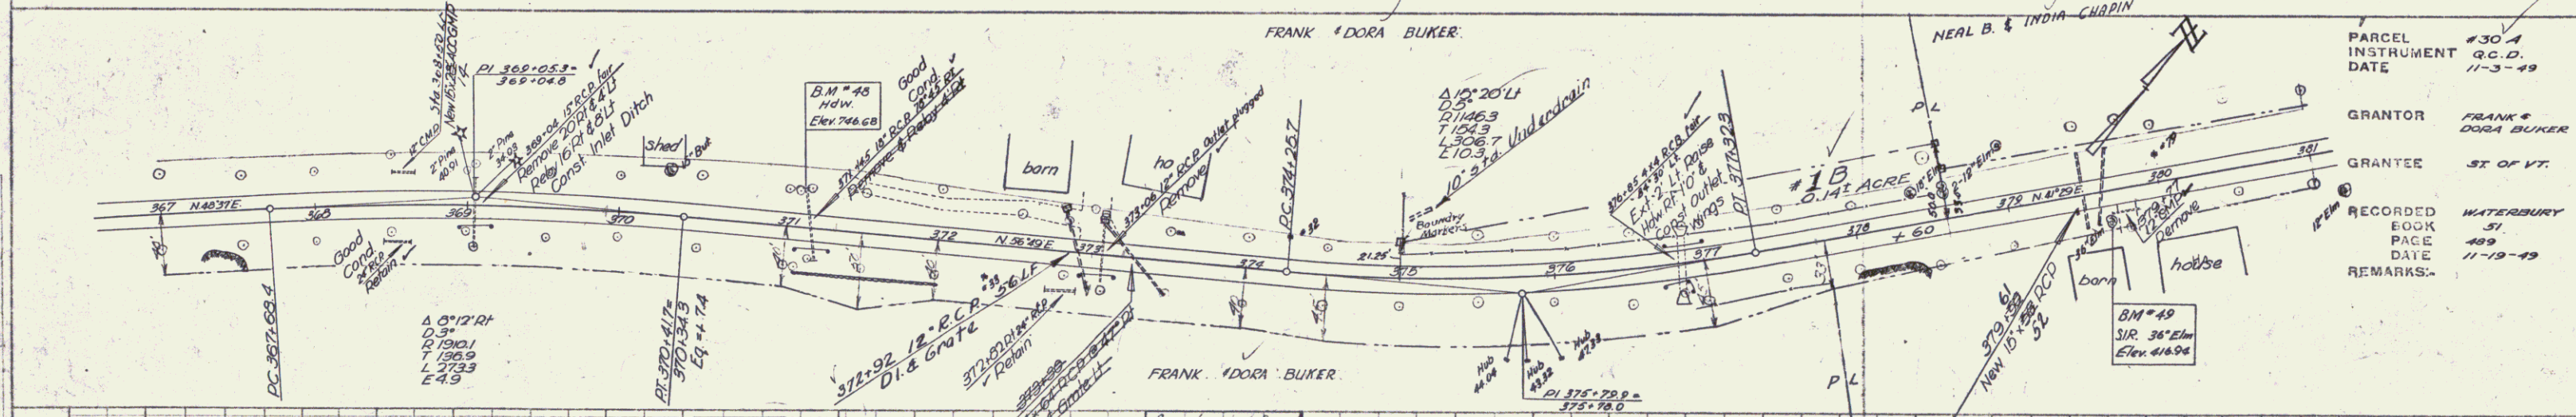

PARCEL INSTRUMENT #1418
 DATE 11-3-49 & 10-18-49
 GRANTOR FRANK & DORA BUKER
 GRANTEE ST OF VT
 RECORDED BOOK 47
 PAGE 418-419
 DATE 11-12-49
 10-25-49
 REMARKS: Good Cond. gen. 20' LT with New 15' x 20' RCP

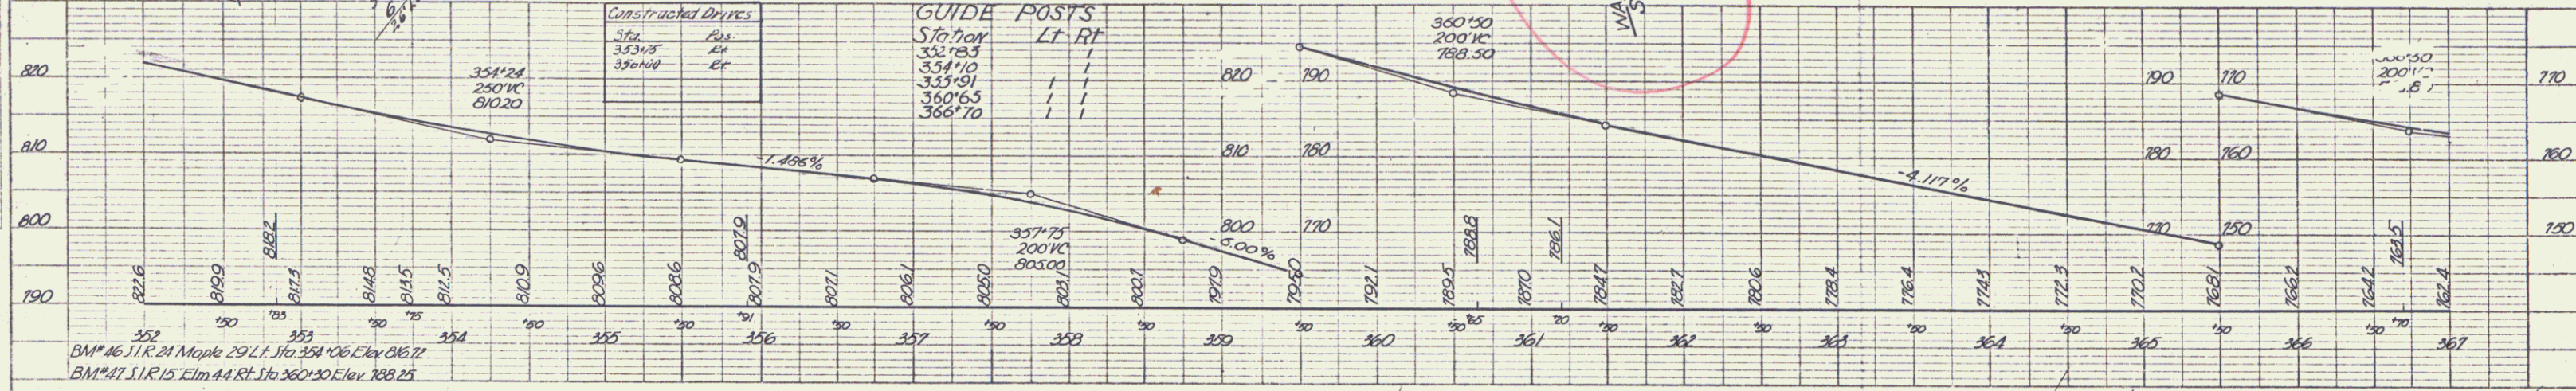

PARCEL INSTRUMENT #304
 DATE 11-3-49
 GRANTOR FRANK & DORA BUKER
 GRANTEE ST OF VT
 RECORDED BOOK 47
 PAGE 418
 DATE 11-12-49
 REMARKS:

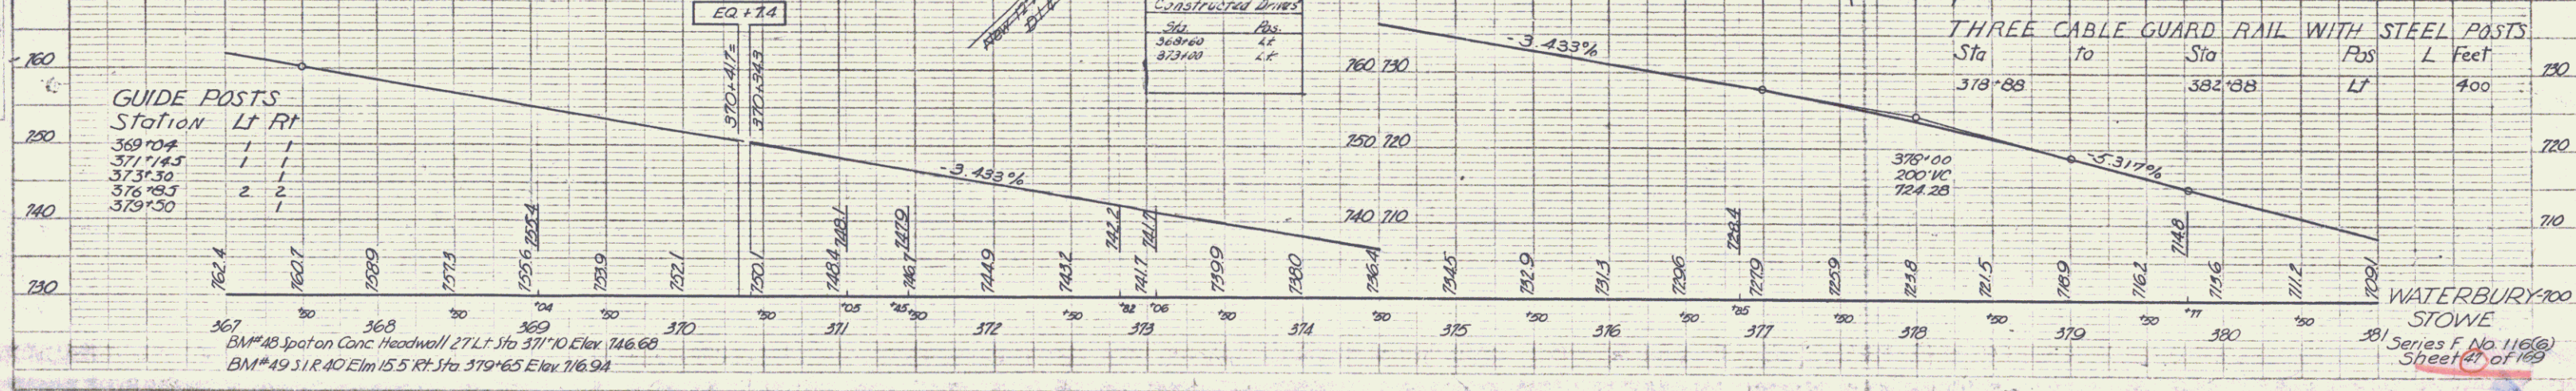

WATERBURY STOWE
 Series F No. 116(6)
 Sheet 4 of 163