
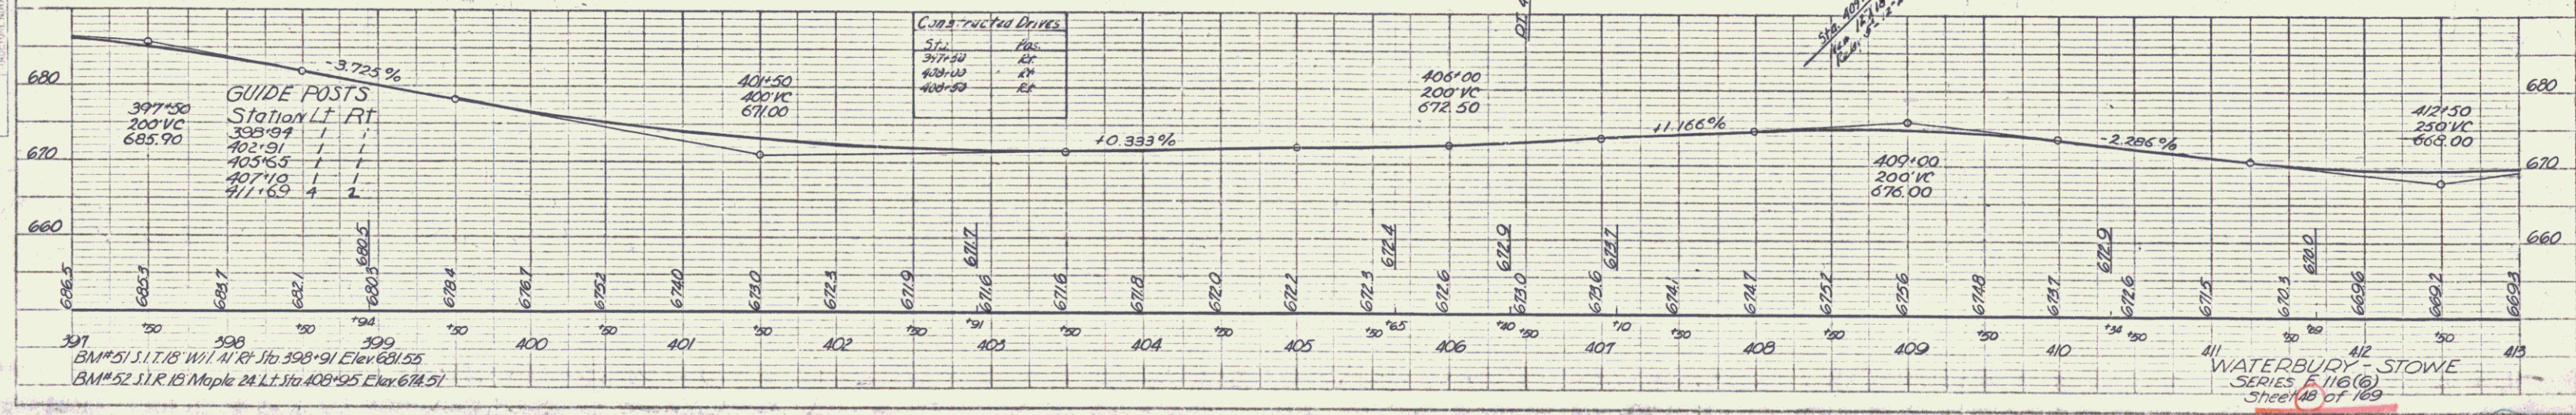
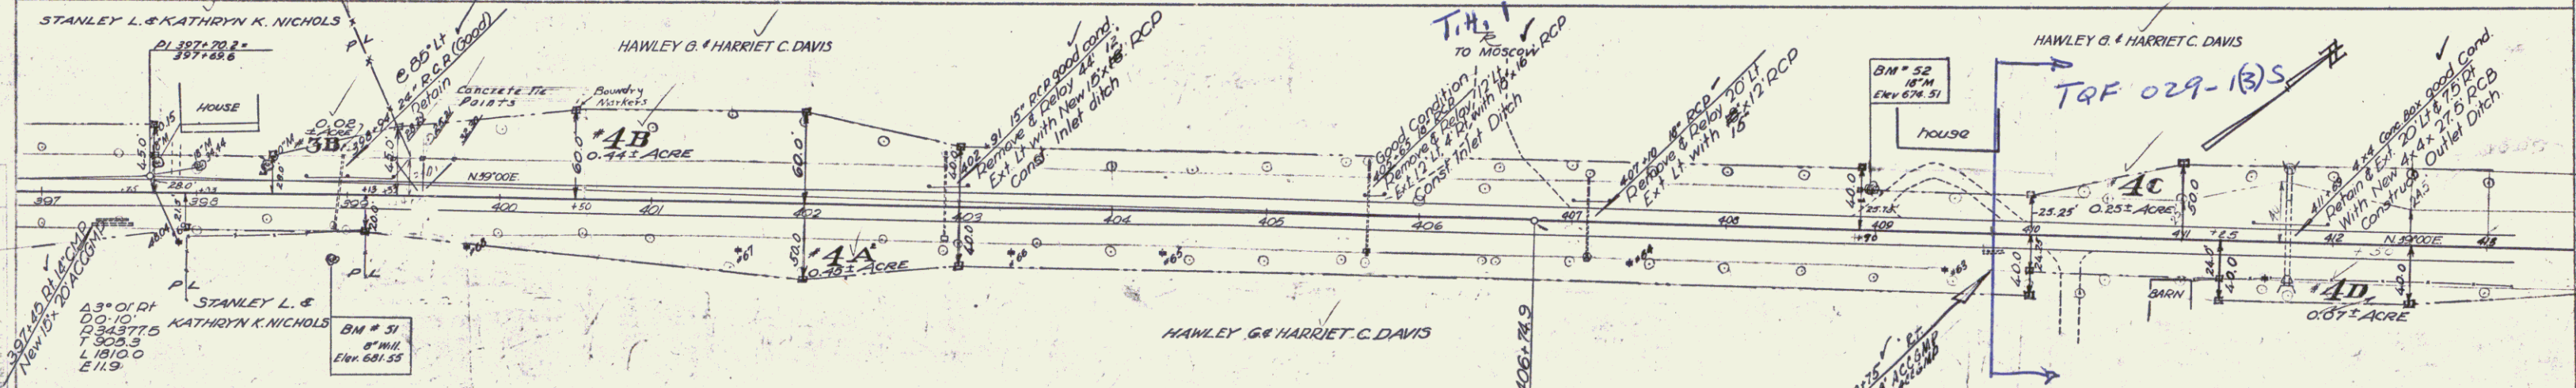
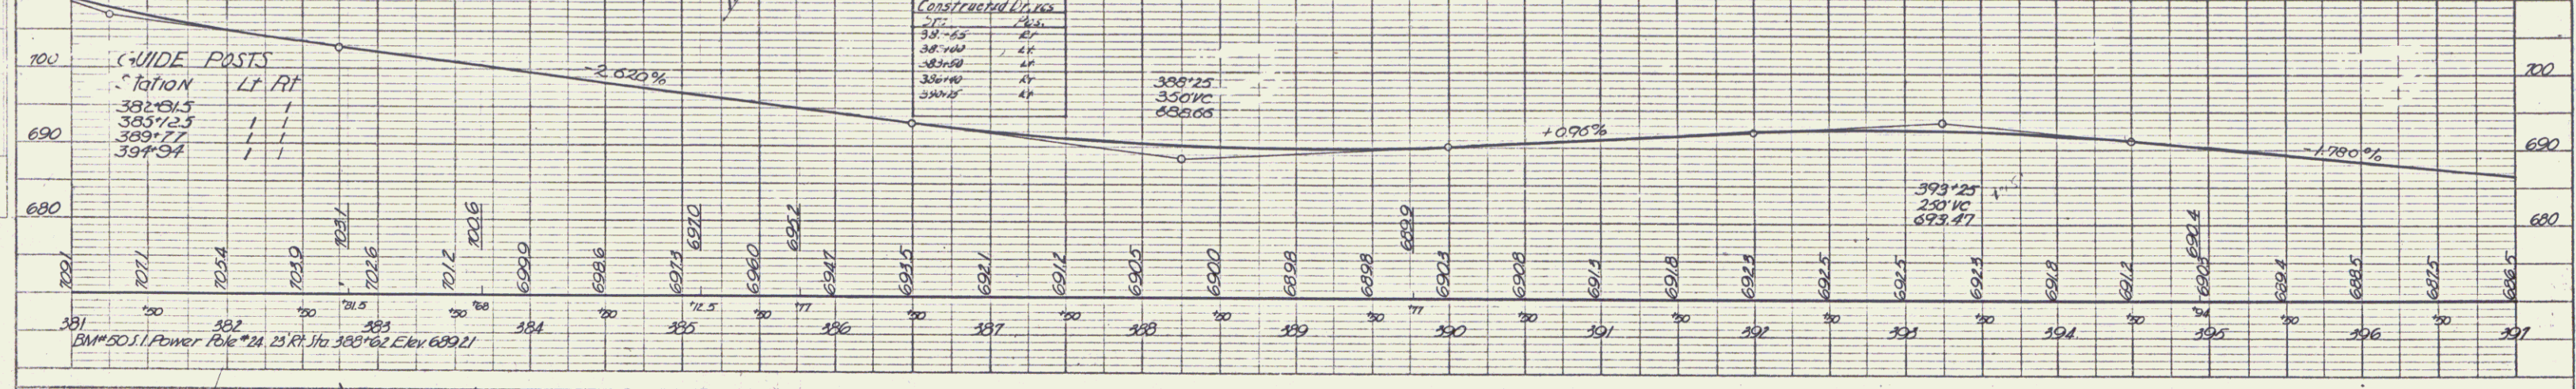


PLAN  
 DATE  
 DRAWN BY  
 CHECKED BY  
 IN CHARGE  
 DATE  
 NO.

PROFILE  
 DATE  
 DRAWN BY  
 CHECKED BY  
 IN CHARGE  
 DATE  
 NO.

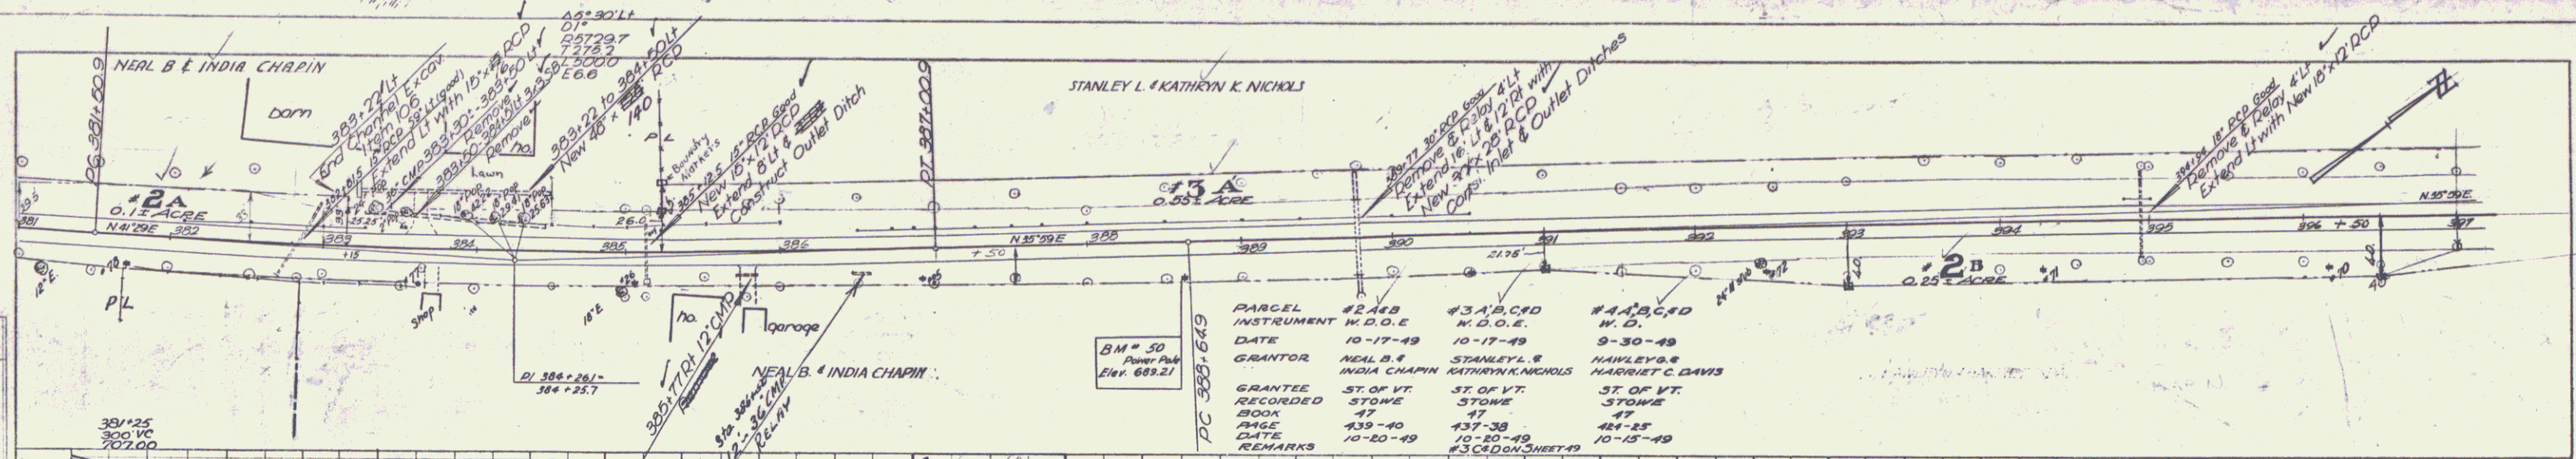

PLANNED ROAD PROFILE  
 K.E.T. CO., INC.