
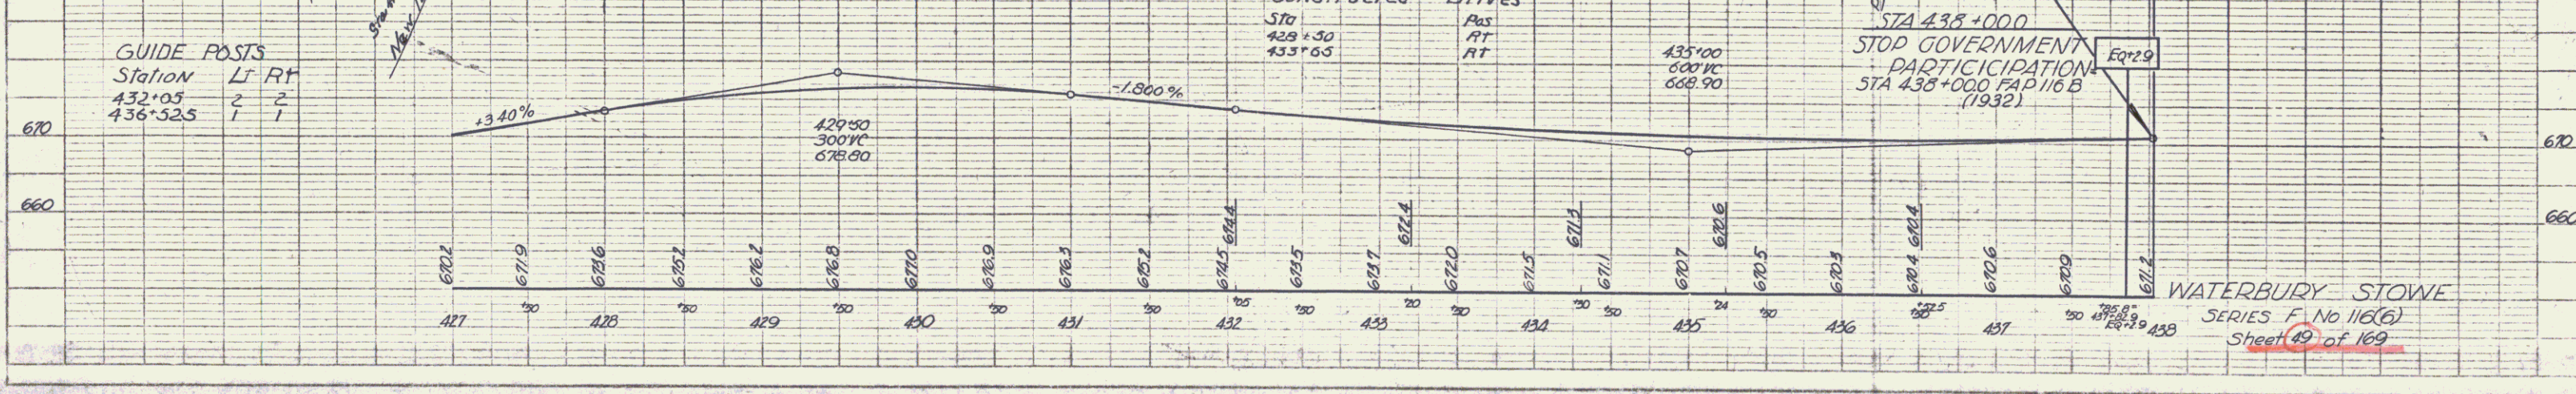
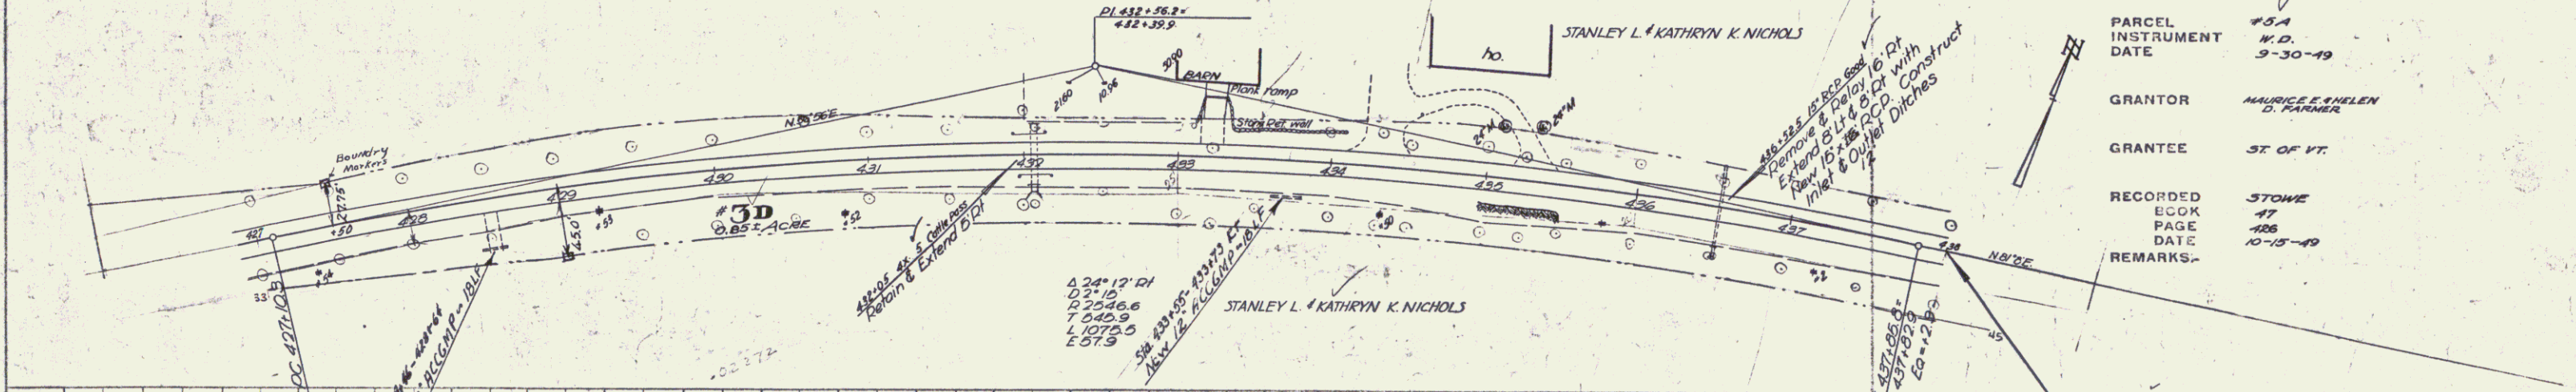
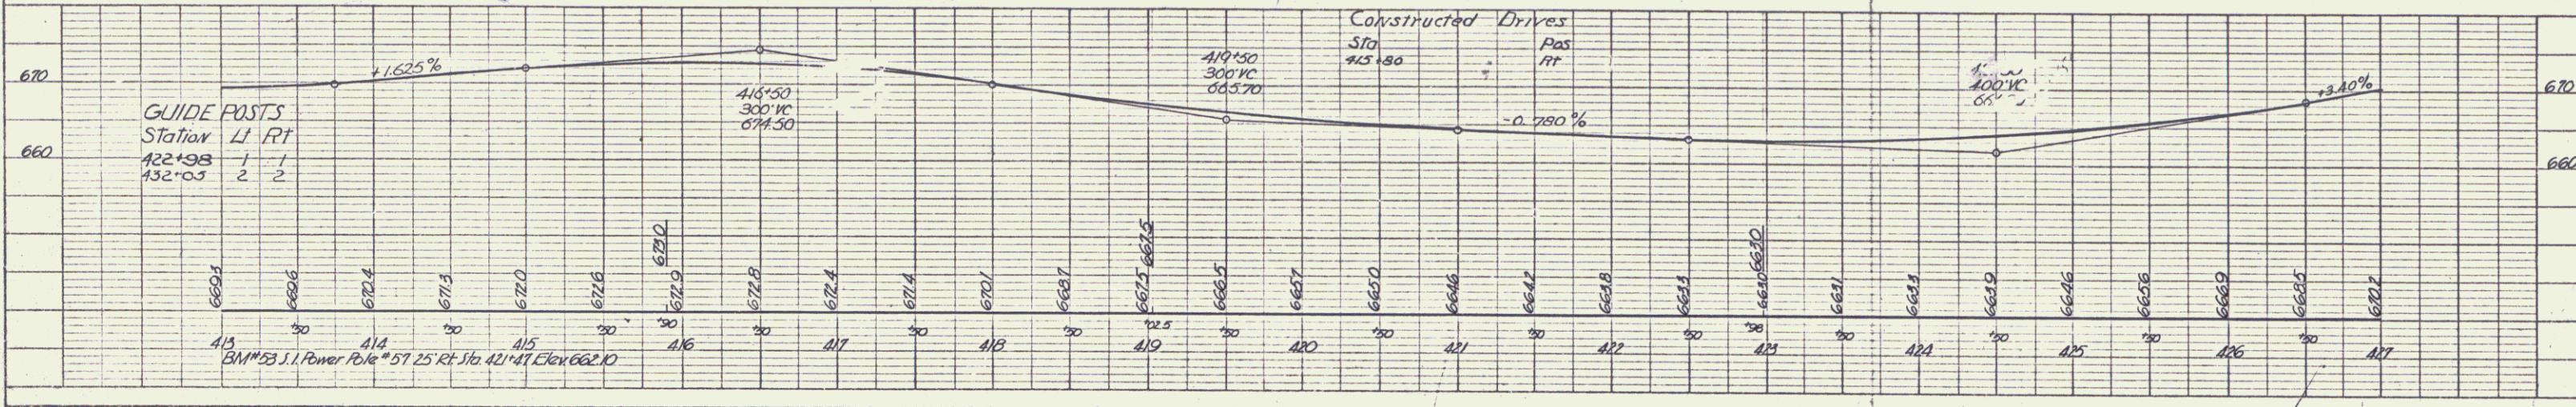


HAWLEY G. & HARRIET C. DAVIS
TQF 029-1(3)S

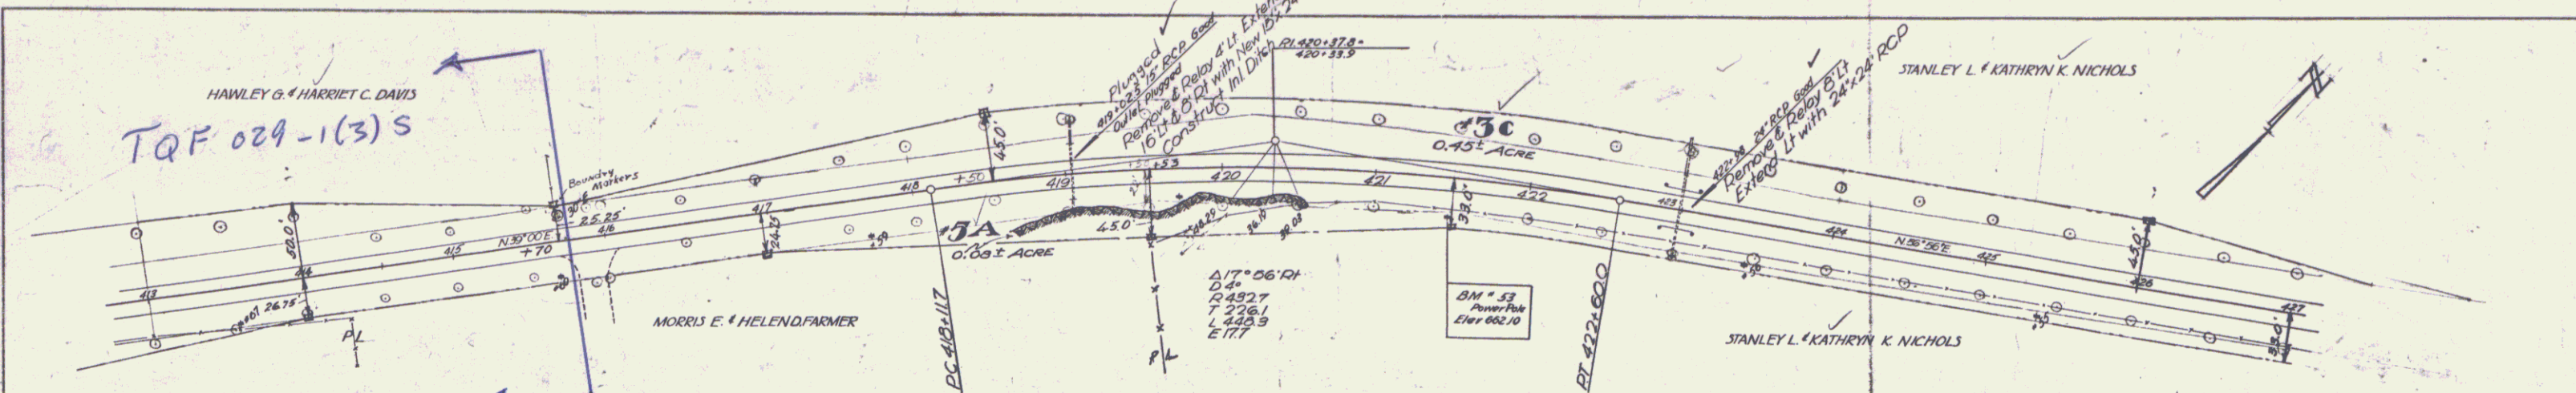

PARCEL INSTRUMENT #514
DATE 9-30-49
GRANTOR MAURICE E. HELEN & FARMER
GRANTEE ST OF VT
RECORDED 37
PAGE 426
DATE 10-15-49
REMARKS-

WATERBURY STOWE
SERIES F, No 116(6)
Sheet 49 of 169

PLAN
SCALE: AS SHOWN
DATE: 10-15-49
NO.:

PROFILE
SCALE: AS SHOWN
DATE: 10-15-49
NO.:

PLATE 3-BIAN PROFILE 6.5 IN X 8.5 STANDARD
STURTELL & SONS CO. NEW YORK
KAS 100 NO. 048210

16