
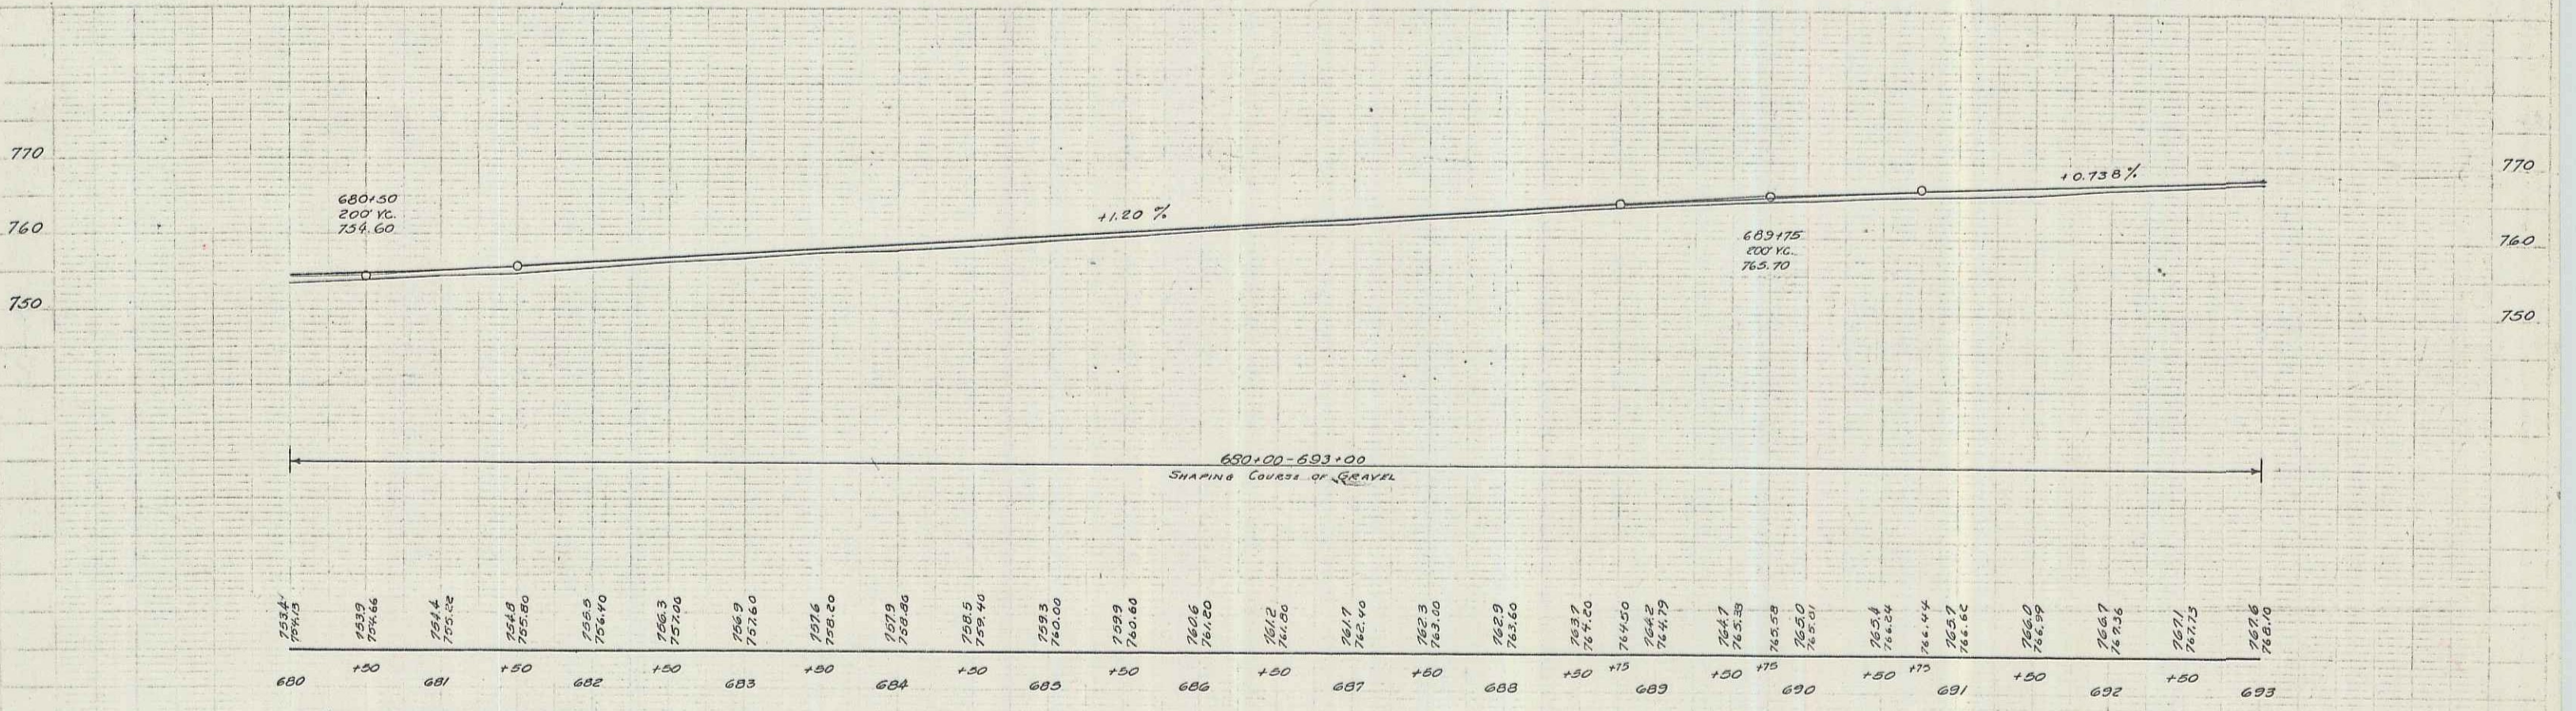


Arthur Hayward  
 Engineer - Surveyor

Barthelme  
 Surveyor

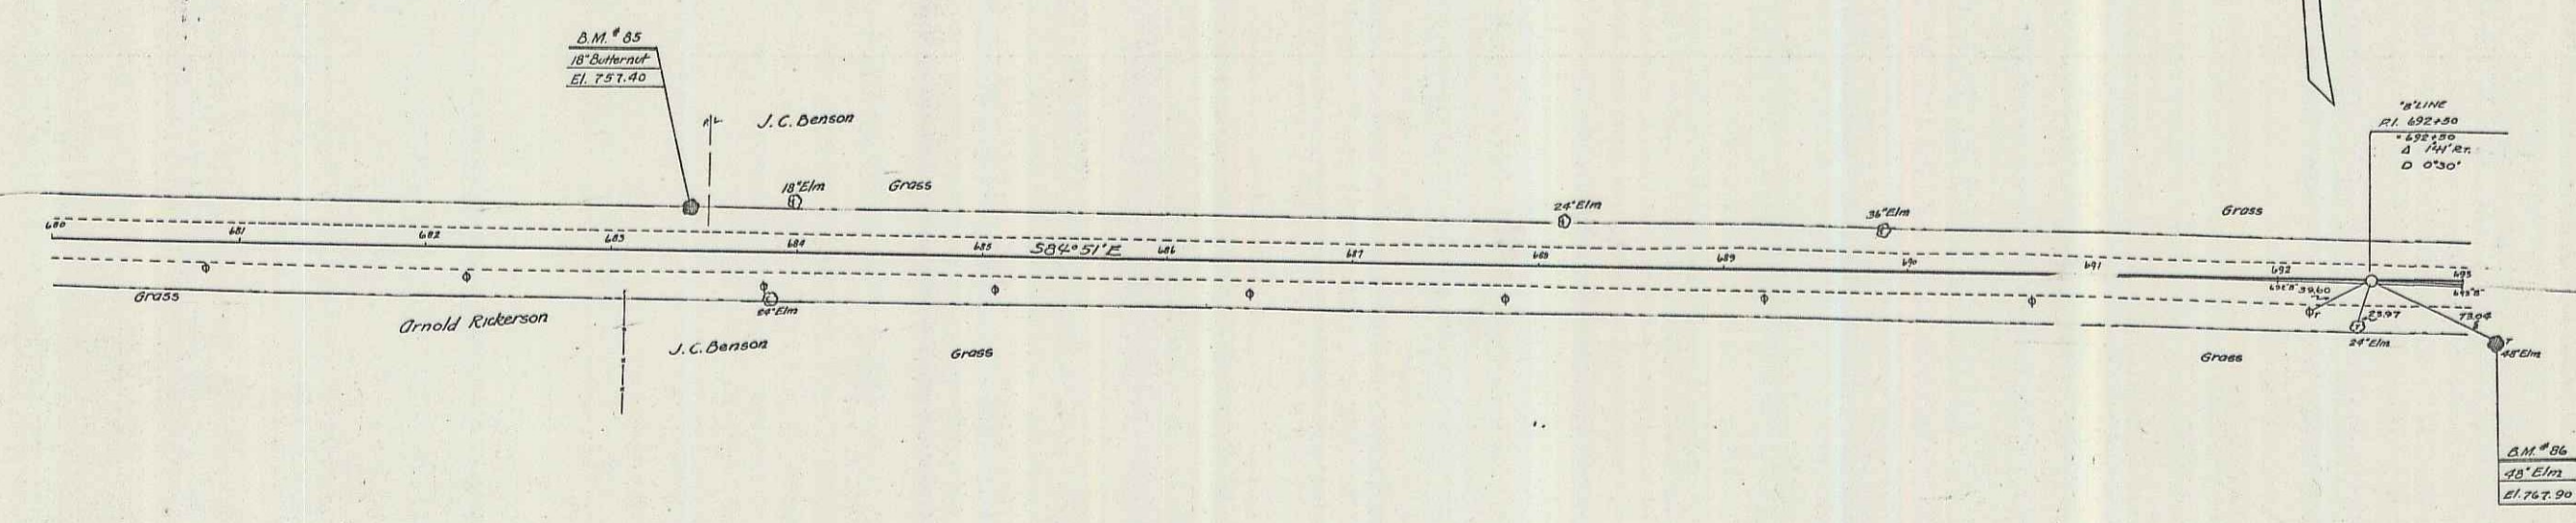

D.M.#05 SPIKE IN ROOT 18" BUTTERNUT 2017.17.51A 683+14 EL 757.40  
 D.M.#06 " " " 45" ELM 2017.17.51A 693+10 EL 767.90