


Parcel	Kind of Instrument	Date of Instrument	Grantor	Grantee	Recorded Stone	Remarks
A	R.C.D.	9-18-33	A.E. Ricketson	Stiff	PLAN PAGE DATE 29 109 121535	

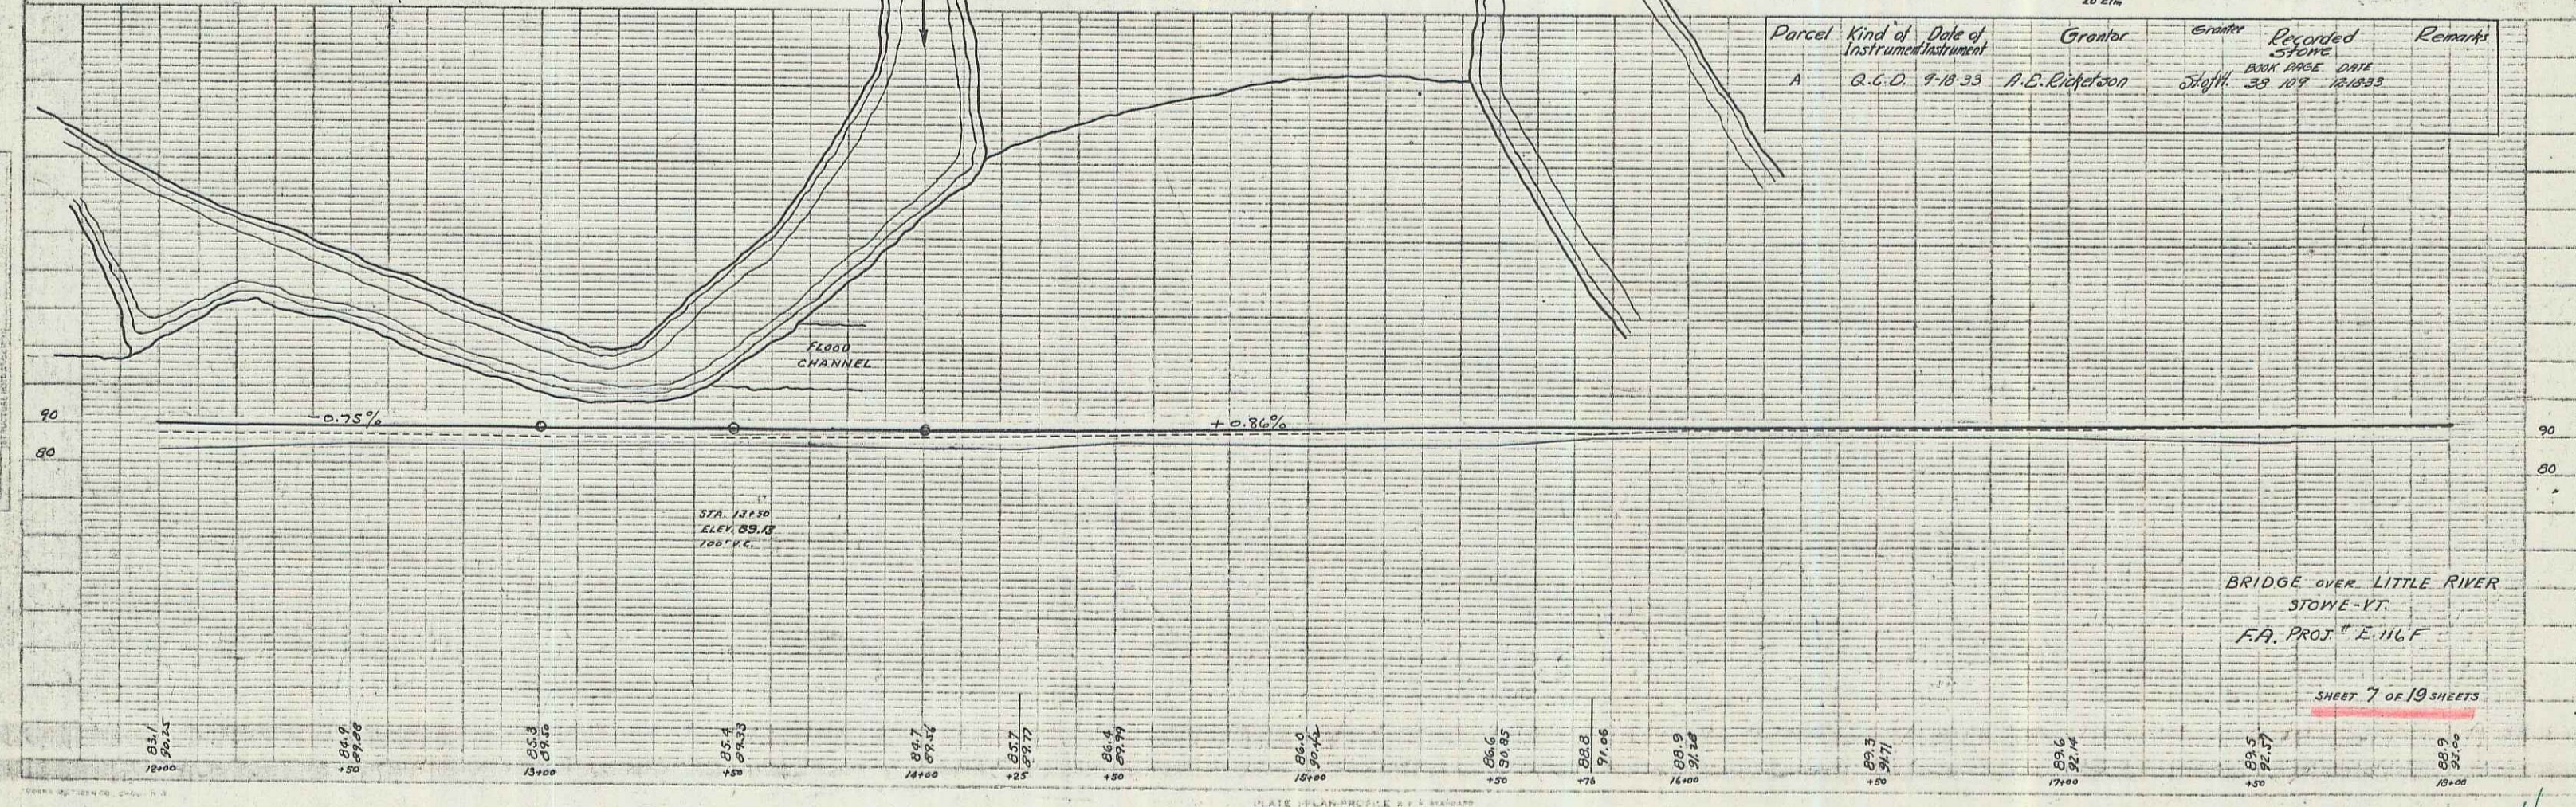

BRIDGE OVER LITTLE RIVER  
 STOWE - VT.  
 F.A. PROJ. # E. 116 F

SHEET 7 OF 19 SHEETS