

INDEX OF SHEETS

1. Title Page
2. Typical Sheet
3. Summary of Items and Drainage
4. Grades and Earthworks
5. Blank
6. Plan and Profile
7. B-5 Slope Grading 12/ 6/71
8. B-11 Slope Stabilization 12/ 8/71
9. E-3 Bridge Const. Approach Signs 12/14/71
10. E-5 Road Const. Betterment Project 12/14/71
11. E-6 On Project Const. Signs 12/14/71
12. G-9 Bridge Railing for Bridge Approaches 12/14/71
13. G-8a Connection Details, Bridge Appr. Railing and Standard Steel Beam Guard Rail 12/ 8/71
14. Standard Steel Beam Guard Rail Detail Sheet
15. Blank
- 16-17. SB-R1-71 Sheets 1 and 2 Bridge Rail Detail Sheet 8/24/71 10/ 5/71
18. SCB-D1-71 General Information 1/24/72
19. SCB-06-71 Details A, B and F Const. Details 12/14/71
20. SCB-08-71 Detail A, Bearing Device 12/14/71
21. SCB-09-71 Detail A, Curtain Walls 12/14/71
- 22-31. SR 100 Series
- 32-36. Cross Sections

RECORD PLANS

**MATERIALS** TYPE PAVEMENT AREA  
 2"-4" BITUMINOUS CONC. 5213 SY.  
 SUBBASE OF GRAVEL—PERCY PIT—MORRISTOWN, VT.  
 BITUMINOUS CONCRETE—L.M. PIKE—WILLISTON, VT.  
 MEMBRANE WATERPROOFING—BURLINGTON INDUSTRIES—BURLINGTON, MA.  
 METAL CULVERT PIPE—NORTHEASTERN CULVERT CORP.—WESTMINSTER, VT.  
 ALUMINUM & STANDARD STEEL BEAM GUARD RAIL—GRISWOLD FENCE CO.—WILLISTON, VT.  
 TAR EMULSION—COPELAND SEALER—COPELAND, CT.  
 CONCRETE CLASS A & B—A.G. ANDERSON READY MIX—WATERBURY, VT.  
 STEEL PILING, STRUCTURAL STEEL & BRIDGE RAILING—VERMONT STRUCTURAL STEEL CORP.—BURLINGTON, VT.  
 REINFORCING STEEL—PIONEER VALLEY STEEL CO. INC.—GREENFIELD, MA  
 BRIDGE PAINT—BURGESS FOBES PAINT CO.—PORTLAND, ME.  
 WATER REPELLENT—KIBBY EQUIPMENT CO.—WHITE RIVER JUNCTION, VT.  
 EPOXY BONDING COMPOUND & EPOXY MORTAR COMPOUND—DURAL INTERNATIONAL CORP.—DEER PARK, N.Y.

CONTRACTOR  
 BRIDGES INC.  
 MONTPELIER, VT.  
 RES. ENG.—DONALD E. BURBANK.  
 RECORD PLANS—A.G. SPIDLE.

CONTRACT  
 DATED—MAY 30, 1972.  
 STARTED—MAY 30, 1972.  
 COMPLETED—NOVEMBER 3, 1972.  
 ACCEPTED—NOVEMBER 3, 1972.

STATE OF VERMONT  
 DEPARTMENT OF HIGHWAYS




PROPOSED IMPROVEMENT

BETTERMENT PROJECT

TOWN OF STOWE  
 COUNTY OF LAMOILLE  
 VT. ROUTE 100

BEGINNING AT A POINT APPROXIMATELY 1.065 MILES  
 SOUTHWESTERLY OF THE MORRISTOWN—STOWE  
 TOWN LINE AND EXTENDS NORTHEASTERLY 0.226  
 MILES.

LENGTH OF ROADWAY 1149.89 FEET = 0.216 MILES  
 LENGTH OF BRIDGE 54.05 FEET = 0.010 MILES  
 LENGTH OF PROJECT 1195.94 FEET = 0.226 MILES

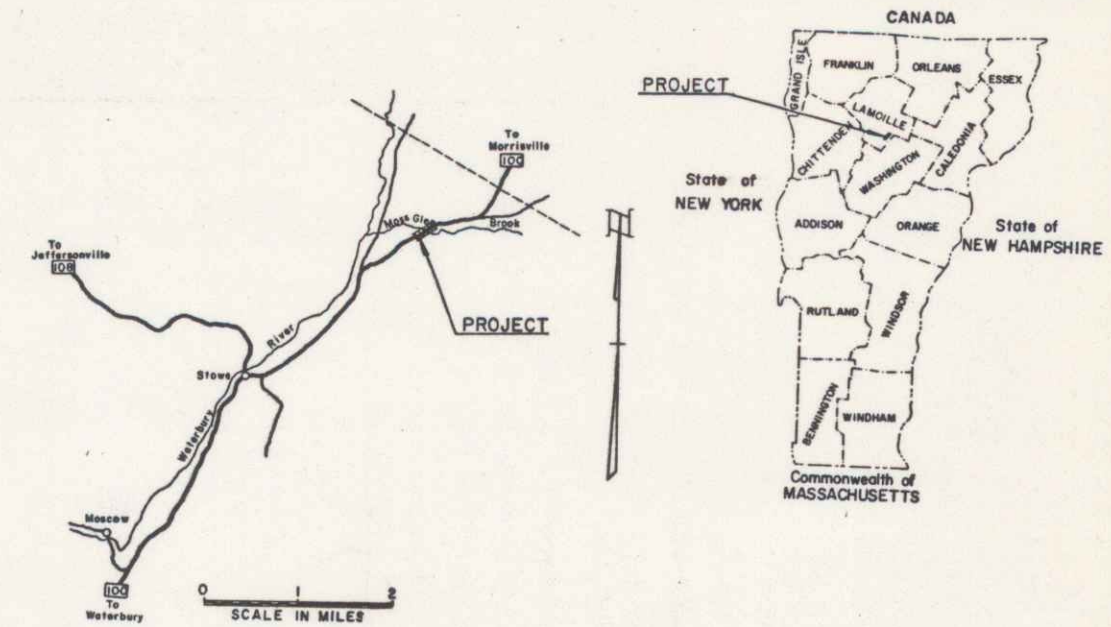


MP 5.85  
 RIGHT-OF-WAY DIVISION  
 TOWN FILE  
 PERPETUAL  
 Town of Stowe  
 (To Be Returned To R.O.W. Division)

NOTE: ANY FURTHER INFORMATION CONCERNING  
 FINAL QUANTITIES, AMOUNTS OR OTHER DETAILS  
 RELATIVE TO THIS PROJECT MAY BE FOUND IN  
 EITHER THE FIELD BOOKS OR THE ESTIMATE  
 FILE.

CONVENTIONAL SIGNS

- COUNTY LINE
  - TOWN LINE
  - LIMITS OF ACCESS
  - POINT OF ACCESS
  - FENCE LINE
  - STONE WALL
  - TRAVELED WAY
  - GUARD RAIL
  - RAILROAD
  - SURVEY LINE
  - CULVERT
  - POWER POLE
  - TELEPHONE POLE
  - TREES
  - BP CONST. IDENTIFICATION SIGNS
  - PROPERTY LINE
  - R.O.W. TAKING LINE
  - SLOPE RIGHTS
  - TOP OF CUT
  - TOE OF SLOPE
- CONTRACTOR—BRIDGES, INC.  
 MONTPELIER, VT.  
 RECORD PLANS—A.G. SPIDLE.  
 CONST. COMPLETED—NOVEMBER 3, 1972.

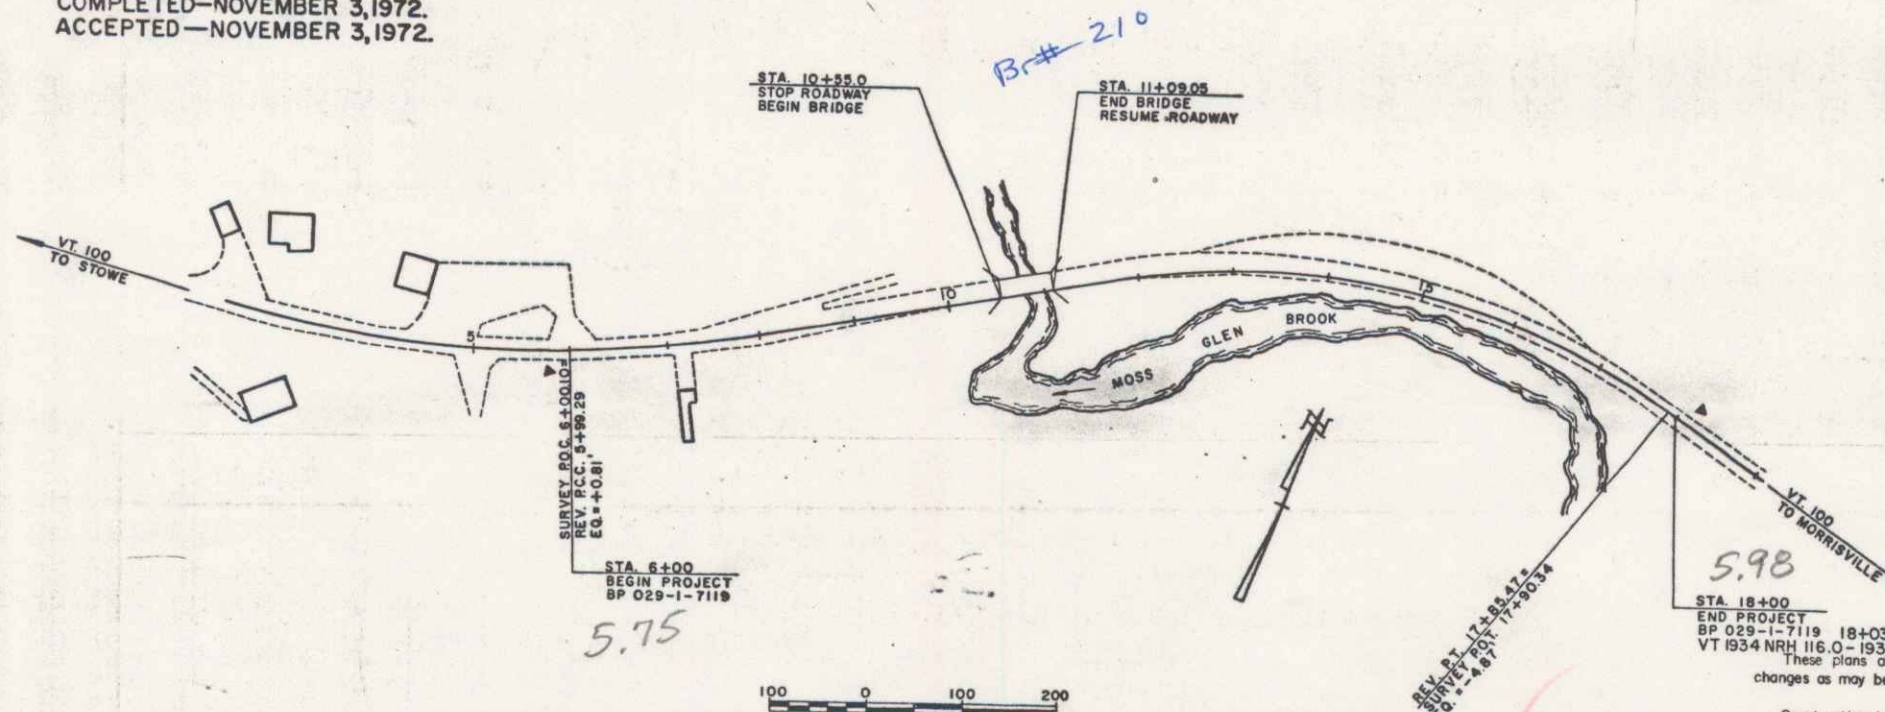

TOWN: STOWE  
 ROUTE: VT 100  
 DATE: 04-11-1972  
 PROJECT: BP 029-1-7119  
 P.N. CORG 84

Construction is to be carried on in accordance  
 with these plans and the Standard Specifications  
 for Highway and Bridge Construction dated  
 January 3, 1972 as approved by THE FEDERAL HIGHWAY  
 ADMINISTRATION ON December 28, 1971 for use on  
 this project, including all subsequent revisions and  
 such revised specification and special provisions as  
 are incorporated in these plans.

SUBMITTED BY ORDER OF THE STATE HIGHWAY BOARD

APPROVED: *ROM* DATE 4-11-72  
 ACT. CHIEF ENGINEER

PROJECT BP NO 029-1-7119

SHEET 1 OF 36 SHEETS

D-10 SRS 12/17/70