


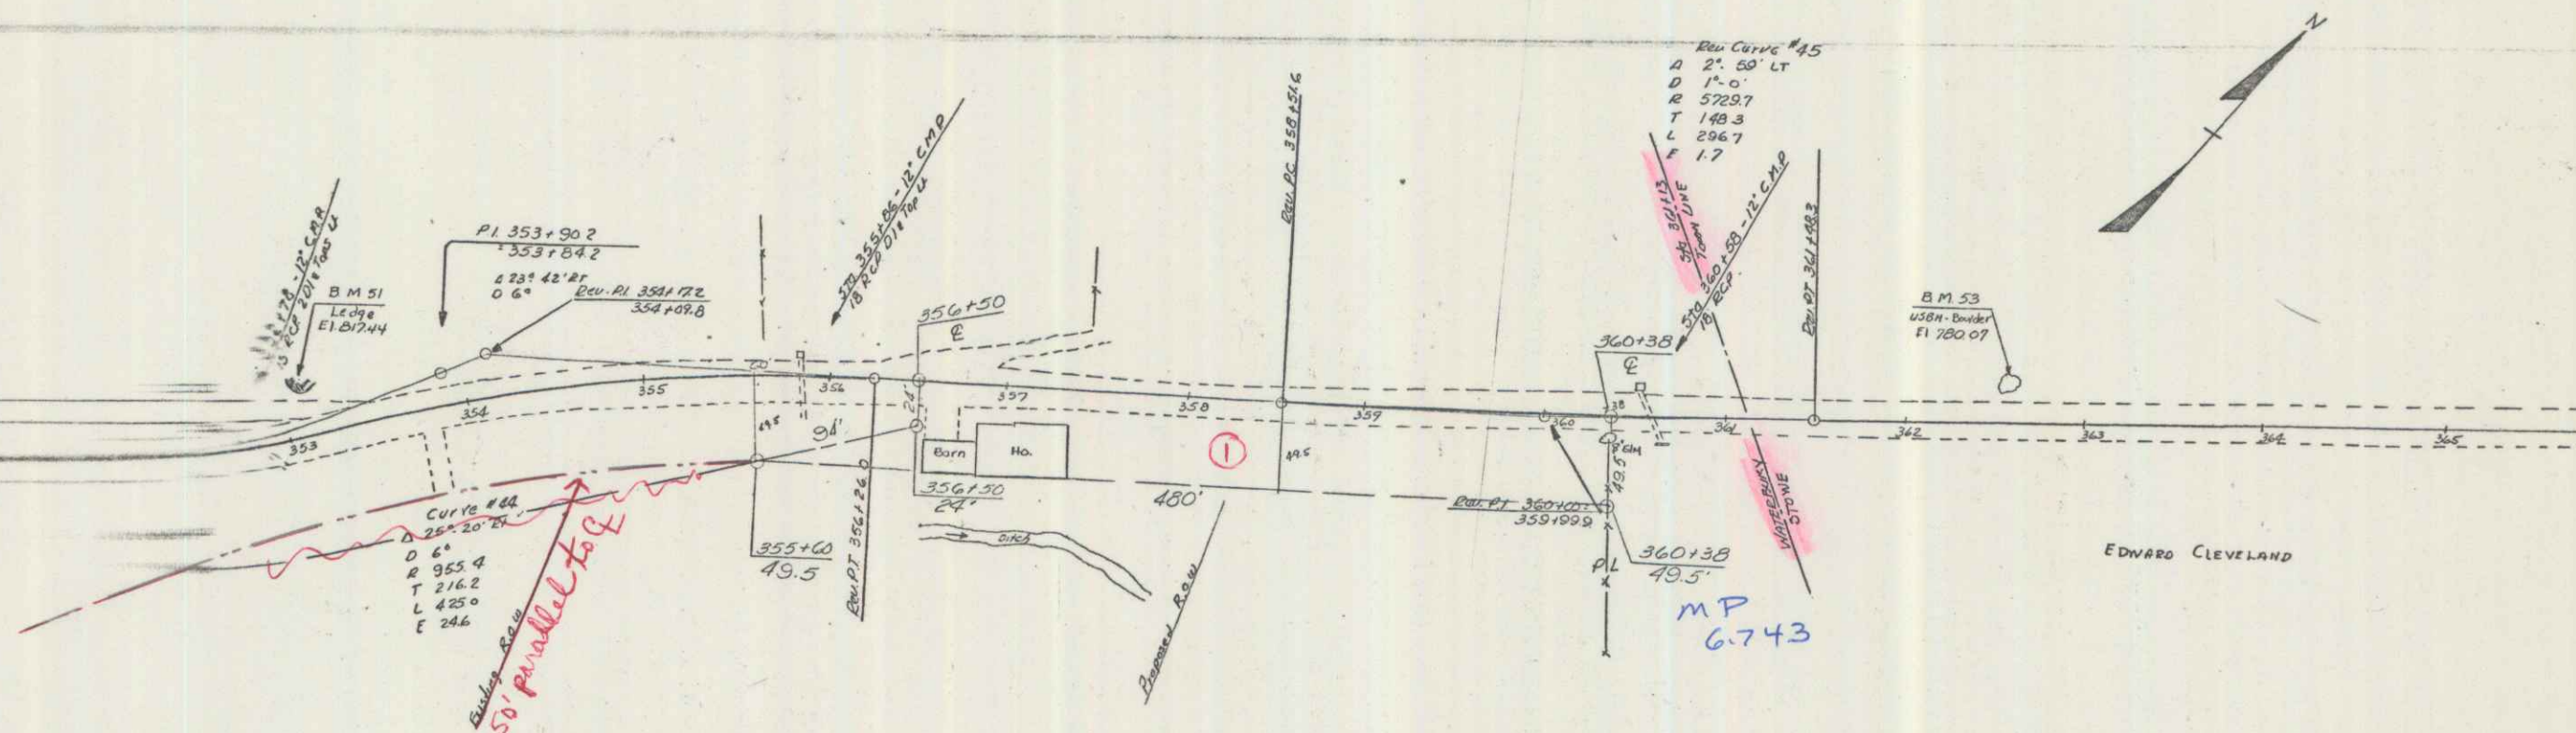

R O W PLANS
TOWN OF WATERBURY
 COUNTY OF WASHINGTON
 VT ROUTE 100

BEGINNING EIGHTY (80) LINEAR FEET SOUTH OF THE
 STOWE-WATERBURY TOWN LINE AND EXTENDING SOUTH
 FOUR HUNDRED TWELVE FEET (412').

ROUTE: VT 100
 PIN: 100R685

Parcel #1 - 0.55 AT acquired from Ralph H. & Lila M. Marshall
 by WD 6/13/68
 Recorded in BK 64, Pg 460, Waterbury

Note: R. C. & J. Lewis determined
 the row between 353+00 R/L to
 355+00 ft is 50'. The
 above 0.55 AT covers from
 355+60 to 360+38 from Q to
 49.5' Rt.

RIGHT-OF-WAY DIVISION
 TOWN FILE
 PERPETUAL

Rte of VT 100
 (To Be Returned To R.O.W. Division)

STATE OF VERMONT
 DEPARTMENT OF HIGHWAYS

TOWNS OF WATERBURY - STOWE
 ROUTE NO. 100 LOG STA. _____

SCALE 1" = 60'

SURVEYED BY _____
 DRAWN BY PEARL CHECKED BY _____

PROJECT NO. MA 539-4280-312-67
 SHEET 2 OF 2

APPROVED <u>H. P. Ruggan</u> DATE <u>6-23-67</u>	APPROVED <u>E. W. Stebbins</u> DATE <u>6/15/67</u>	APPROVED <u>R. F. Jones</u> DATE <u>6/18/67</u>	APPROVED <u>G. W. Lane</u> DATE <u>June 15, 1967</u>	APPROVED <u>R. H. Curren</u> DATE <u>6/16/67</u>
PLANNING ENGINEER	ASSIST. CHIEF ENGINEER	DISTRICT ENGINEER	REGIONAL ENGINEER	CHIEF ENGINEER