


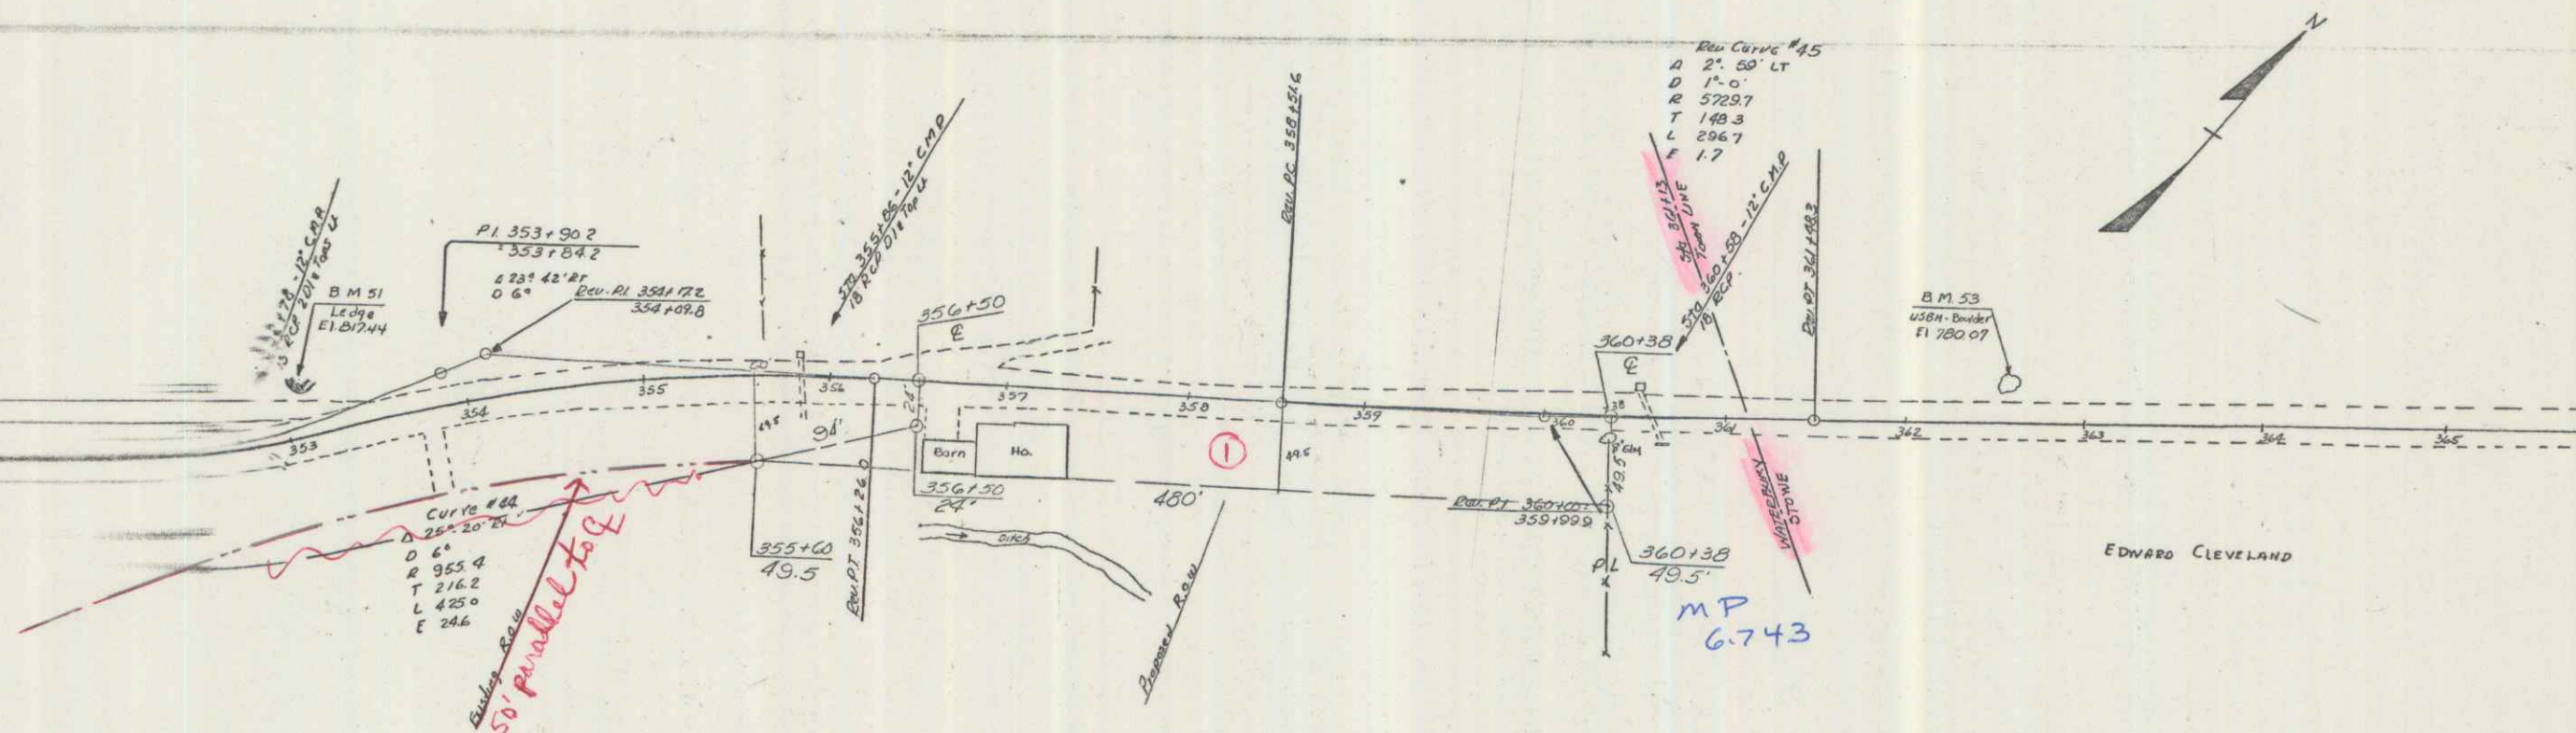

ROW PLANS
TOWN OF WATERBURY
COUNTY OF WASHINGTON
VT ROUTE 100

BEGINNING EIGHTY (80) LINEAR FEET SOUTH OF THE
STOWE-WATERBURY TOWN LINE AND EXTENDING SOUTH
FOUR HUNDRED TWELVE FEET (412').

ROUTE: VT 100
PIN: 100R685

Parcel #1 - 0.55 AT acquired from Ralph H. & Lila M. Marshall
by WD 6/13/68
Recorded in BK 64, Pg 460, Waterbury

Note: R. C. & J. Lewis determined
the row between 353+00 R/L to
355+00 ft is 50'. The
above 0.55 AT covers from
355+60 to 360+38 from Q to
49.5' Rt.

RIGHT-OF-WAY DIVISION
TOWN FILE
PERPETUAL

Rte of VT 100
(To Be Returned To R.O.W. Division)

STATE OF VERMONT
DEPARTMENT OF HIGHWAYS

TOWNS OF WATERBURY - STOWE
ROUTE No. 100 LOG STA.

SCALE 1" = 60'

SURVEYED BY
DRAWN BY PEARL CHECKED BY

PROJECT NO. MA 539-4280-312-67
SHEET 2 OF 2

APPROVED DATE 6-23-67	APPROVED DATE 6/15/67	APPROVED DATE 6/15/67	APPROVED DATE 6/15/67	APPROVED DATE 6/15/67
PLANNING	DESIGN	DISTRICT ENGINEER	CHIEF ENGINEER	CHIEF ENGINEER