



PLAN
 SURVEYED BY
 CHECKED BY
 DATE
 NOTE: BOOK ELEMENT CHECKED BY
 FIELD NOTES BY

PROFILE
 SURVEYED BY
 CHECKED BY
 DATE
 NOTE: BOOK ELEMENT CHECKED BY
 FIELD NOTES BY

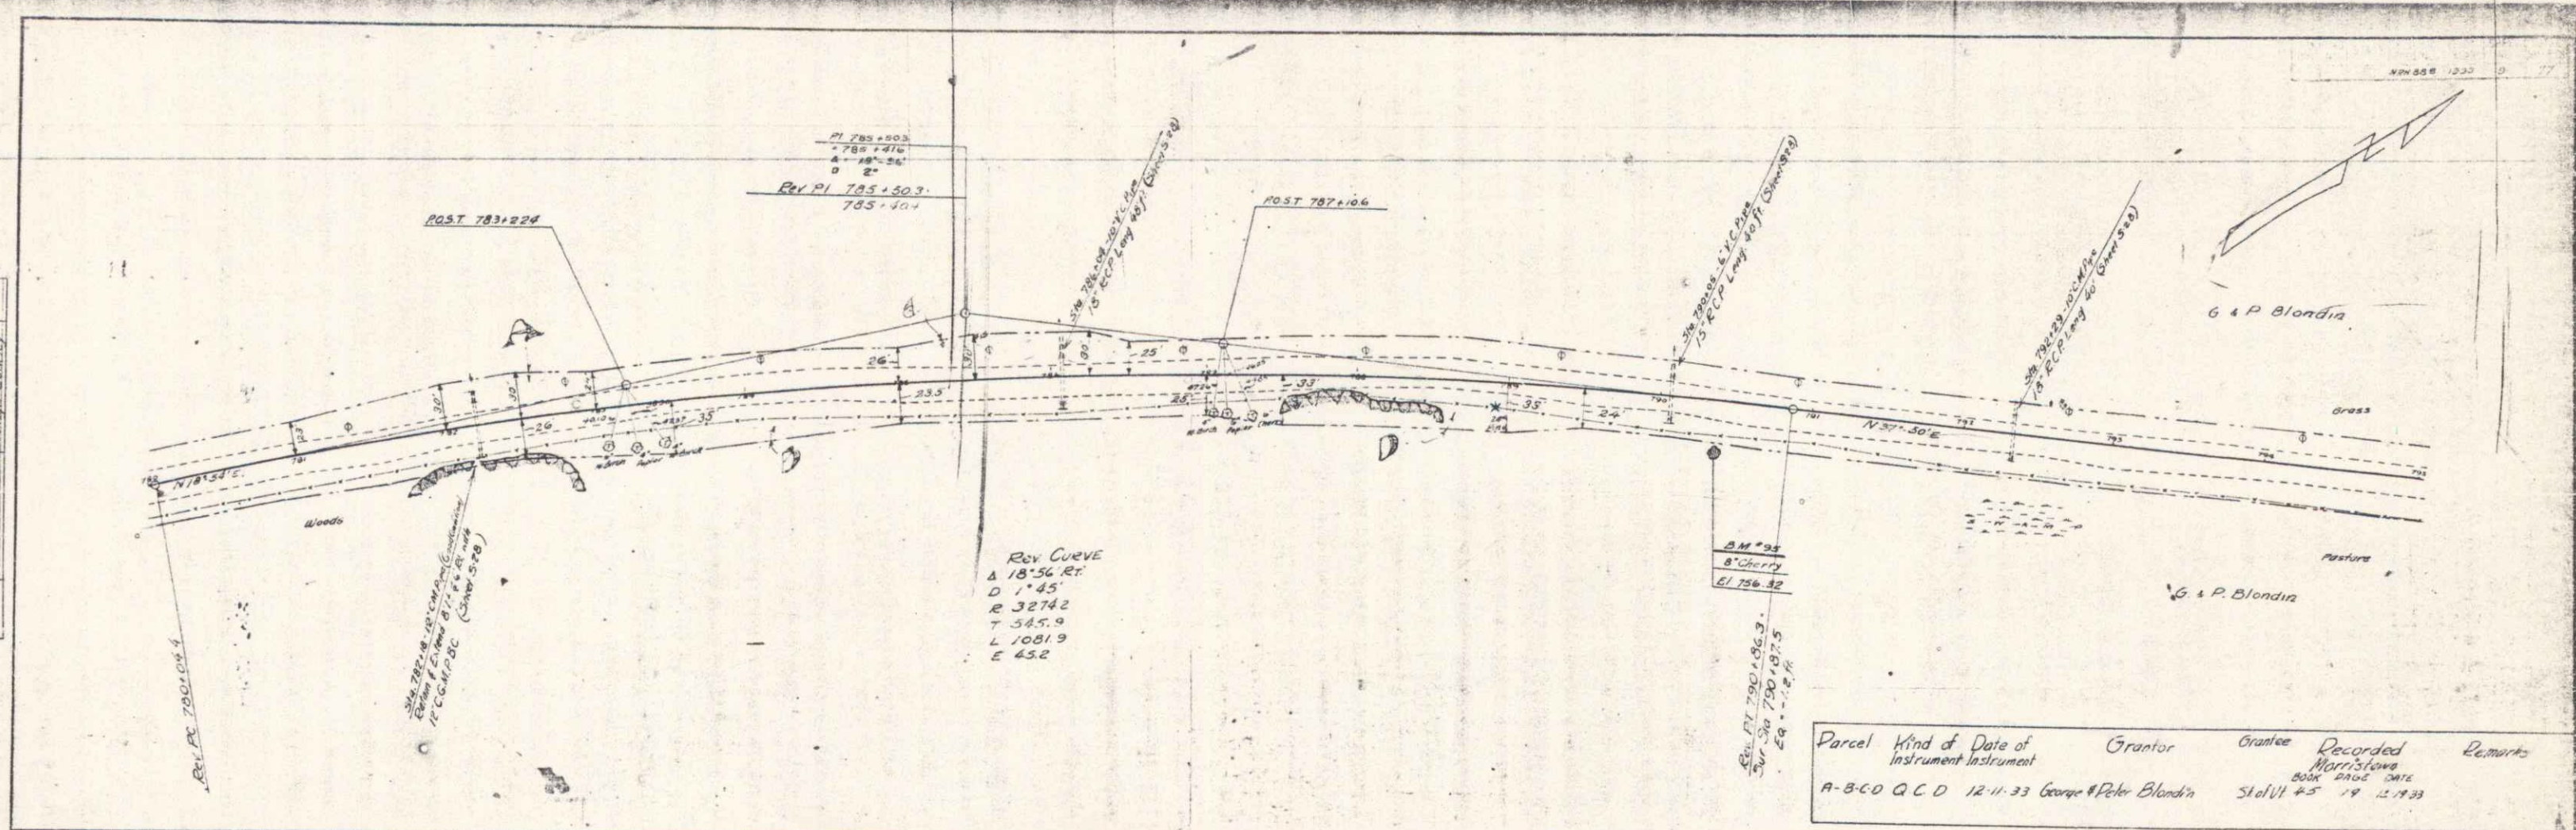

Parcel	Kind of Instrument	Date of Instrument	Grantor	Grantee	Recorded	Remarks
A-8-CO QCD		12-11-33	George & Peter Blondin	Stella	45	12-19-33

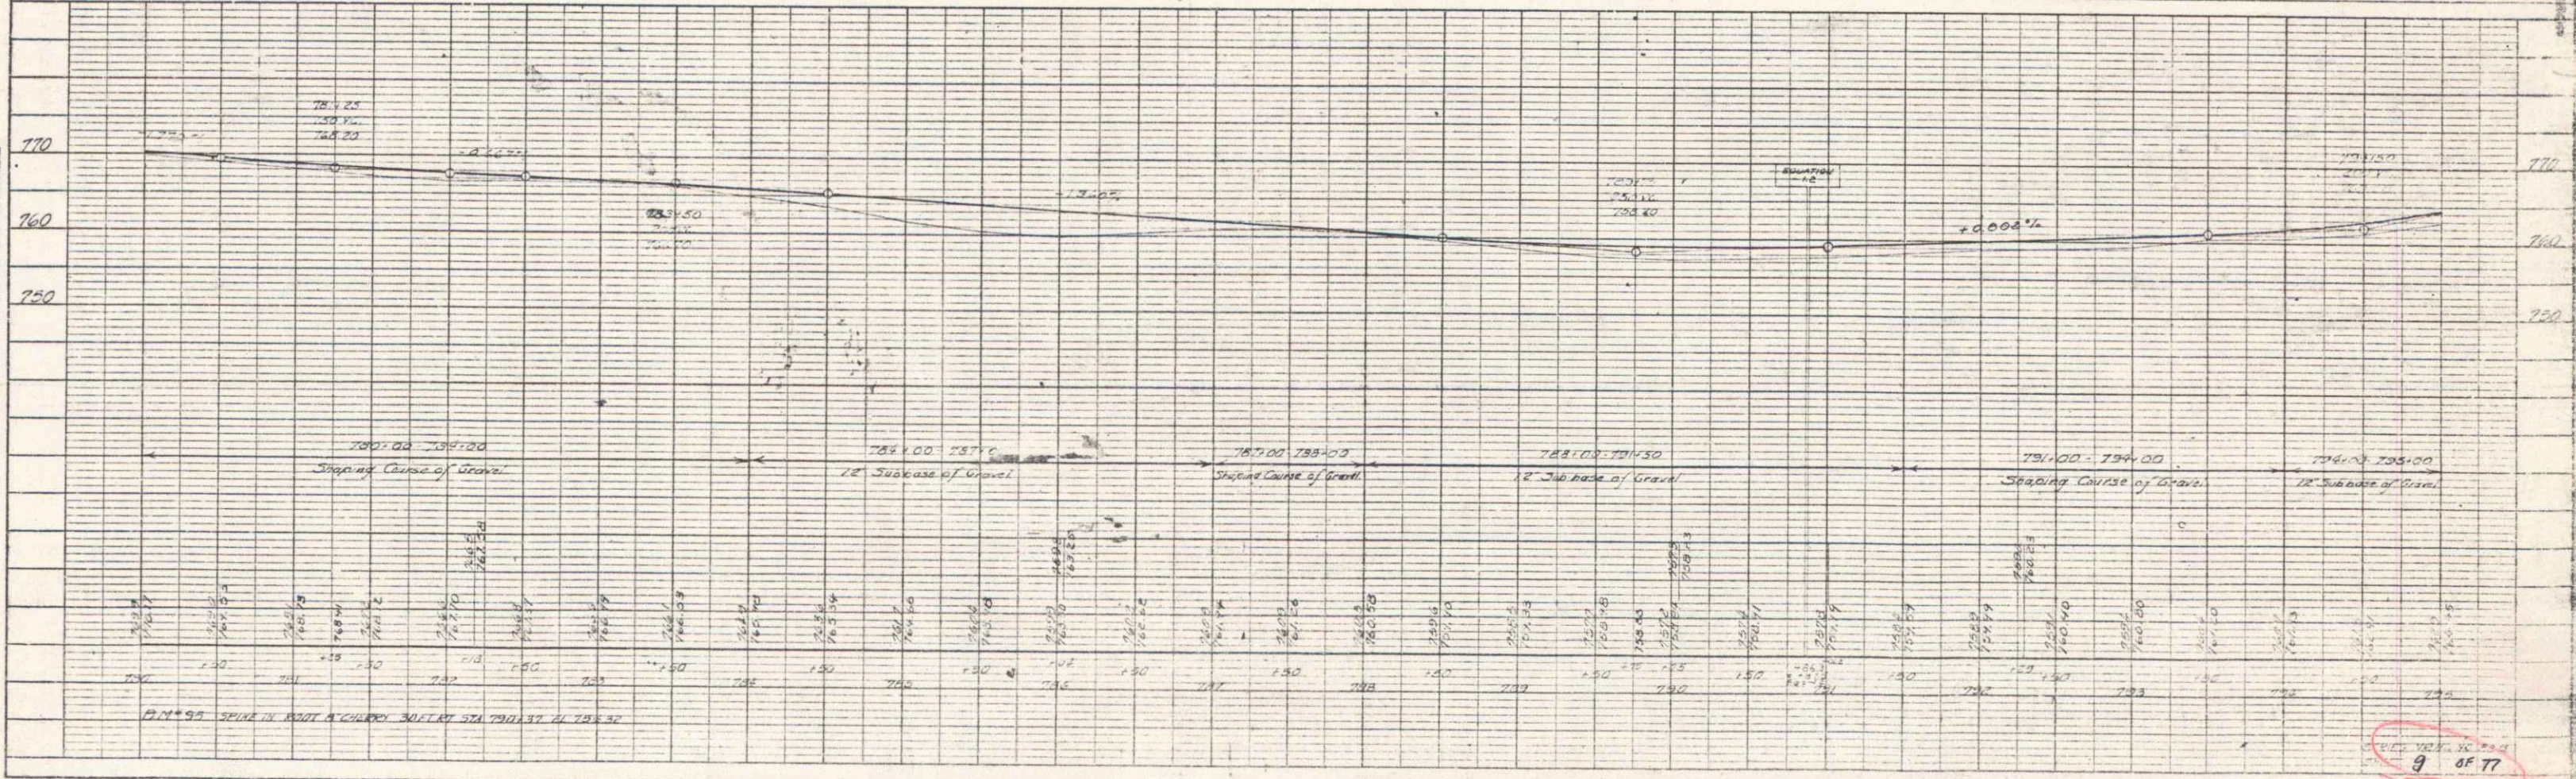

9 OF 77