



PLAN
 DATE: 10/15/33
 DRAWN BY: J. J. Sullivan
 CHECKED BY: J. J. Sullivan
 PROJECT: 104 828 1933

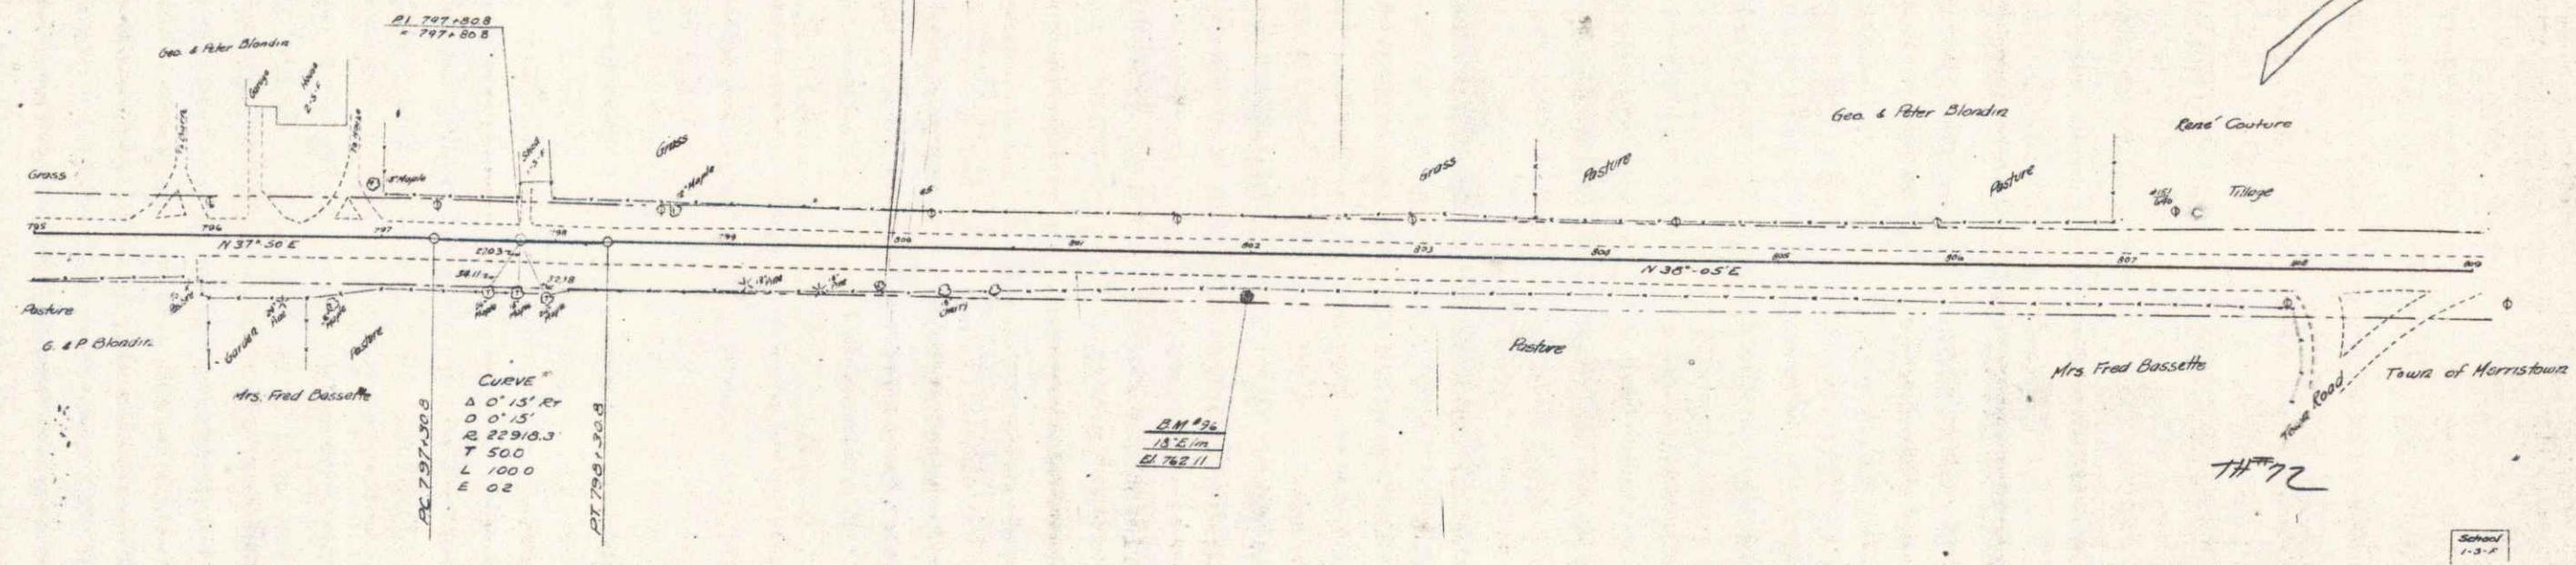

PROFILE
 DATE: 10/15/33
 DRAWN BY: J. J. Sullivan
 CHECKED BY: J. J. Sullivan
 PROJECT: 104 828 1933

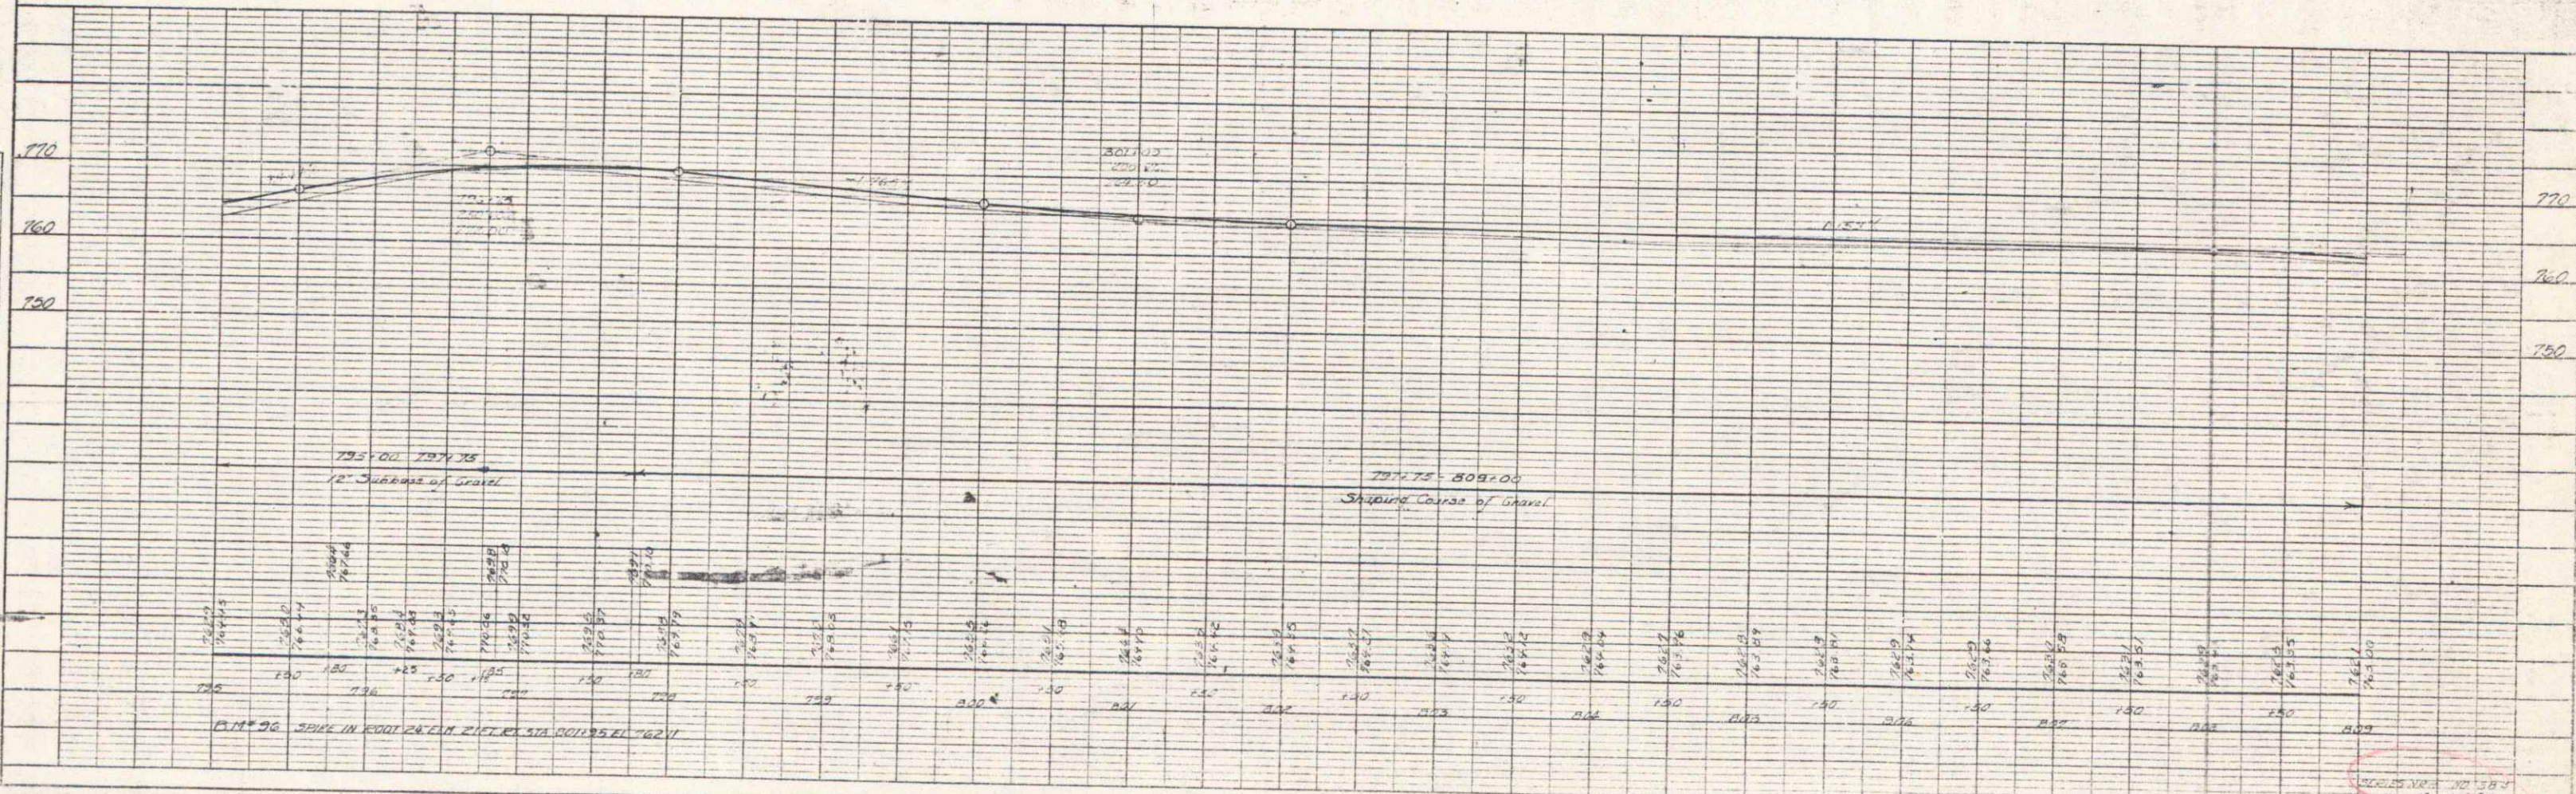

SCALE: 1" = 20' HORIZ.
 1" = 4' VERT.
 10 47 77