

PLAN
 DATE BOOK
 PROJECT NO.
 SHEET NO.

SECTION
 DATE BOOK
 PROJECT NO.
 SHEET NO.

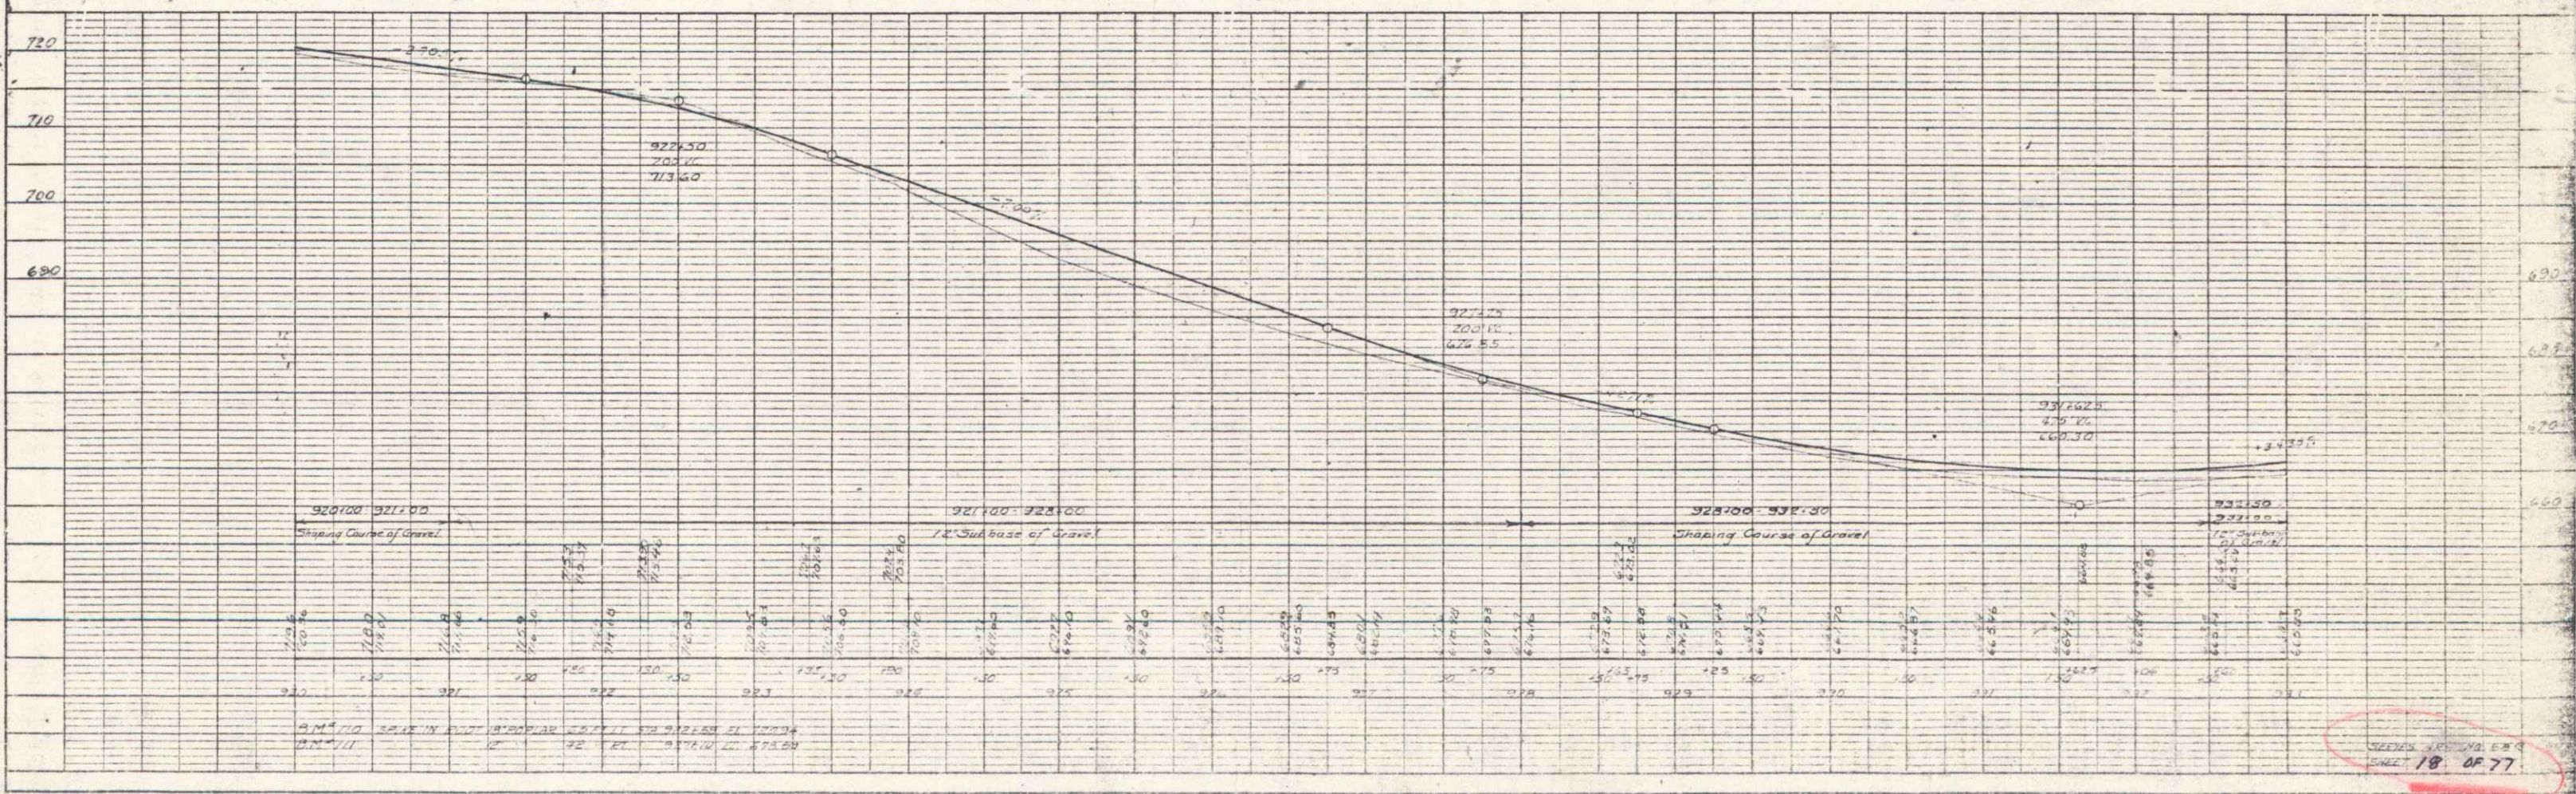
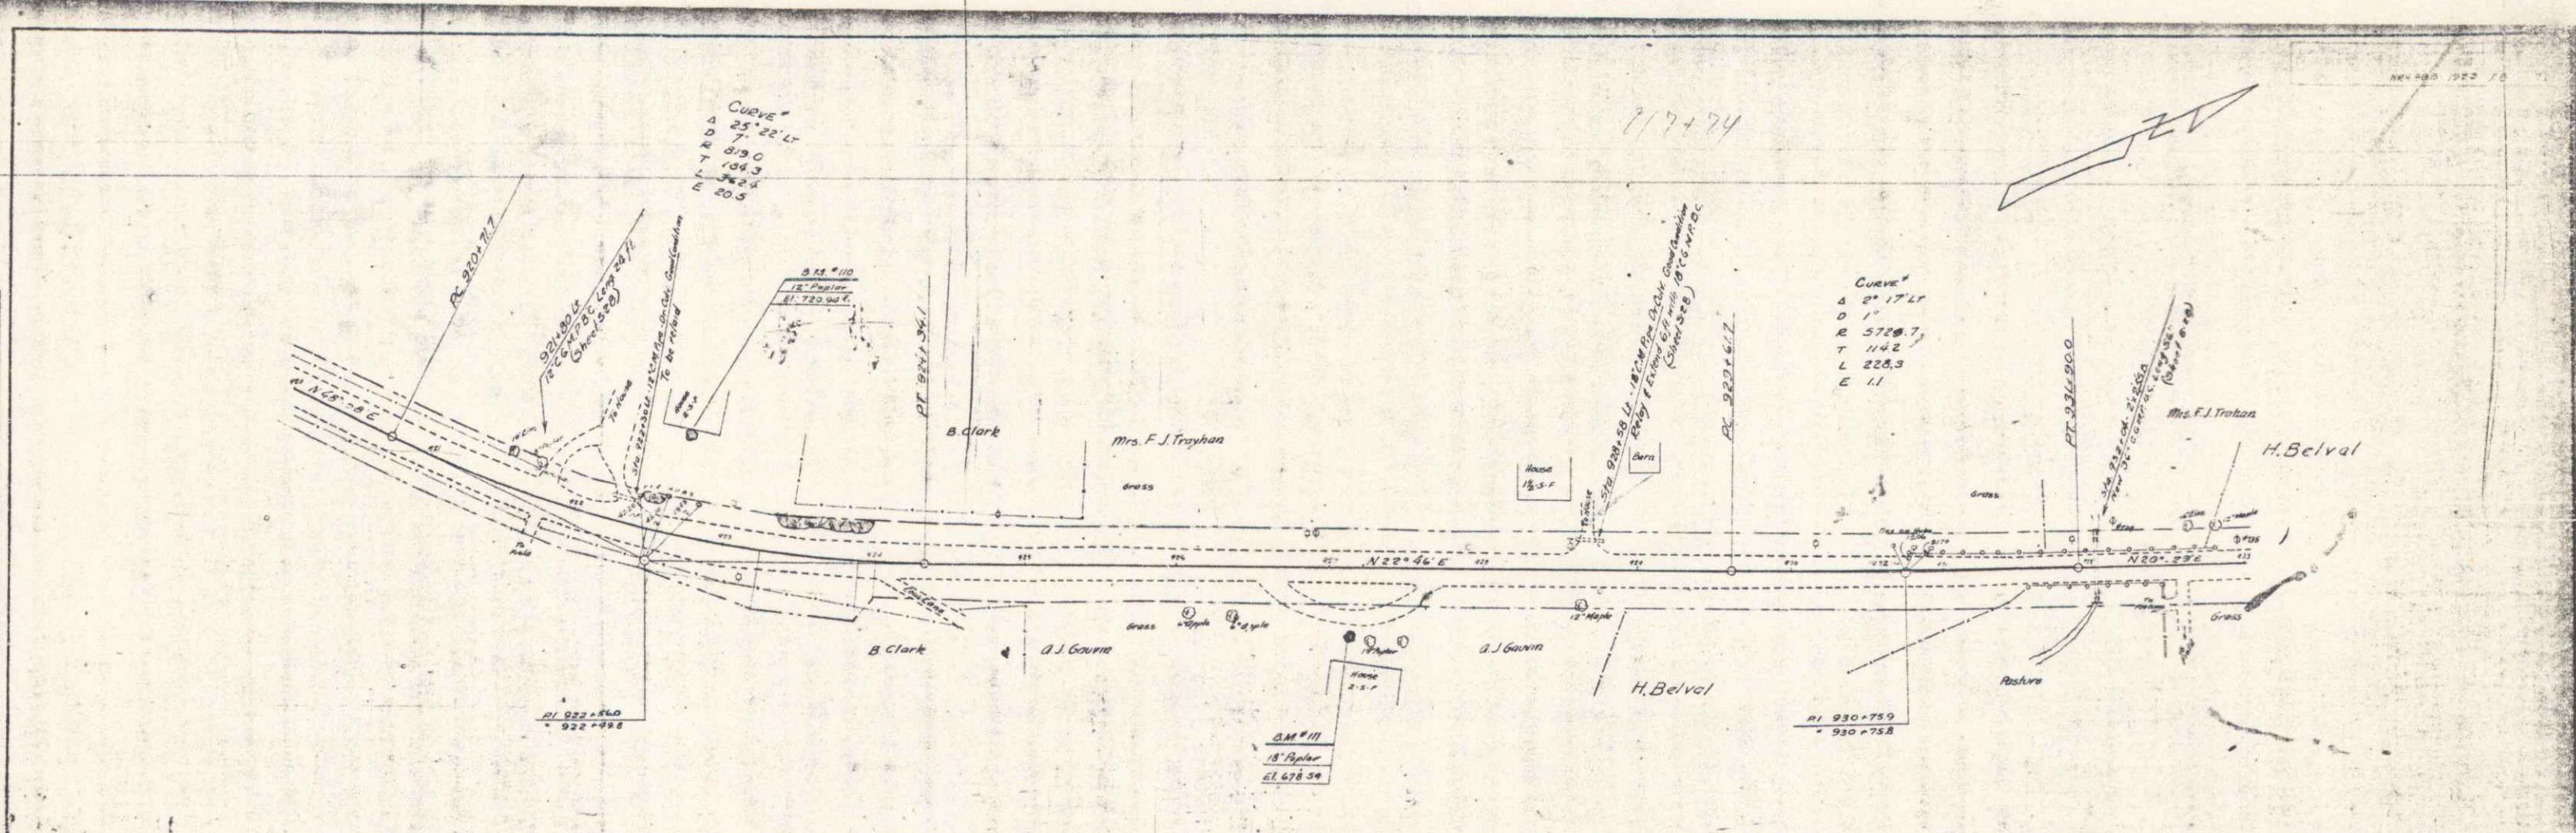


PLATE 1 - PLAN-PROFILE

DATE BOOK
 PROJECT NO.
 SHEET 18 OF 77