
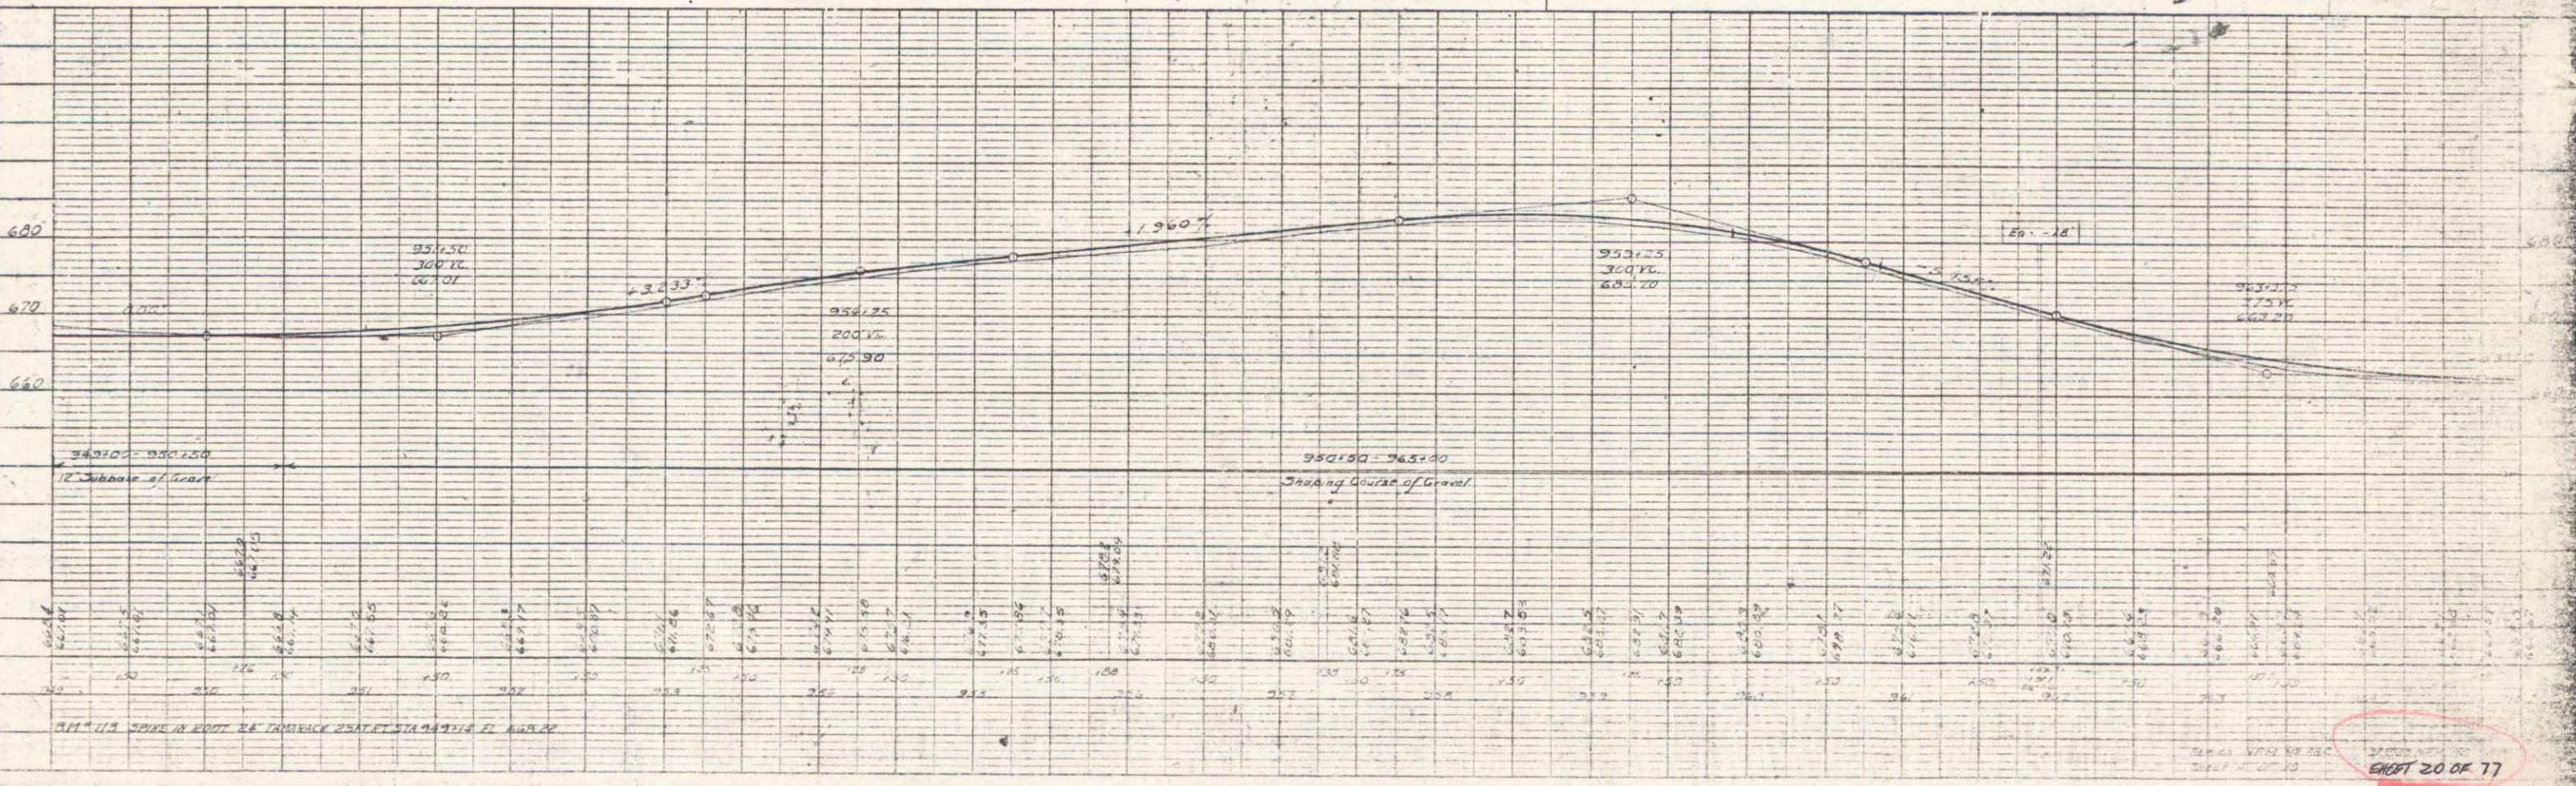


PLAN  
 DRAWN BY  
 CHECKED BY  
 DATE OF CHECK  
 NO.

PROFILE  
 DRAWN BY  
 CHECKED BY  
 DATE OF CHECK  
 NO.

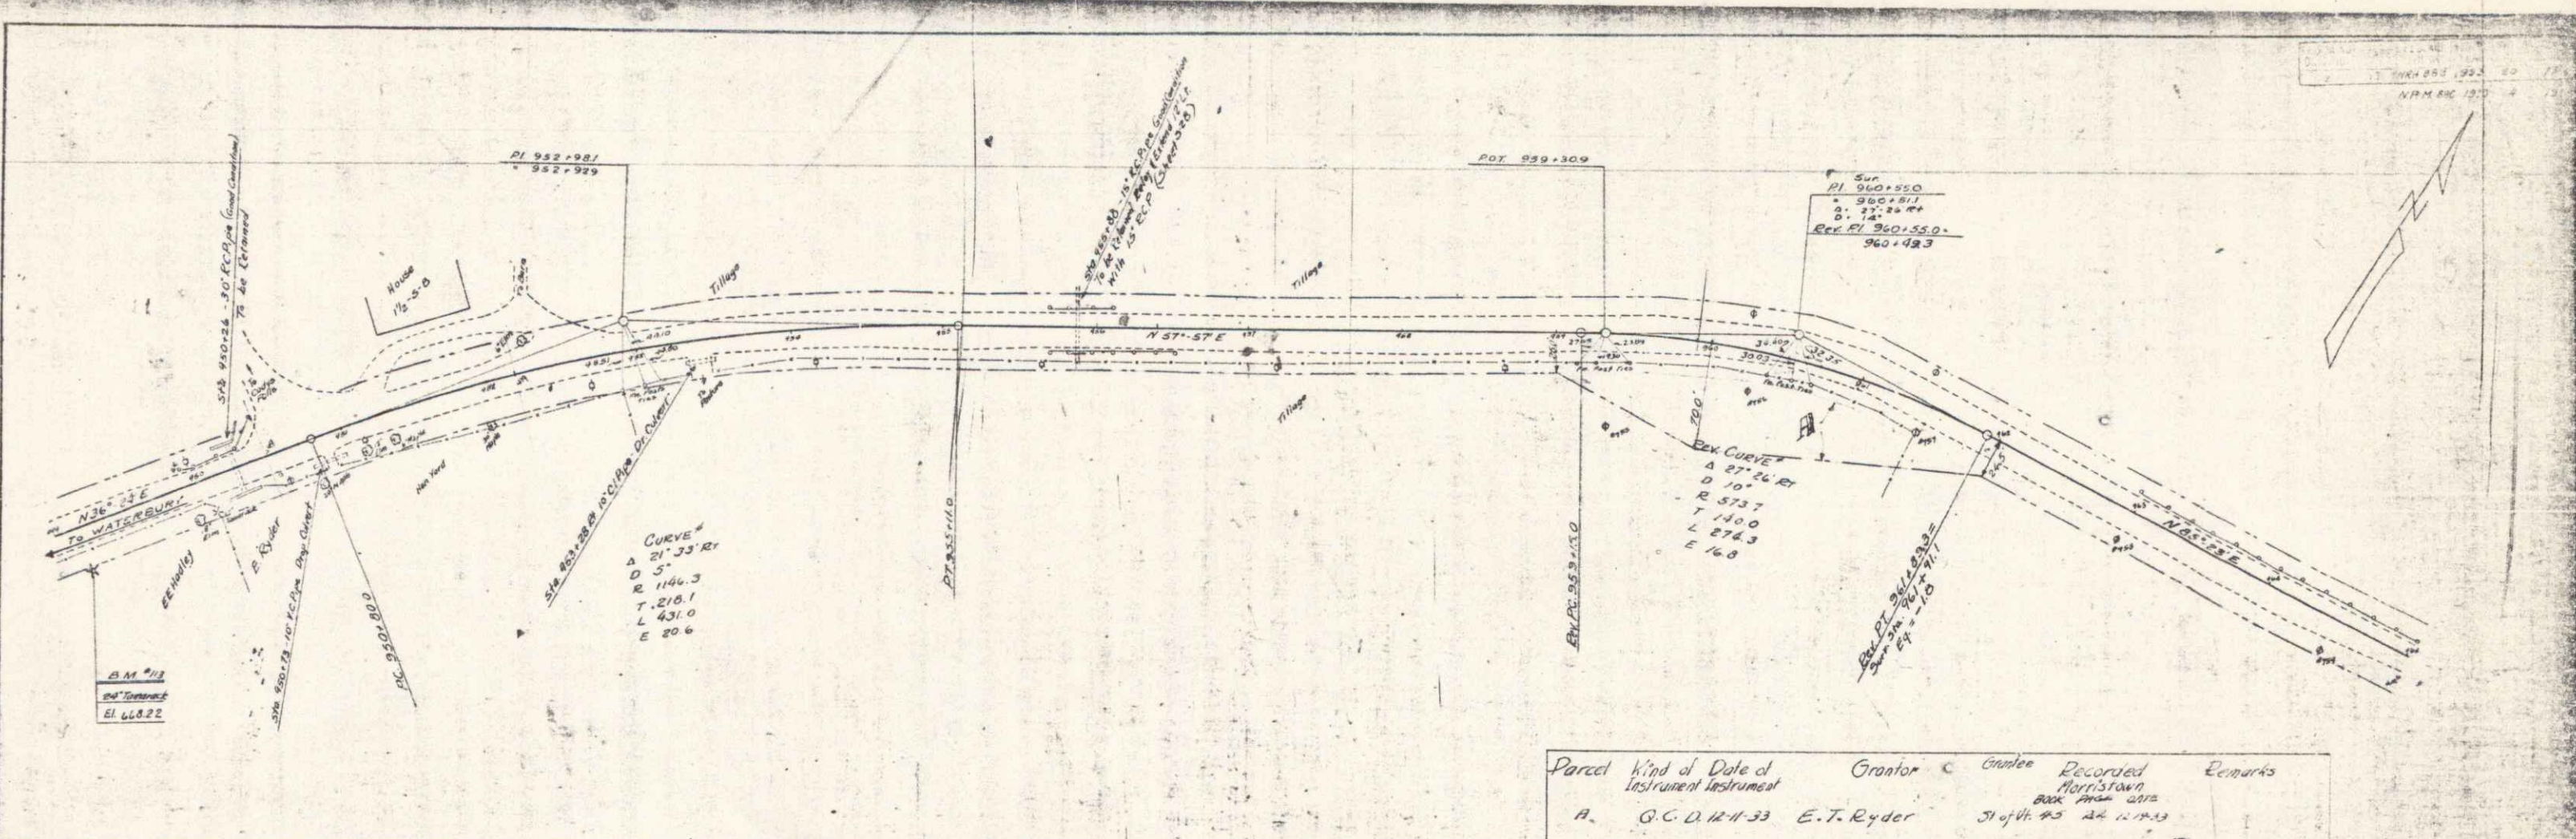

SHEET 20 OF 77