

POOR ORIGINAL COPY

CABLE GUARD RAIL REQUIRED

LEFT	Length 410 Lin Ft.
RIGHT	Length 582 Lin Ft.
TOTAL 992 Lin Ft.	

BRIDGE SURFACE COURSE REQUIRED



Sta 0+00 To 7+00 (less bridge 1219.00) 3.50 Cu. Yds.

80.9.1.200

See sheet #17

PLAN
Scale of 1" = 100'
Scale of 1" = 100'

VERTICAL
Scale of 1" = 10'
Scale of 1" = 10'

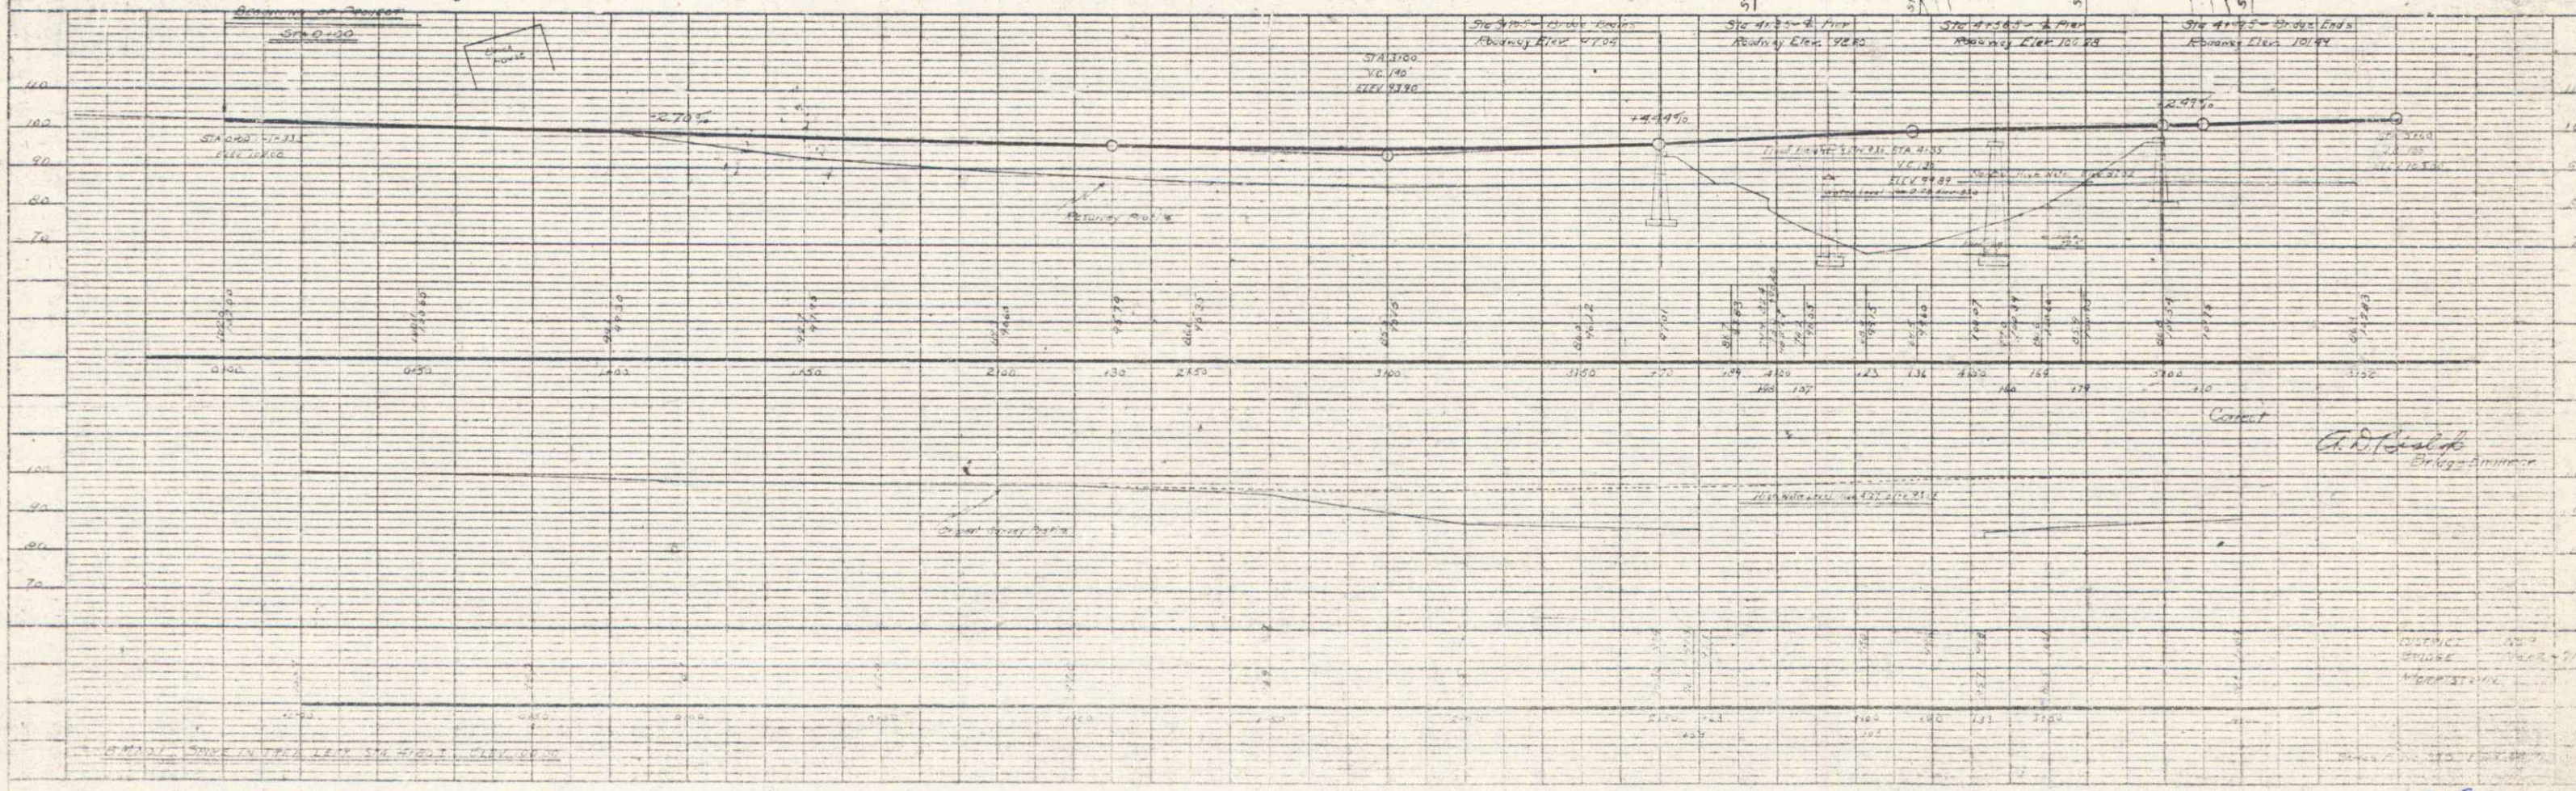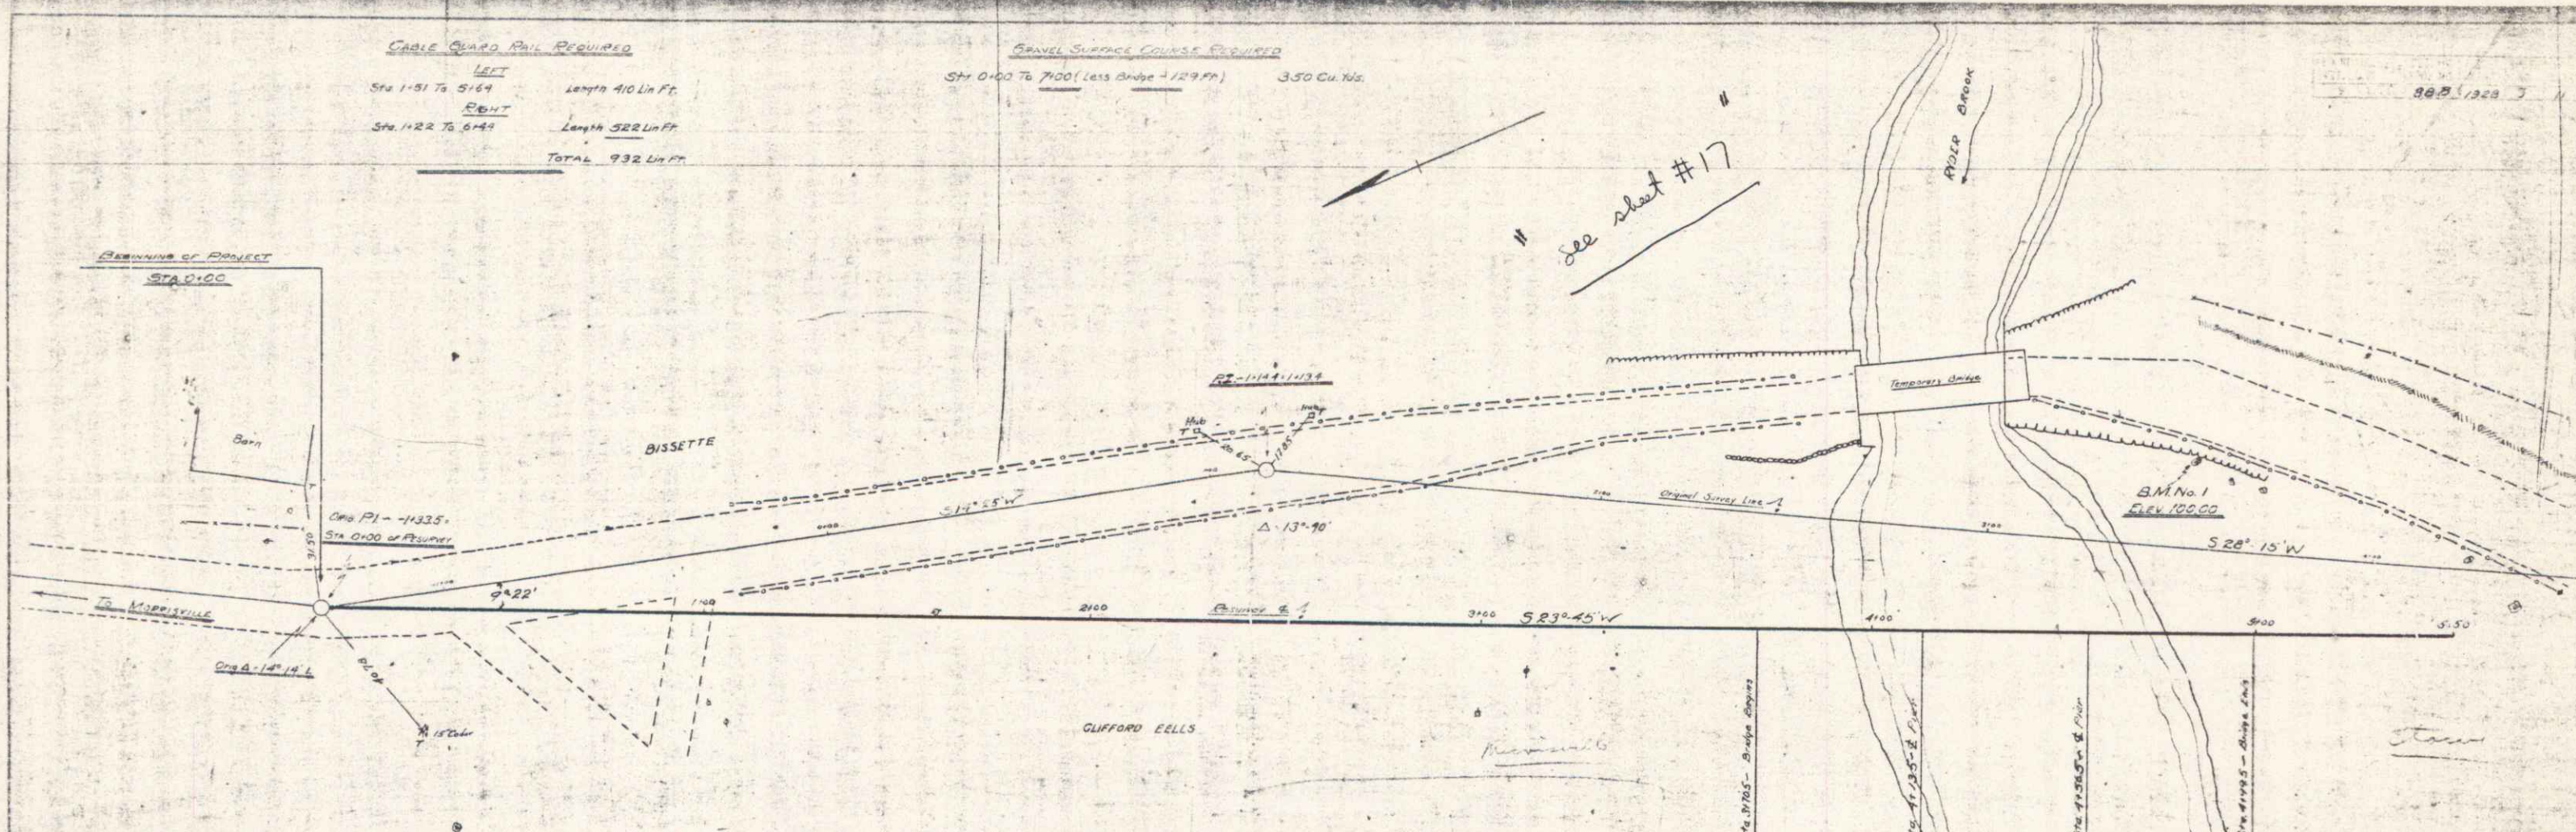

C. D. [Signature]