


001490
 NAT DIVISION
 H FILE
 PERPETUAL
 1500
 ded To R.O.W.
 TH H BURCHARDS

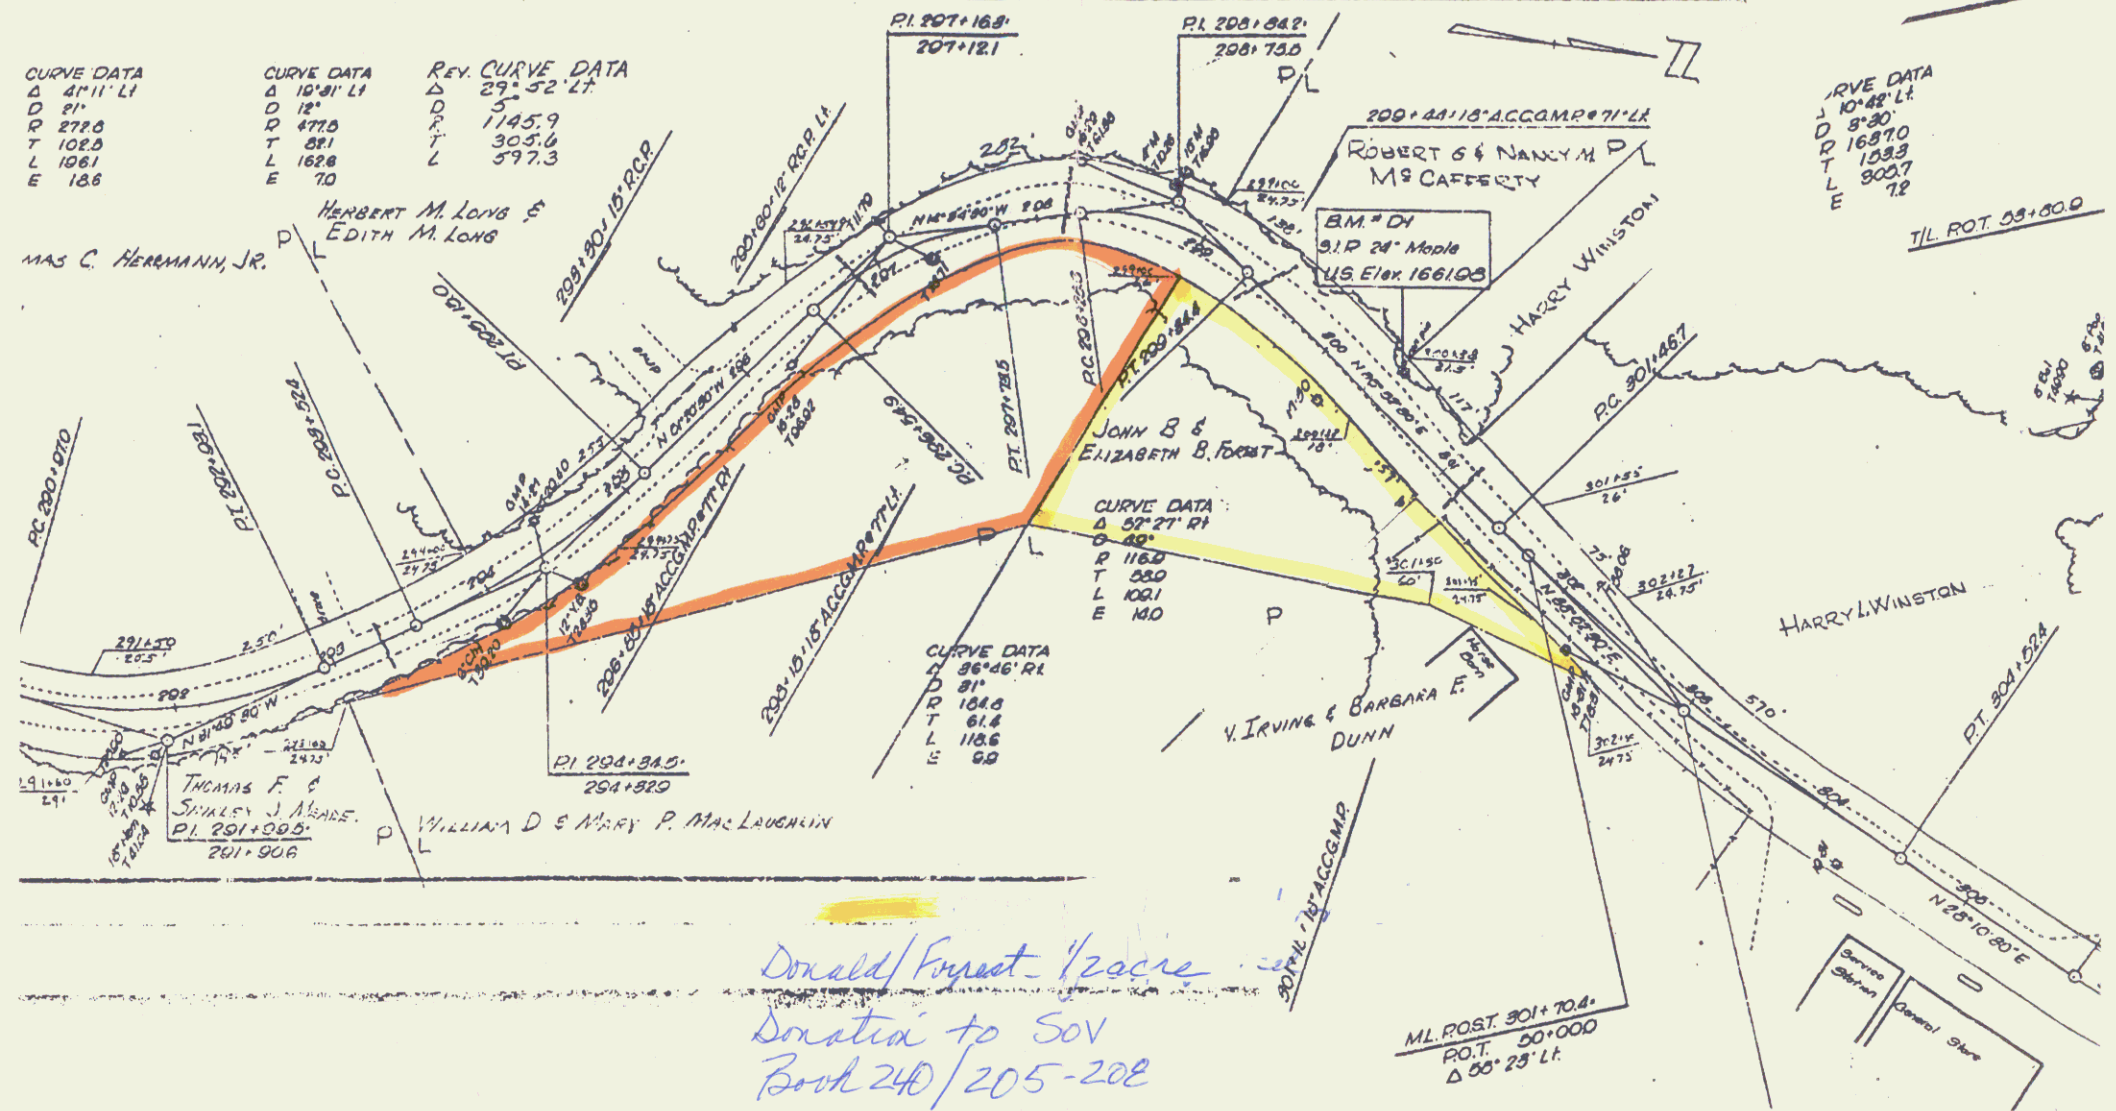

Donald/Forest - 1/2 acre
 Donation to SOV
 Book 240/205-208

SHEET 3A
 4