


CURVE DATA
 Δ 1437.24
 D 0990'
 R 11430.2
 T 161.7
 L 3283
 E 11

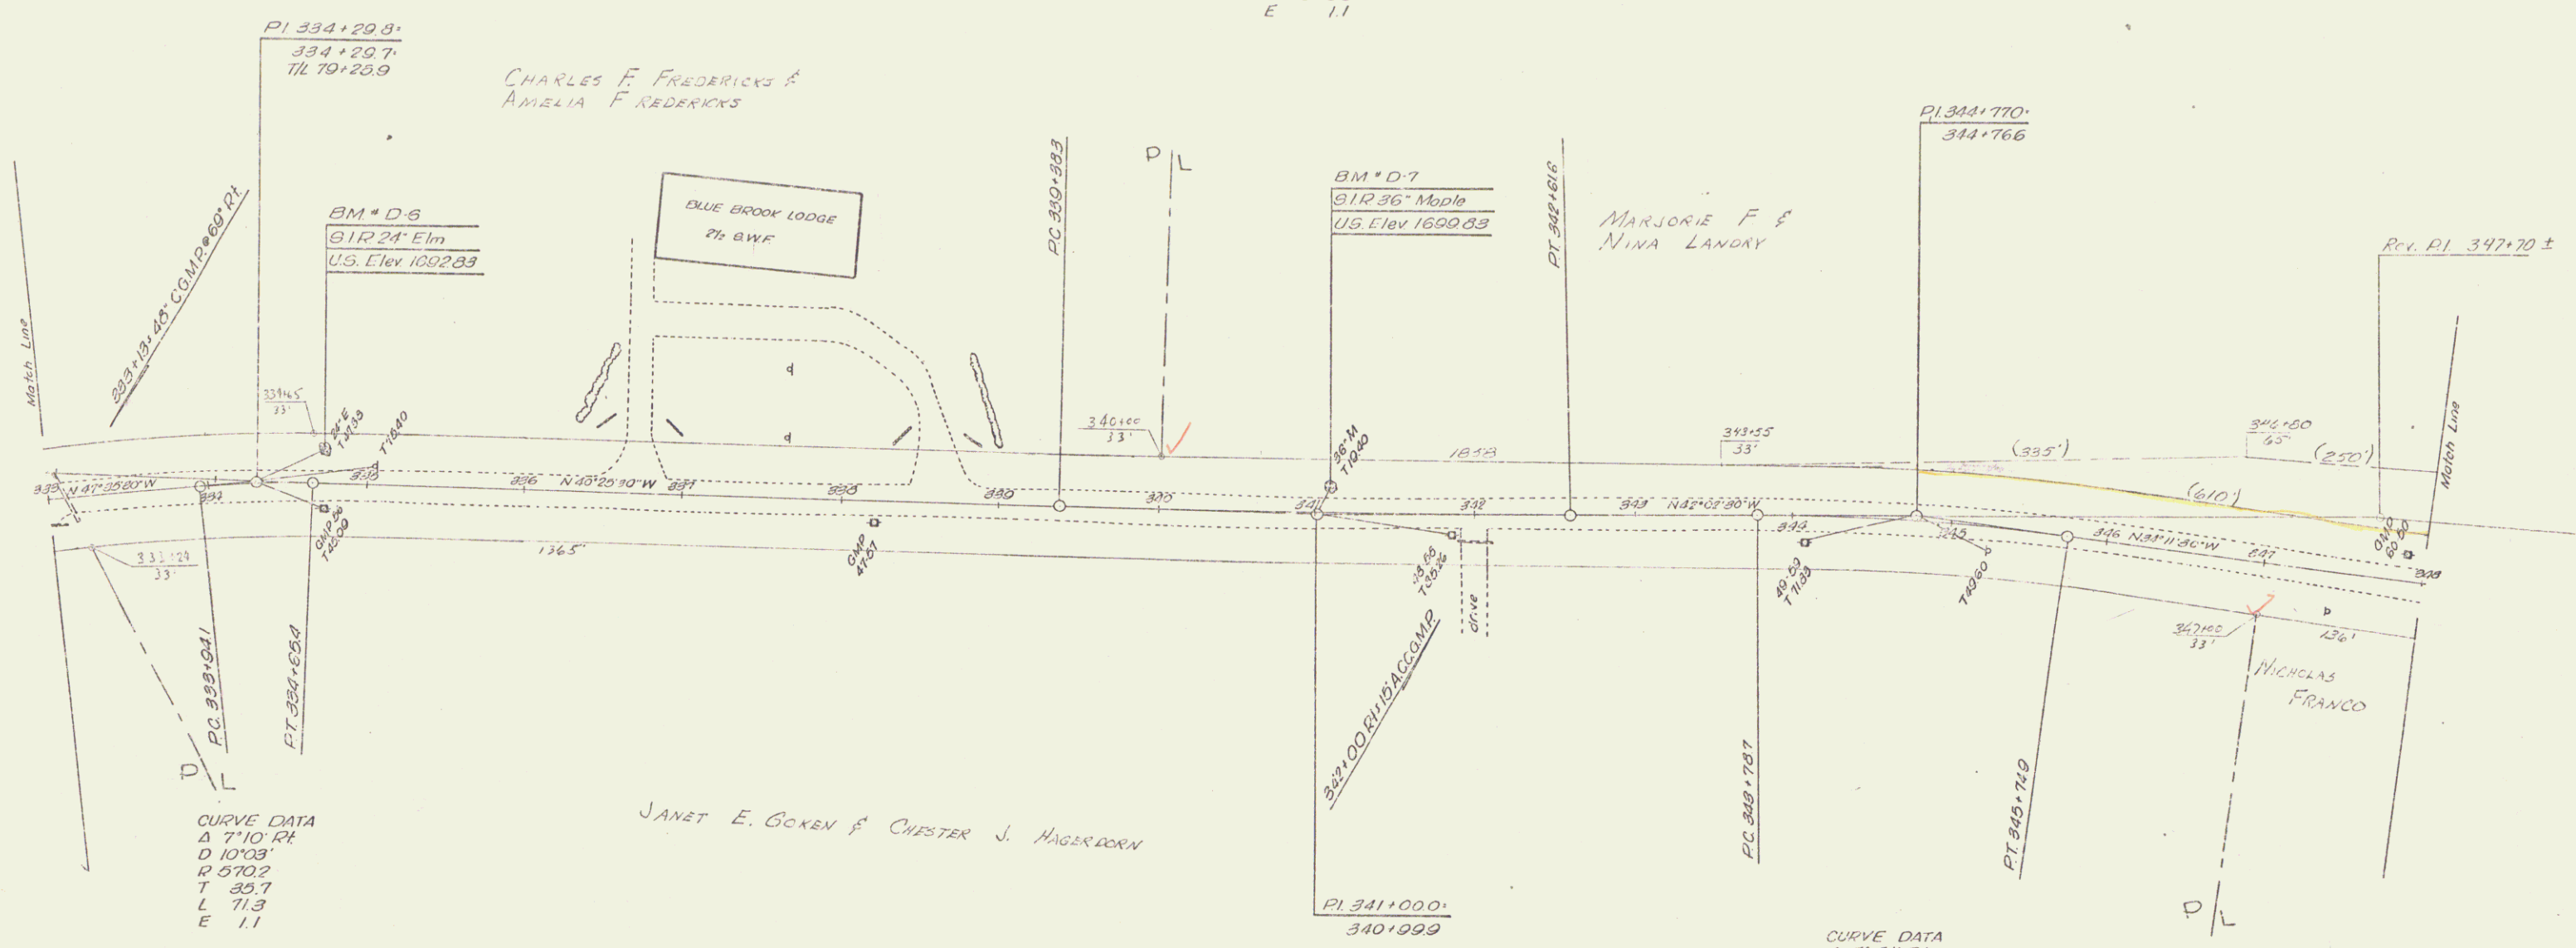

CURVE DATA
 Δ 710.04
 D 10703'
 R 5702
 T 35.7
 L 713
 E 11

CURVE DATA
 Δ 7' 51" RT
 D 4'
 R 14324
 T 033
 L 1062
 E 26

REV CURVE DATA
 Δ 5' 20" RT
 D 3'
 R 8339
 L
 E

DOVER	
SURVEYED BY <i>W. H. Little</i>	DATE <i>Aug 1953</i>
DRAWN BY <i>W. H. Little</i>	DATE <i>Sept 1953</i>
TRACED BY <i>W. H. Little</i>	DATE <i>Sept 1953</i>
VT. ROUTE 100	
PROJ. <i>113</i>	
SHEET <i>5</i>	OF <i>13</i>