

WOOD GUIDE POSTS
 304+50 - 305+25 Lt at 24'
 305+0 - 308+0 Rt at 24'
 308+75 - 308+25 Lt at 24'
 308+50 - 308+0 Rt at 24'
 312+80 - 316+50 Lt at 24'


WOOD GUIDE POSTS
 304+50 - 305+25 Lt at 24'
 305+0 - 308+0 Rt at 24'
 308+75 - 308+25 Lt at 24'
 308+50 - 308+0 Rt at 24'
 312+80 - 316+50 Lt at 24'

SILVER FILL FOR SLOPE PROTECTION
 307+25 - 308+15
 308+70 - 309+20
 310+00 - 316+00

REMEDIAL DISPLACEMENT GR
 305+75 - 308+46 Rt
 309+85 - 312+80 Rt
 312+66 - 313+14 Lt

CONSTRUCT DIVE
 305+52 Lt
 306+5 At

CONSTRUCT APPROACH
 313+95 Rt

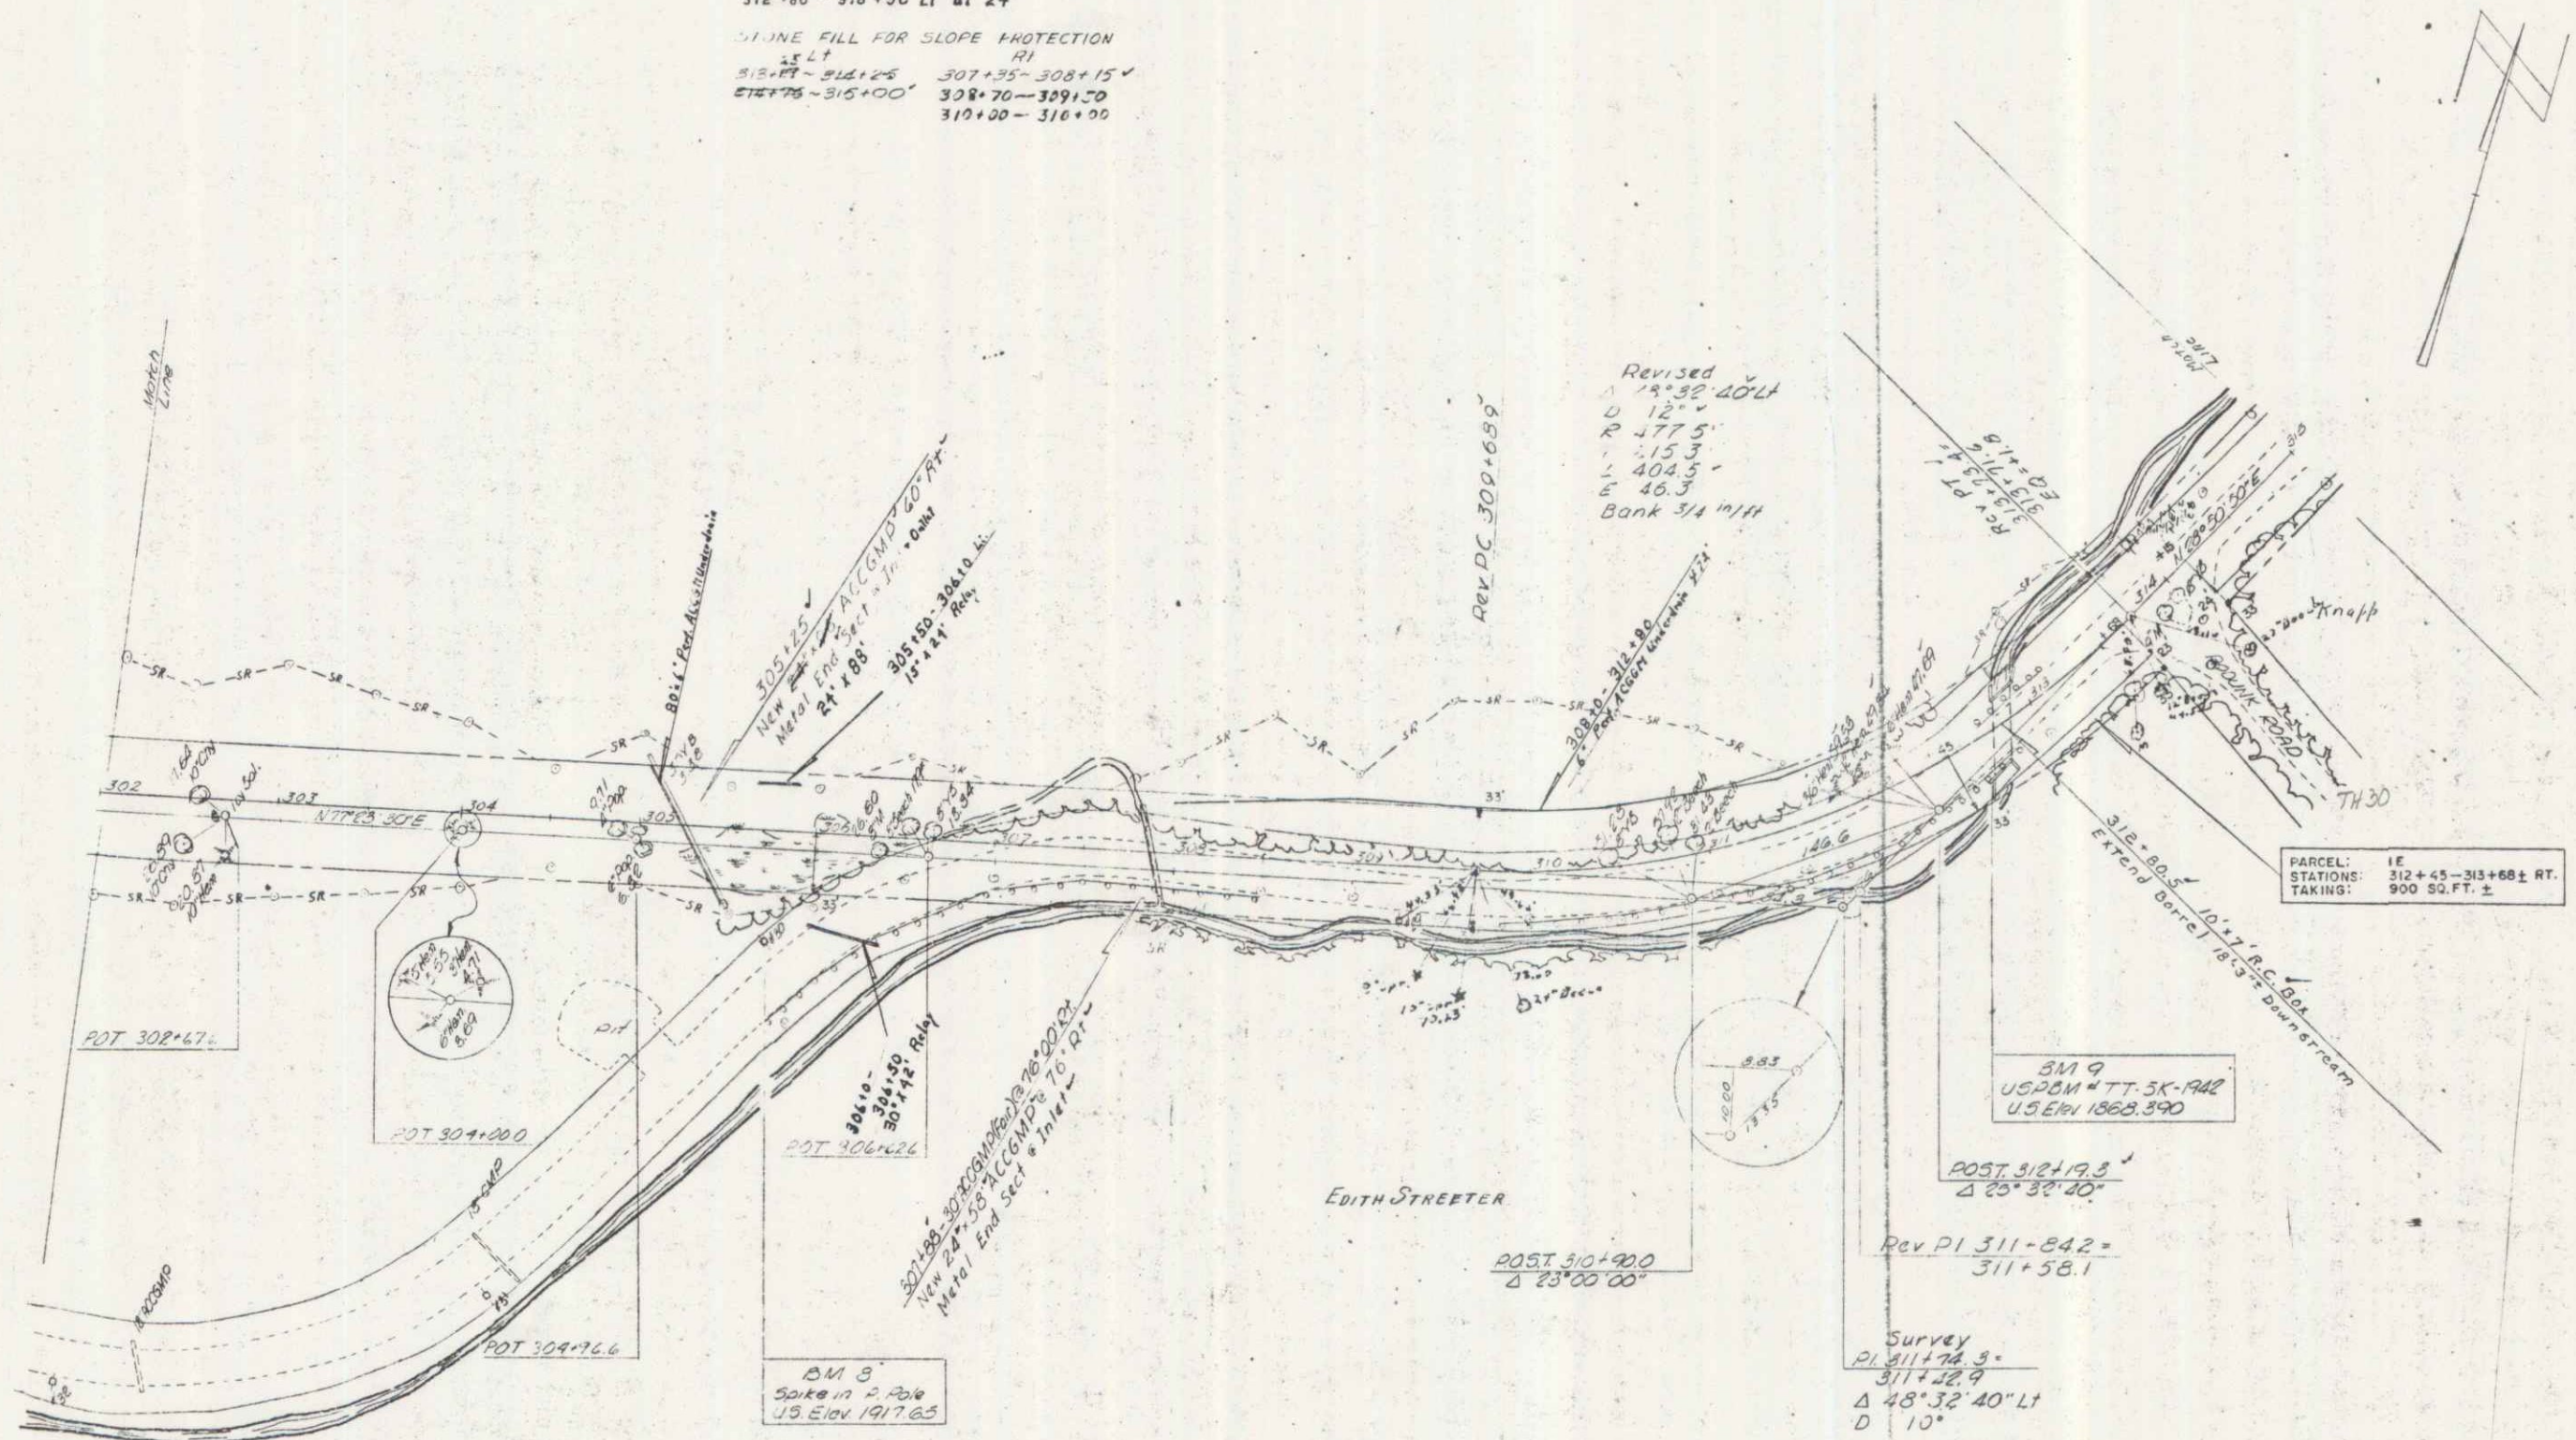

SURVEYED BY Watson DATE Nov. 20
 DRAWN BY Hurley DATE Jan. 21
 TRACED BY Fredson DATE Jan. 21
 WARDSBORO, VT. RTE. 100
 PROJ. NO. _____
 SHEET 4 OF 16