


PLAN
 DATE BOOK
 NO. 100
 SURVEYED BY
 CHECKED BY
 DRAWN BY
 WARDEN

TWO CABLE GUARD RAILS
 315+00 - 316+65 ± ft

WOOD GUIDE POSTS
 322+0 - 323+25 Lt at 24'

CONSTRUCT DRIVE
 317+50 RT
 323+0 RT


STONE FILL FOR SLOPE PROTECTION
 Lt
 315+00 - 316+40
 320+40 317+15
 321+50

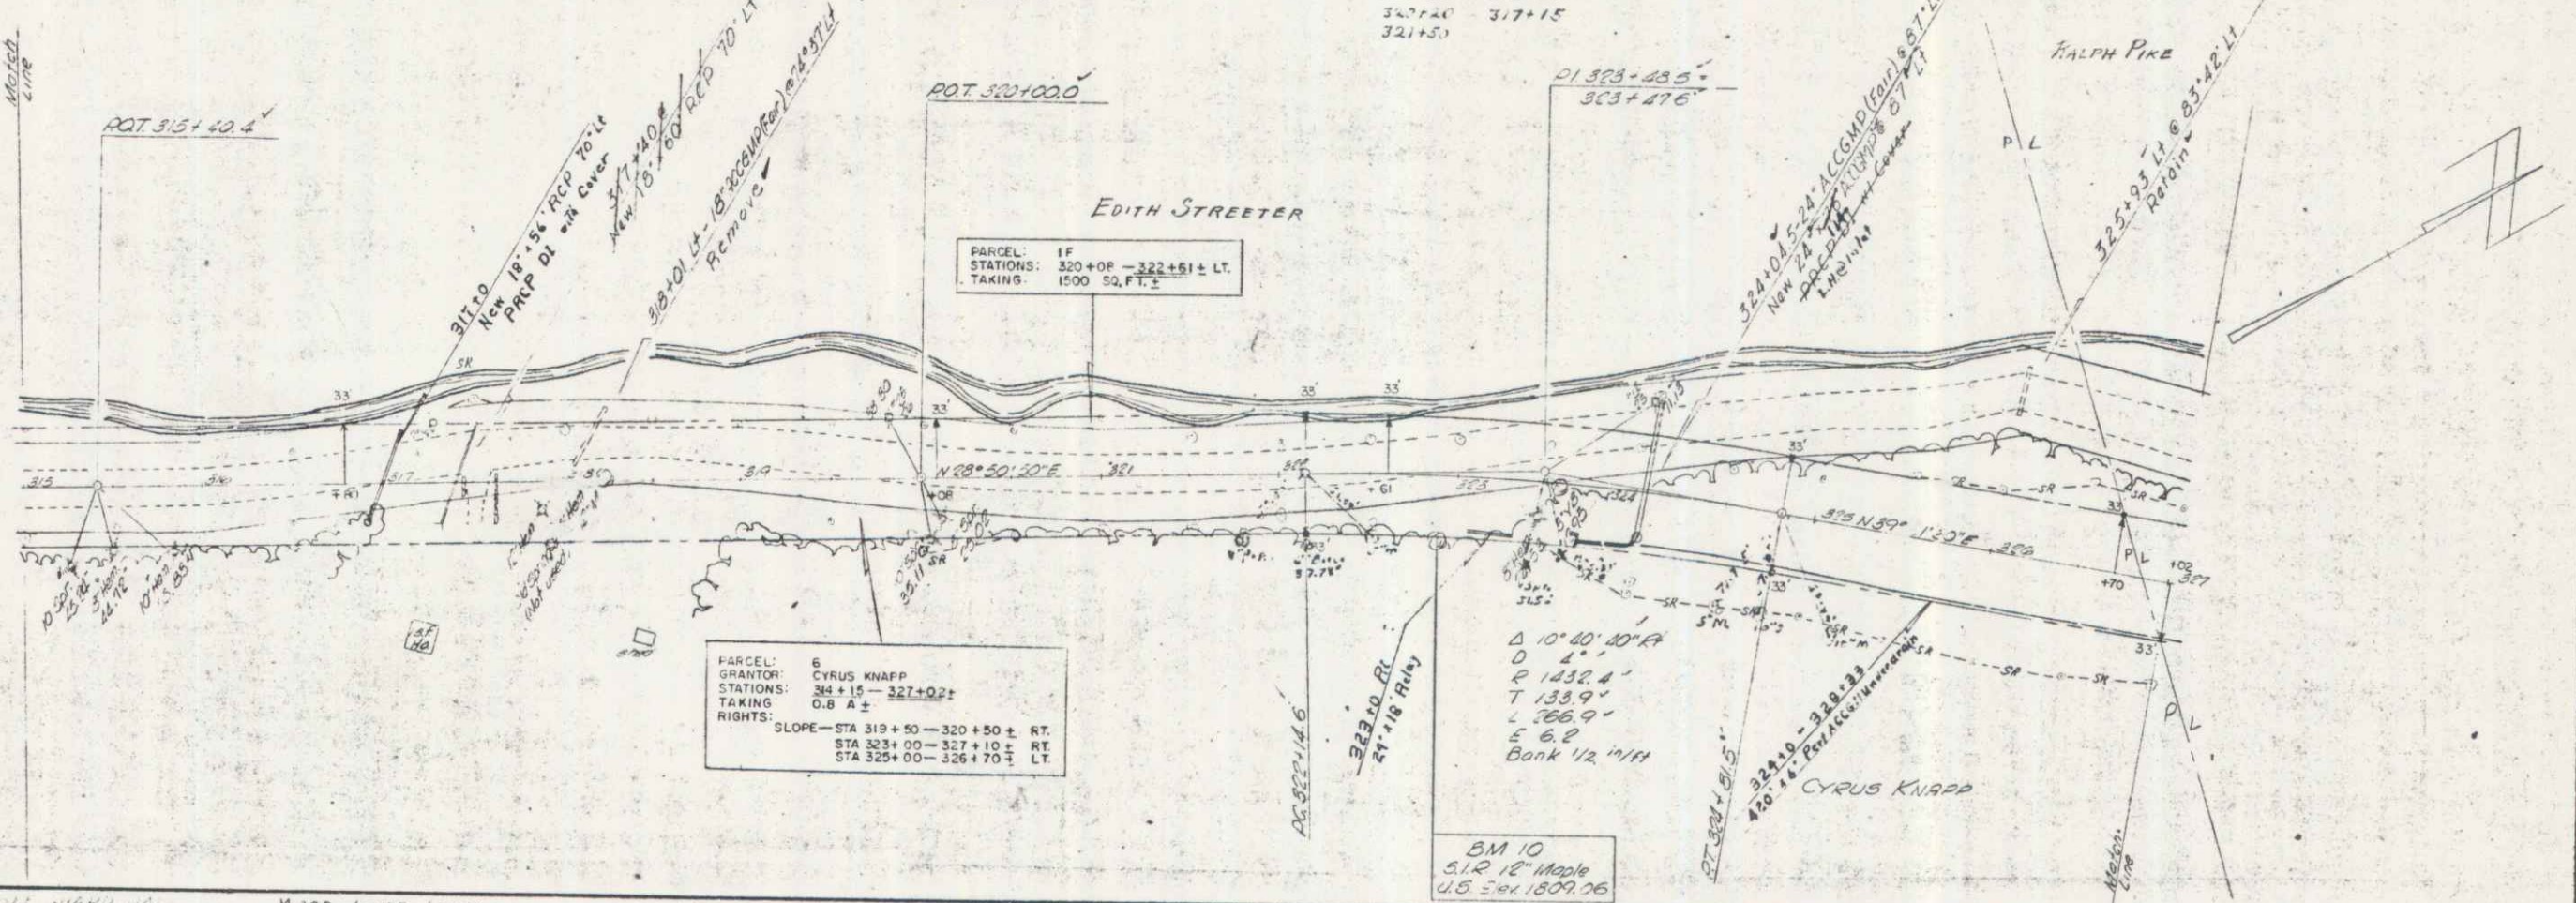

TWO CABLE GUARD RAILS
 329+10 - 331+25 Lt

WOOD GUIDE POSTS
 328+50 - 329+10 Rt at 24'
 335+0 - 335+50 Rt at 24'
 336+0 - 340+50 Lt at 16'

CONSTRUCT DRIVE
 330+25

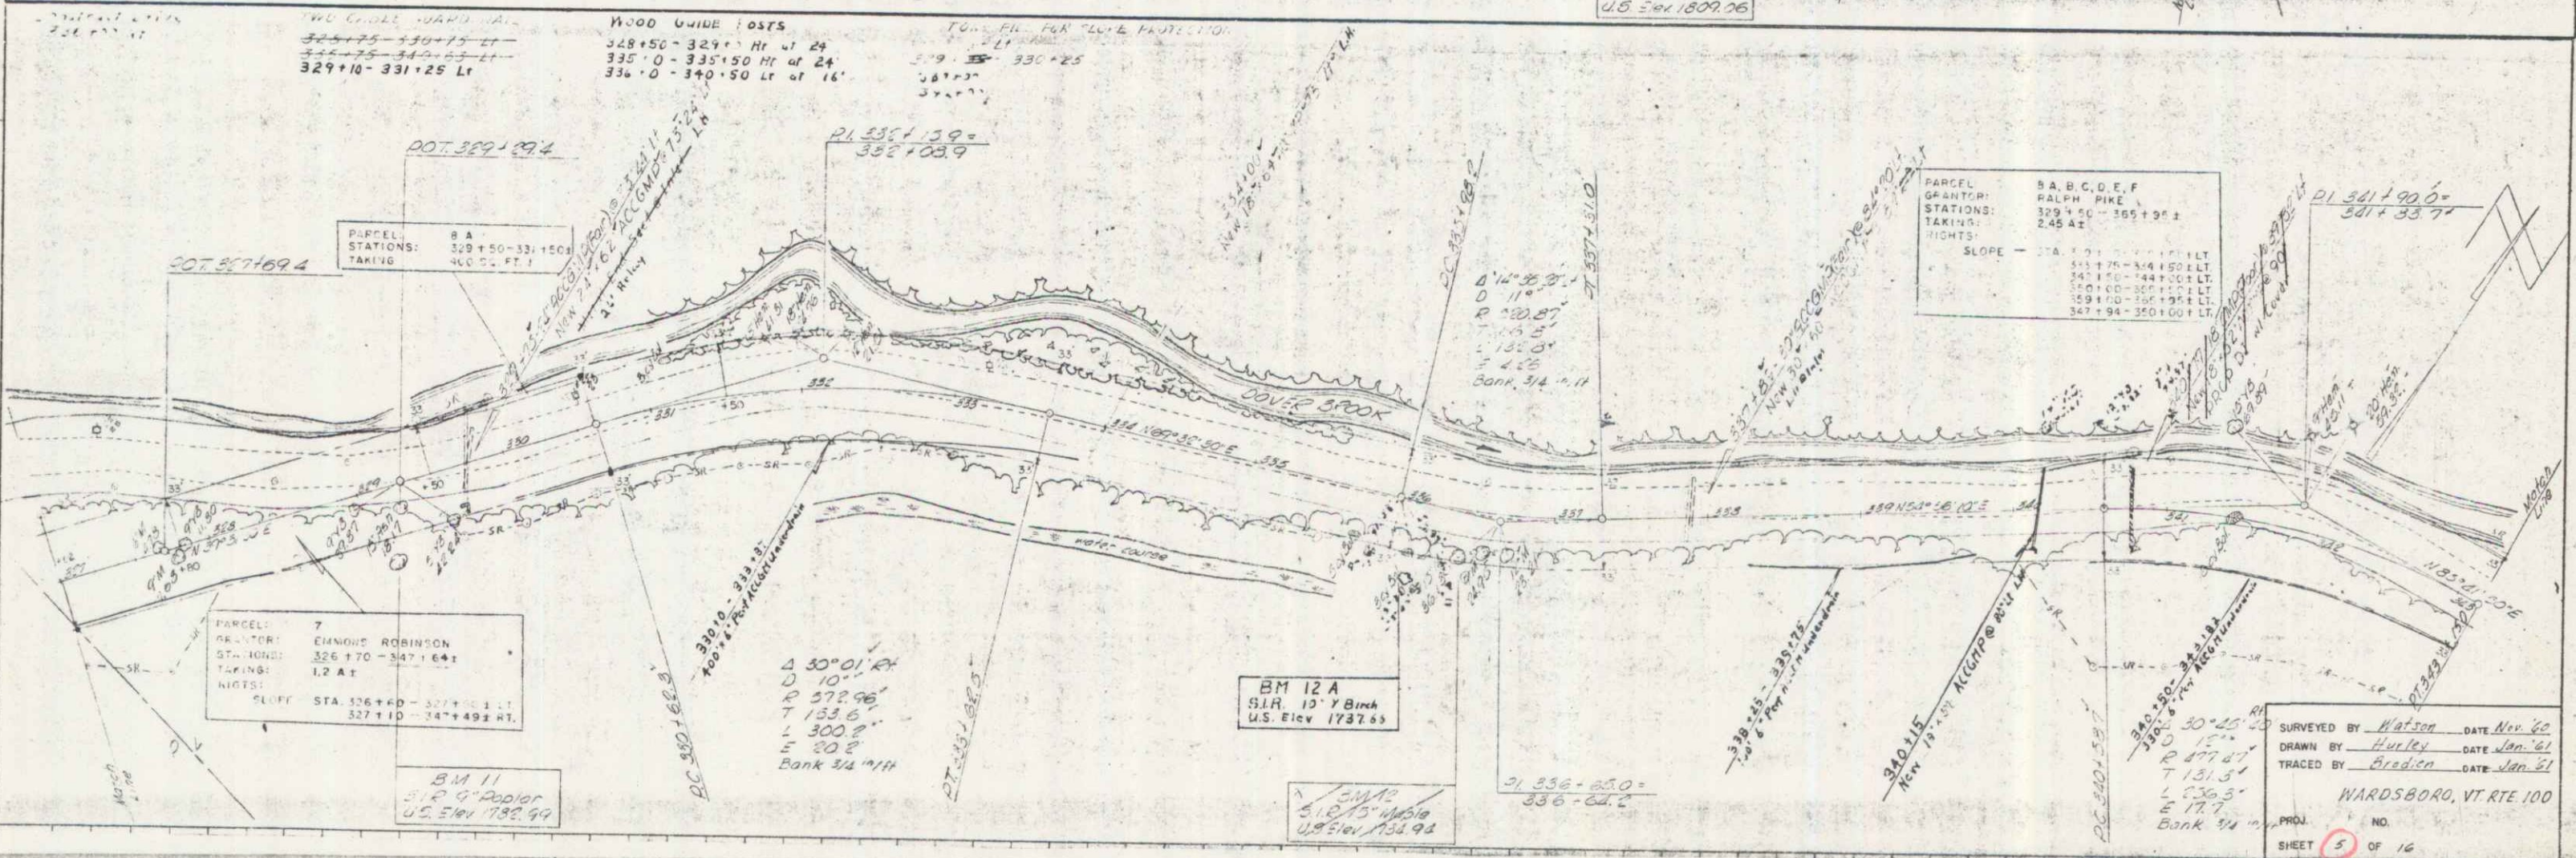

SURVEYED BY Watson DATE Nov. 22
 DRAWN BY Huckley DATE Jan. 21
 TRACED BY Bradley DATE Jan. 21
 WARDSBORO, VT RTE 100
 PROJ. NO. _____
 SHEET 5 OF 16