


PLAN
 DATE: 11/27/57
 DRAWN BY: H. J. HALEY
 CHECKED BY: W. J. BRODIE
 NO. 6 OF 16

PLAN
 DATE: 11/27/57
 DRAWN BY: H. J. HALEY
 CHECKED BY: W. J. BRODIE
 NO. 6 OF 16

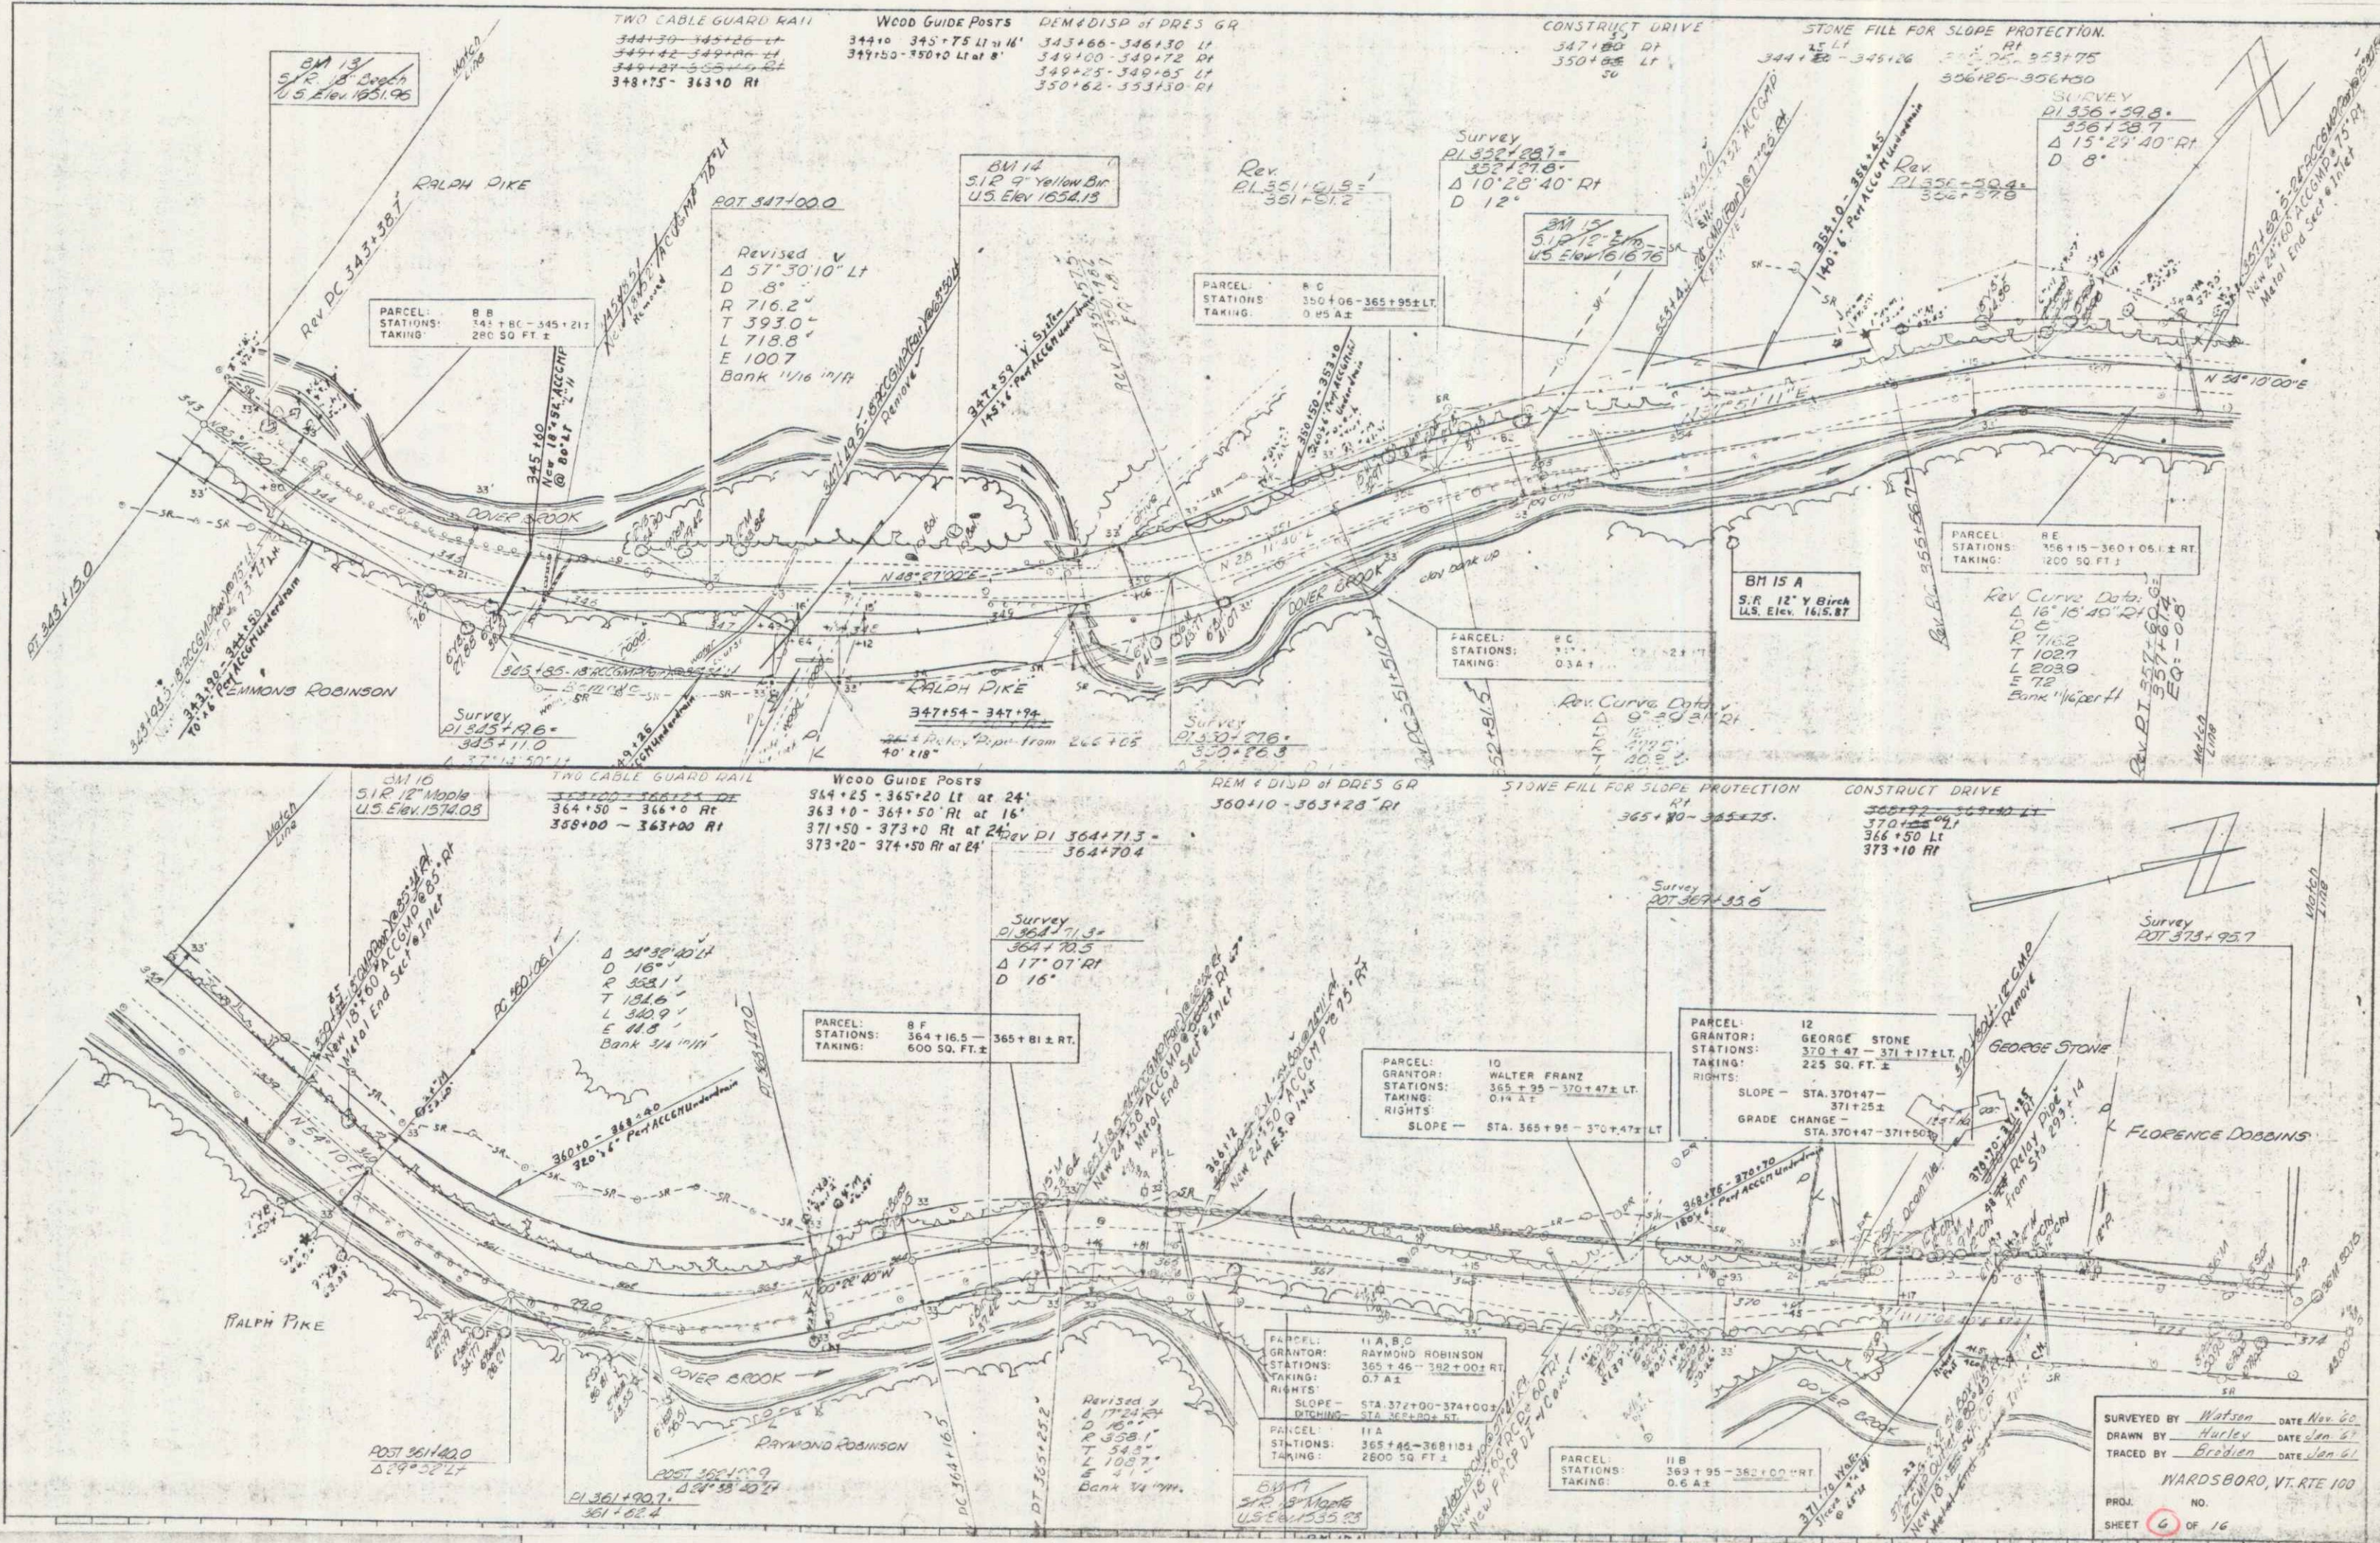

SURVEYED BY: Watson DATE: Nov. 56
 DRAWN BY: Haley DATE: Jan. 57
 TRACED BY: Brodie DATE: Jan. 57
 WARDSBORO, VT. RTE 100
 PROJ. NO. _____
 SHEET 6 OF 16