



POOR ORIGINAL COPY

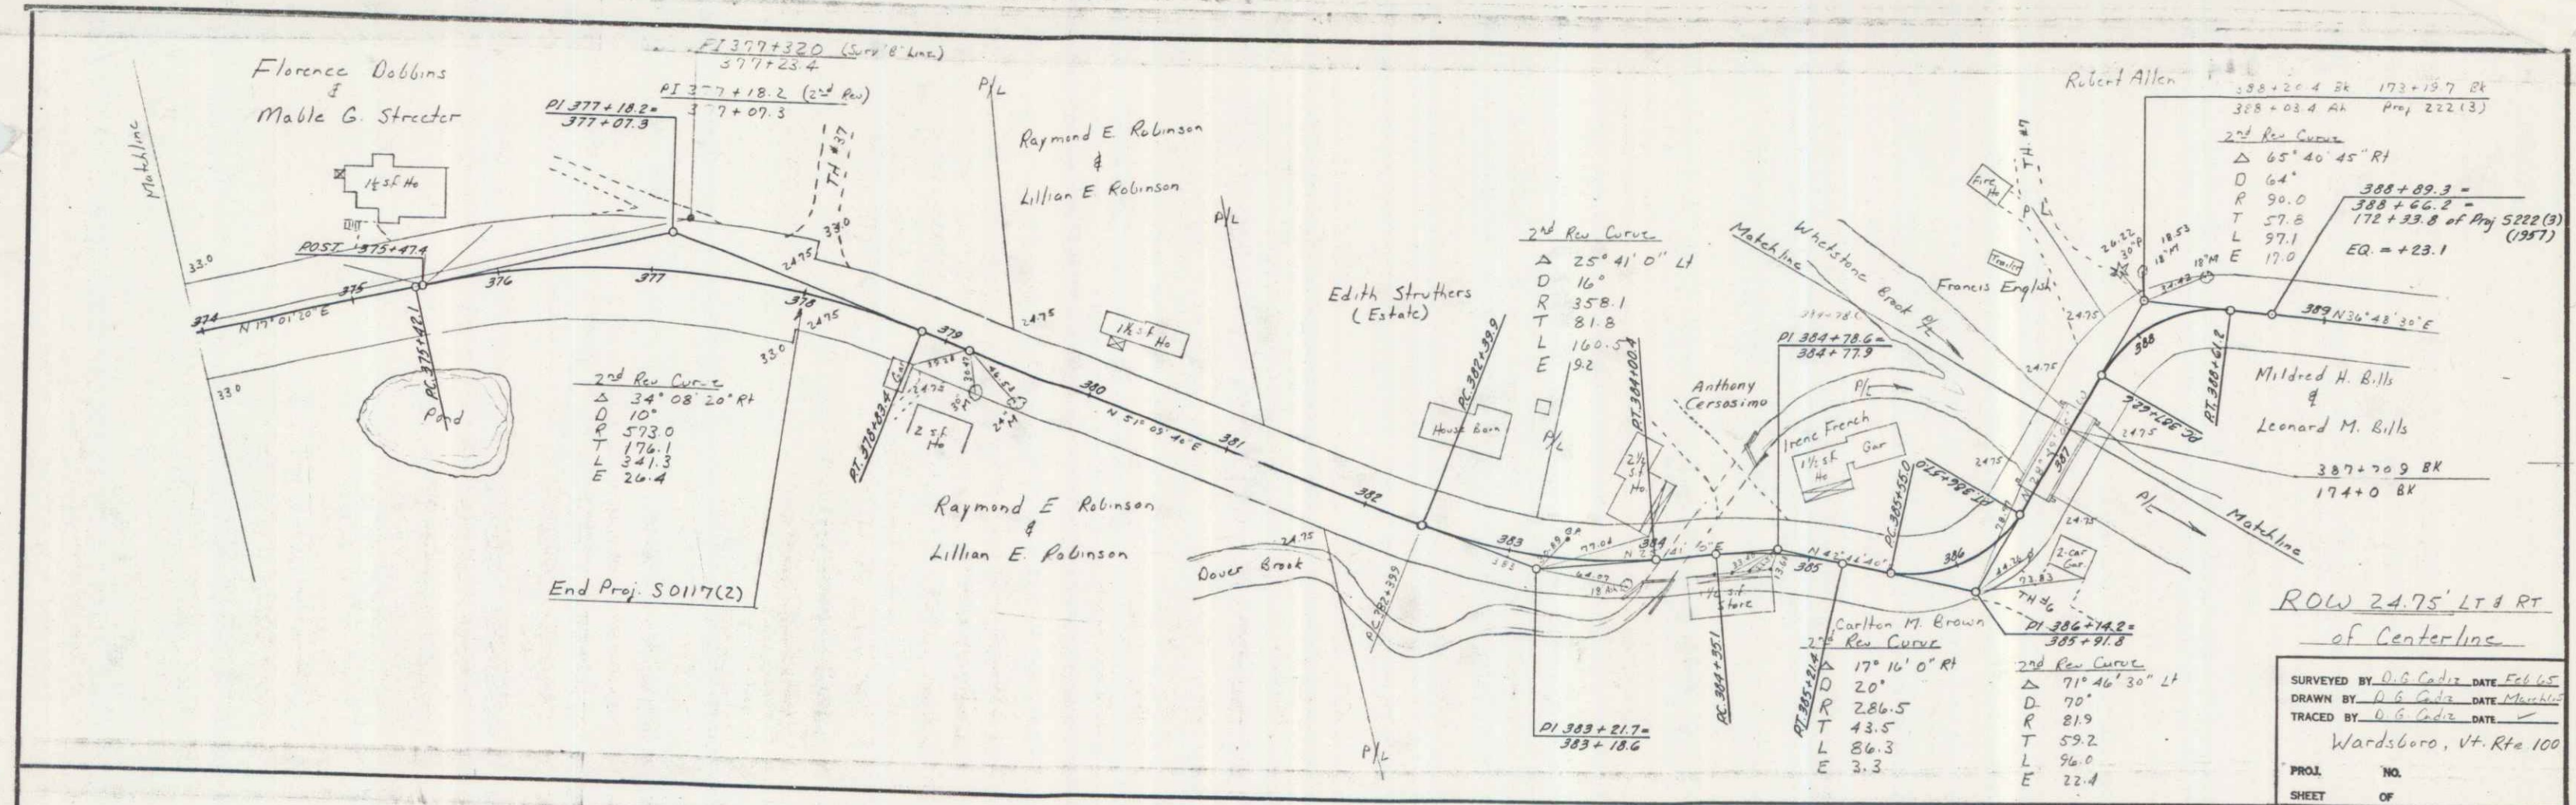

End Proj. S 0117(2)

ROW 24.75' LT & RT  
of Centerline

SURVEYED BY D.G. Cadiz DATE Feb 45  
DRAWN BY D.G. Cadiz DATE March 45  
TRACED BY D.G. Cadiz DATE  
Wardsboro, Vt. Rte 100  
PROJ. NO.  
SHEET OF

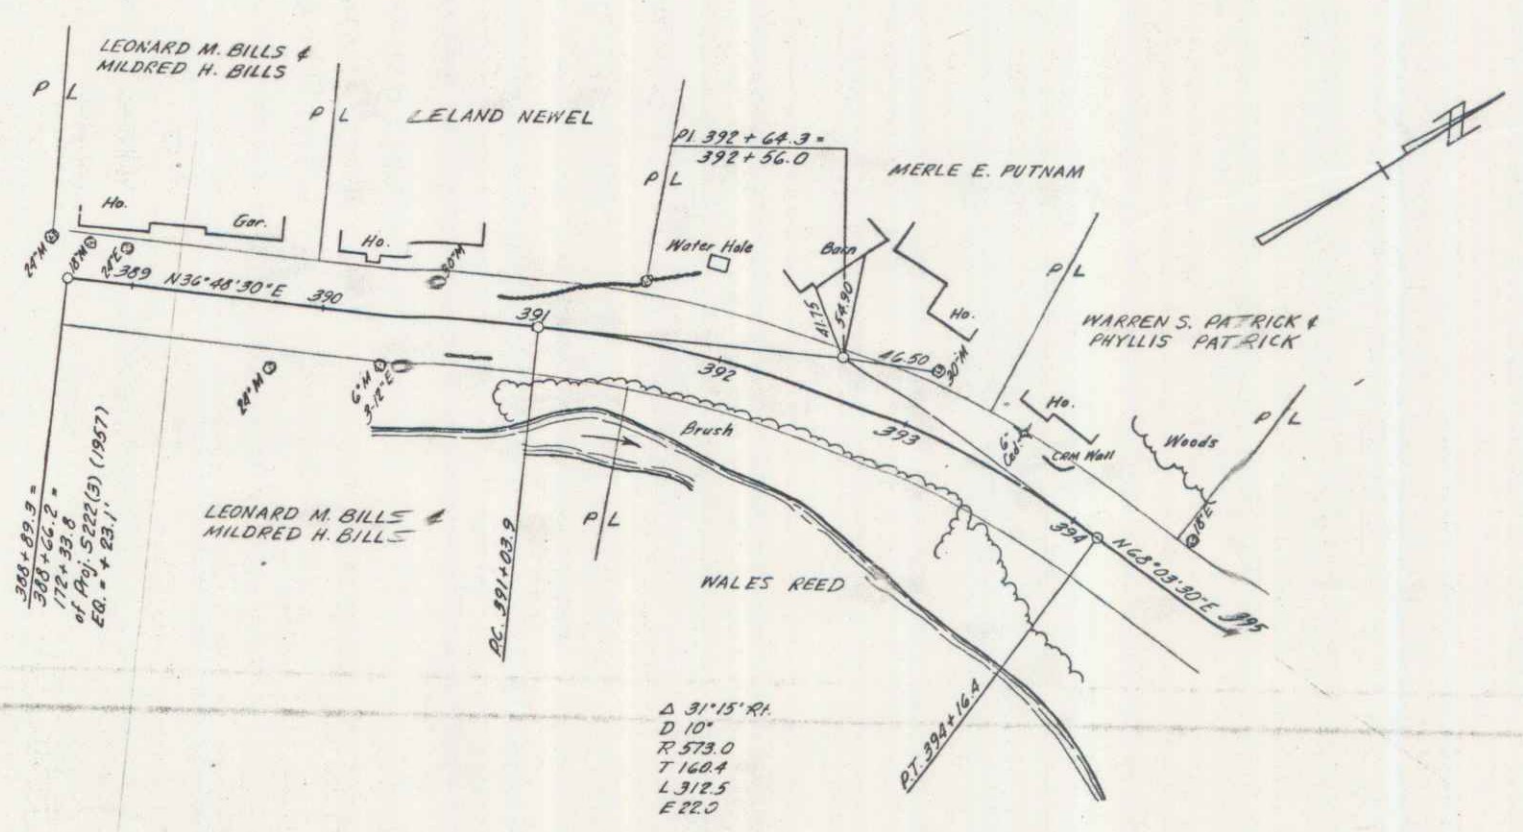

SURVEYED BY Jewett DATE 7-55  
DRAWN BY LSC/RA DATE 8-55  
TRACED BY A. Gagnon DATE 4-65  
WARDSBORO, VT. RTE 100  
PROJ. NO.  
SHEET 7 OF 16