
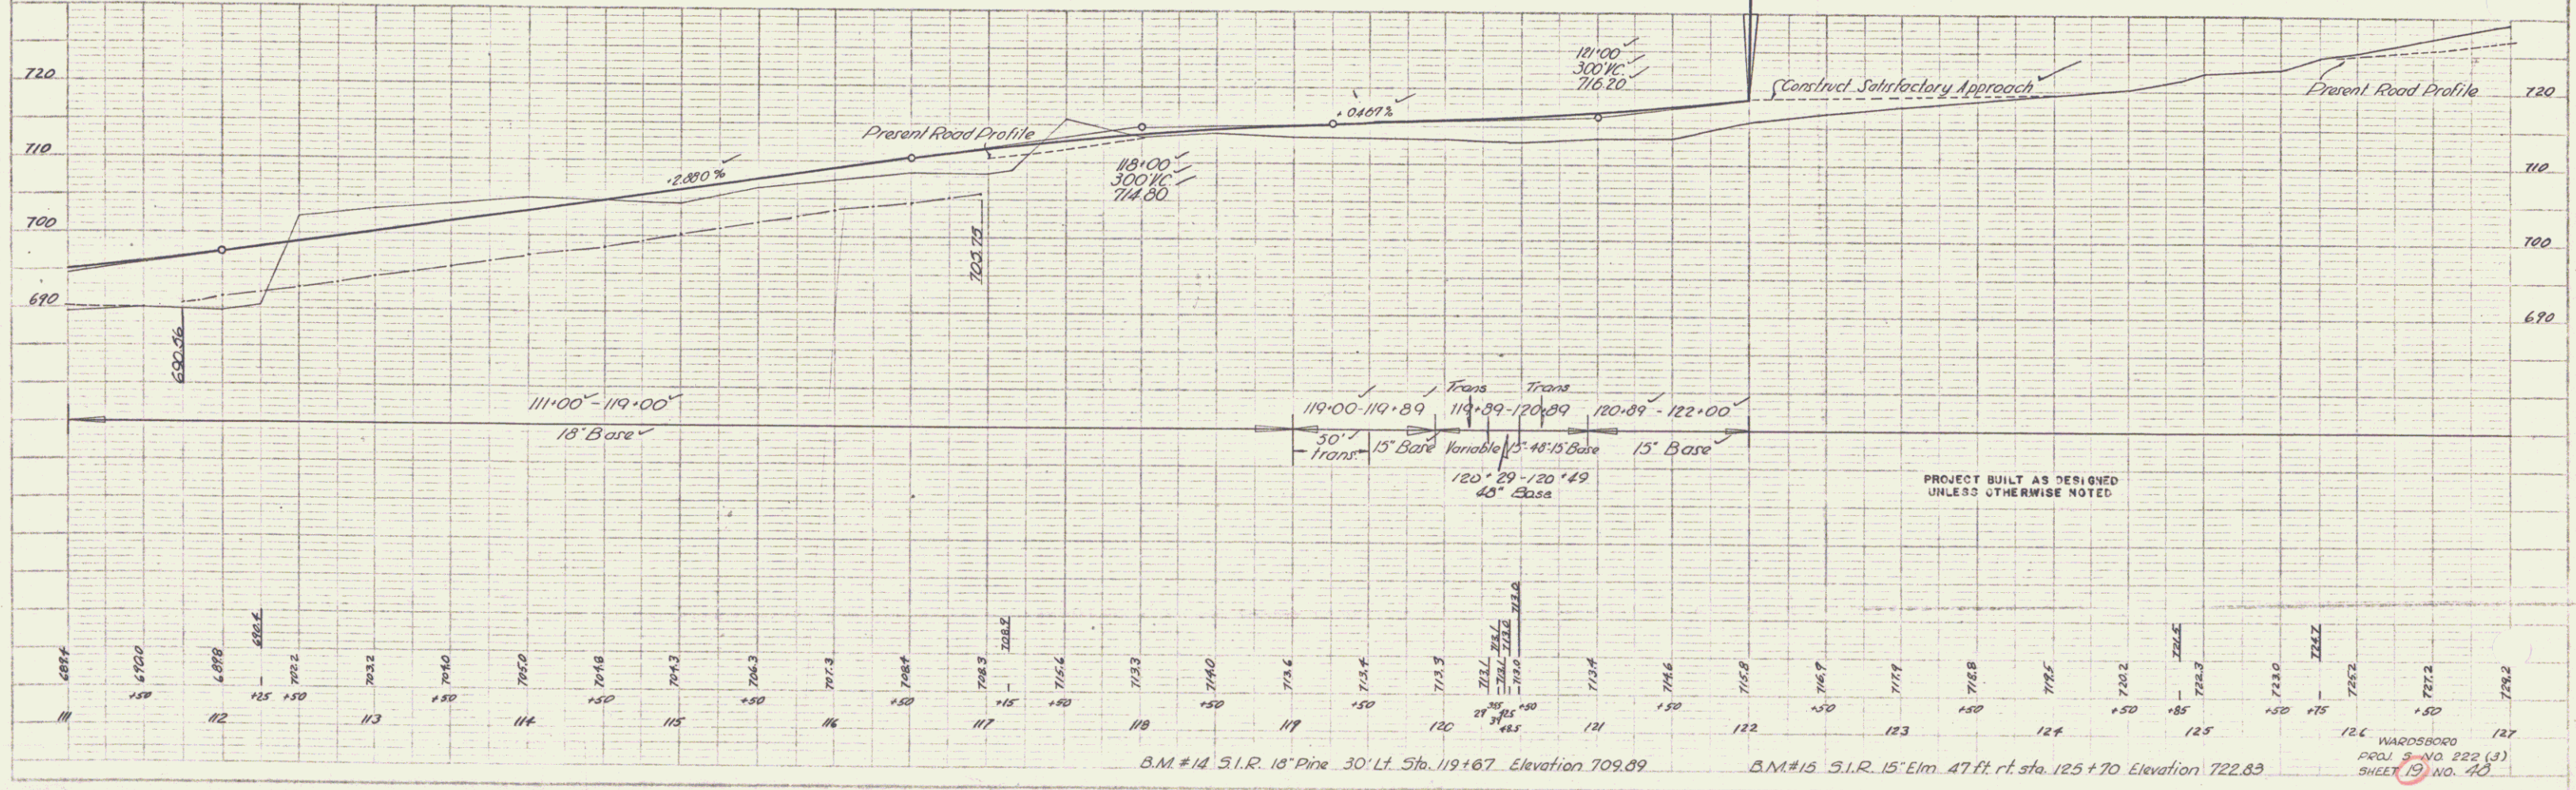


PLAN
 7-34
 9-38
 9-33
 V. J. L. P. A.
 M. J.

7-34
 9-38
 9-33
 V. J. L. P. A.
 M. J.

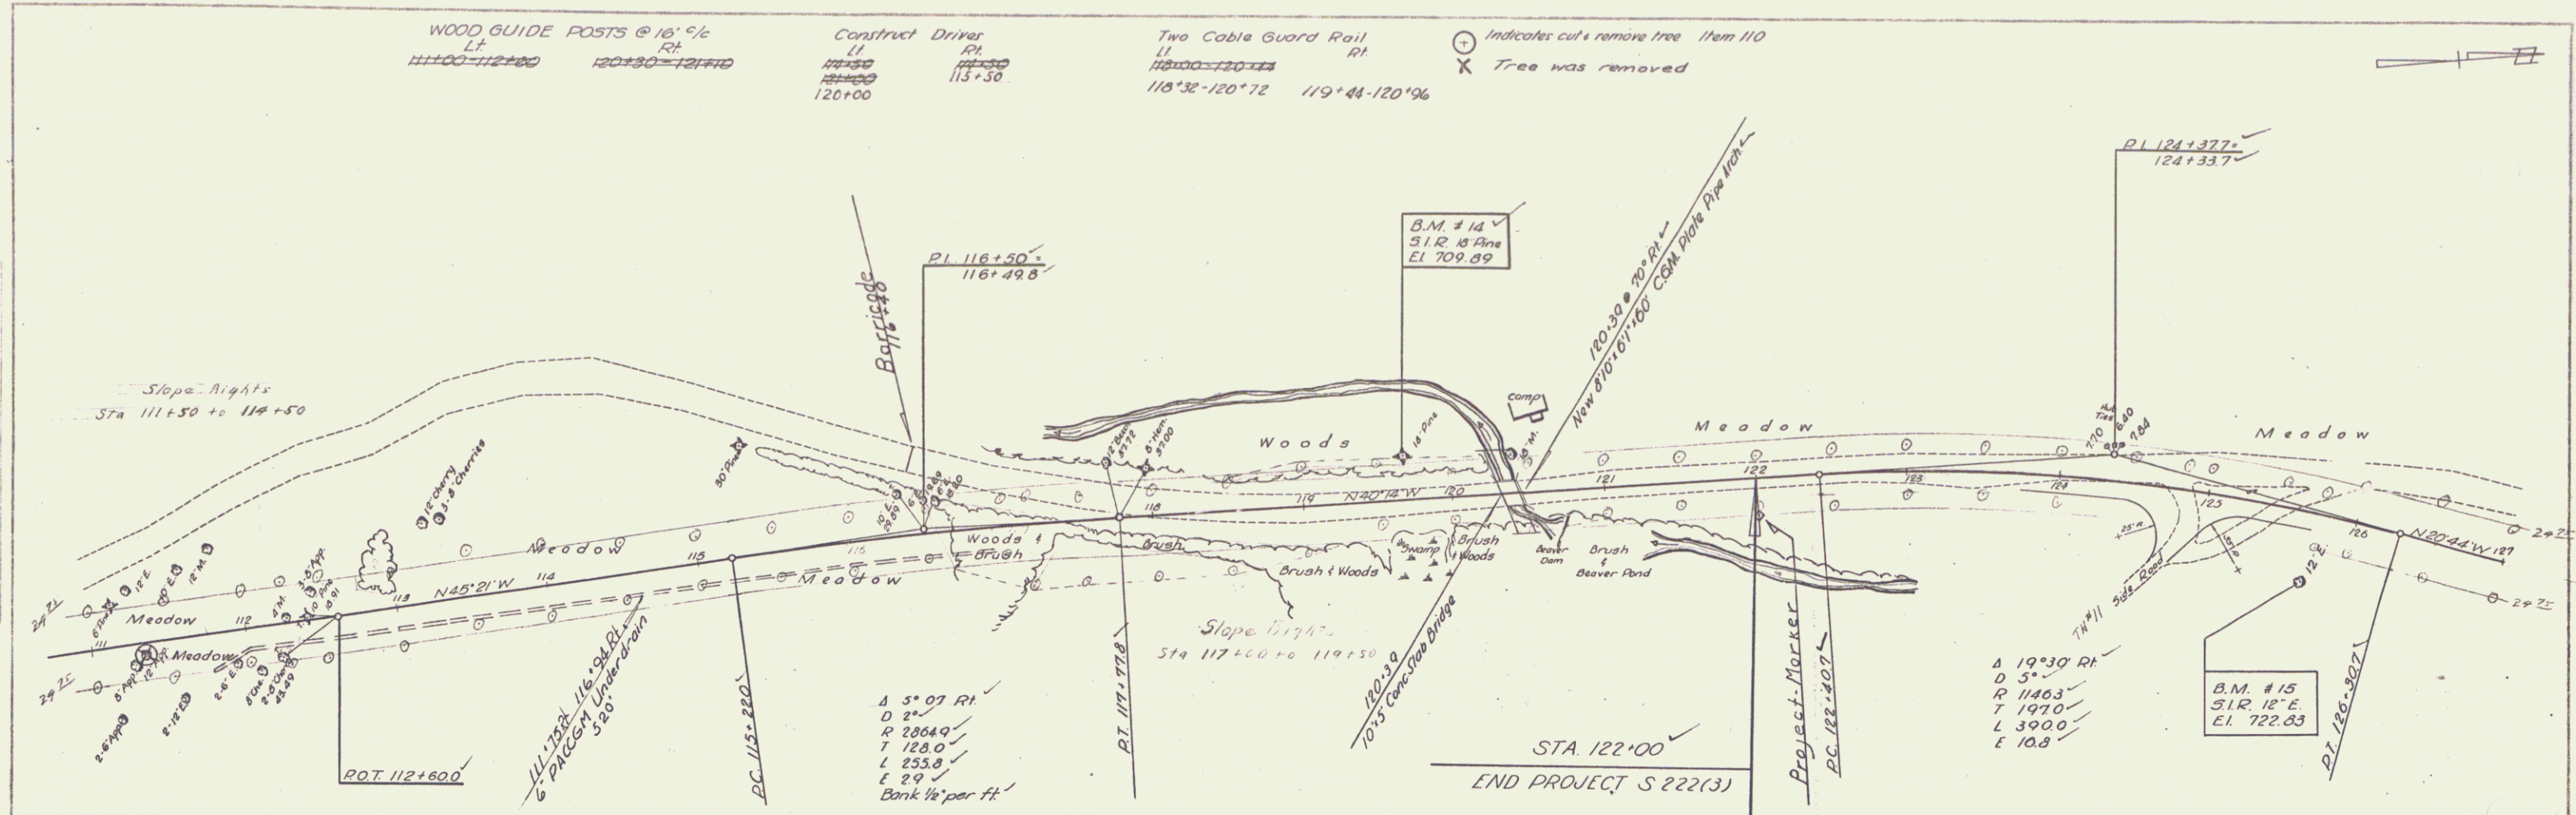

WOOD GUIDE POSTS @ 16' %
 LF RT
 111+00-112+00 120+30-121+10
 Construct Driver
 LI RT
 112+50 113+50
 Two Cable Guard Rail
 LI RT
 118+00-120+14 119+44-120+96
 Indicates cut & remove tree Item 110
 X Tree was removed

Δ 5° 07' RT
 D 2'
 R 2804.9
 T 123.0
 L 253.8
 E 2.9
 Bank 1/2' per ft.

Δ 19° 30' RT
 D 5'
 R 1140.3
 T 107.0
 L 300.0
 E 10.8

B.M. #14 51.R. 18" Pine 30' Lt. Sta. 119+67 Elevation 709.09
 B.M. #15 51.R. 15" Elm. 47' ft. rt. sta. 125+70 Elevation 722.83

WARDSBORO
 PROJ. NO. 222 (3)
 SHEET 19 NO. 140