

INDEX OF SHEETS

SHEET NO. 1	TITLE PAGE
" 2	TYPICAL CROSS-SECTION OF IMPROVEMENT
" 3	BANKING AND WIDENING TABLES
" 4-7	PLAN AND PROFILE STA.
" 8	DETAIL ABUTTS "1/2"
" 9	DETAIL PIER
" 10	SUB-45-MEW-28-84 (USE 84' OVERALL)
" 11	SUB 11 BARRICADES, LIGHTS, ETC
" 12	SUB 5C-CABLE RAIL
" 13	SUB 20-DETAILS-5103, 5105, 5111, 5112
"	GEN NOTES
" 14	OMITTED
" 15	SUB 28-CULVERTS
" 16	SUB 30-CABLE GUARD RAIL
" 17-26	CROSS SECTIONS

Standard Structure Sheet 3-28 approved by the Chief Engineer 7-11-33
 " " " 3-30 " " " 8-15-33

FED. ROAD DIST. NO.	STATE	W.P.S.O. PROJ. NO.	LOCAL YEAR	SHEET NO.	TOTAL SHEETS
9	Vt.	W-222	1937	1	26



STATE OF VERMONT
 STATE HIGHWAY DEPARTMENT
 PLAN AND PROFILE OF PROPOSED
 STATE HIGHWAY
 U.S. WORKS PROGRAM SECONDARY OUTSIDE PROJECT W.P.S.O.R222

TOWN OF JAMAICA

EAST JAMAICA - NORTH WARDSBORO - ROUTE 8
 BRIDGE OVER WHETSTONE BROOK

FIRST BRIDGE CROSSING THE WHETSTONE BROOK TRAVELING SOUTH FROM EAST JAMAICA TO NORTH WARDSBORO. BRIDGE IS KNOWN AS THE EWING BRIDGE.

LENGTH EXCLUDING BRIDGE 1782 FT.-.3375 MI.
 LENGTH INCLUDING BRIDGE 1950 FT.-.3693 MI.

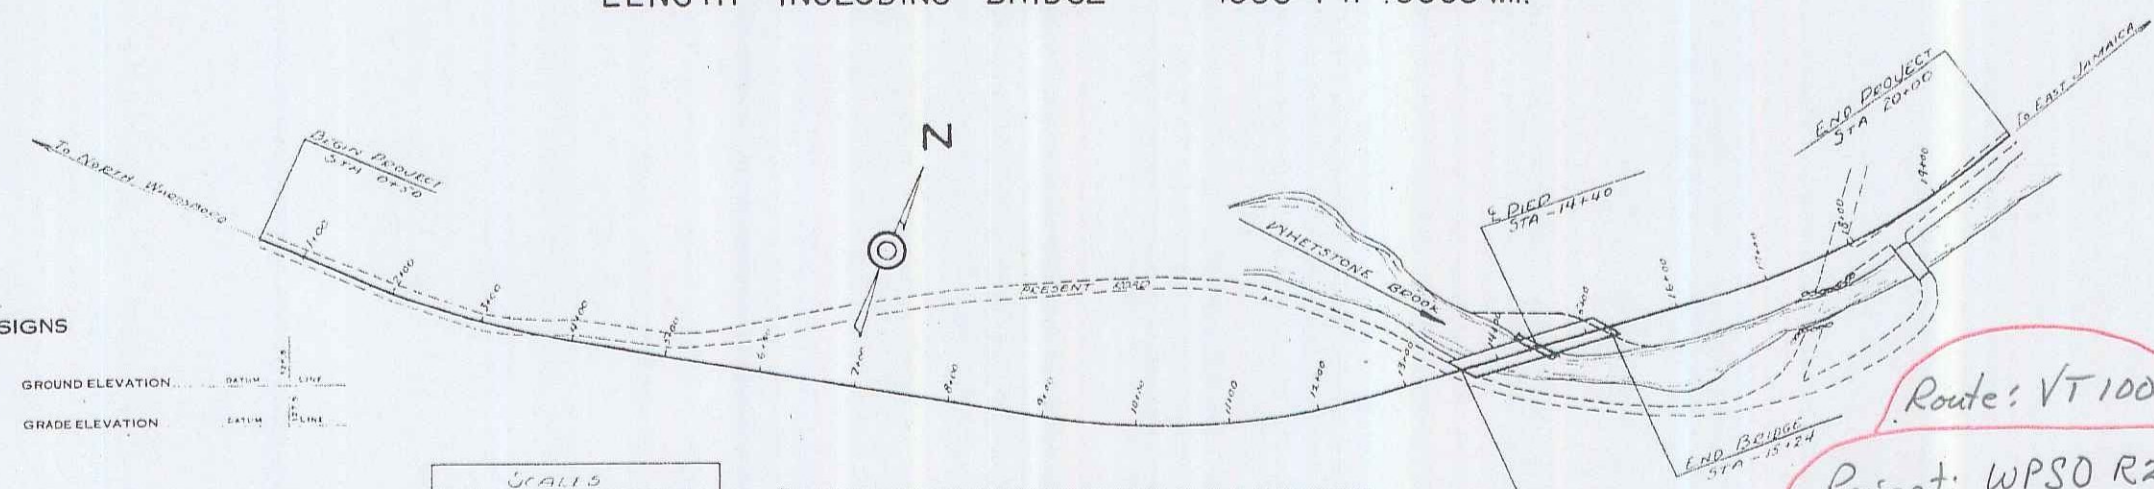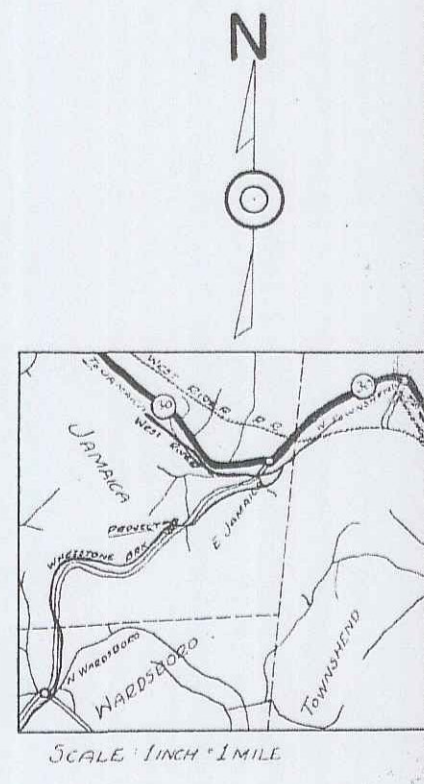

CONVENTIONAL SIGNS

COU. LINE	GROUND ELEVATION
TOWN LINE	GRADE ELEVATION
FEN. LINE	
STO. LINE	
UNFEN. PROPERTY	
GUARD RAIL	
TRAVELED WAY	
RAILROAD	
RETA. WALL	
CENTER LINE	
SURFACE	
CULVERT	
DR. ET.	
TRO. POLE	
TEL. POLE	
TR. HED.	

SCALES

TITLE	1"=100'
TYPICAL	1"=2'
PLAN	1"=20'
PROFILE	HOB 1"=20'
	VED 1"=10'
Cross Sections	1"=5'

THESE PLANS ARE SUBJECT TO SUCH REVISIONS AS MAY BE REQUIRED BY THE BUREAU OF PUBLIC ROADS OR THE COMMISSIONER OF HIGHWAYS. CONSTRUCTION IS TO BE CARRIED ON IN ACCORDANCE WITH THE PLANS AND STANDARD ROAD AND BRIDGE SPECIFICATIONS OF 1936 INCLUDING ALL SUBSEQUENT APPROVED REVISIONS AND SUCH REVISED SPECIFICATIONS AND SPECIAL PROVISIONS AS ARE SUBMITTED WITH THE PLANS.

APPROVED: Nov 2 1936
 COMMISSIONER OF HIGHWAYS
 SUBMITTED BY ORDER OF THE STATE HIGHWAY BOARD

Route: VT 100
 Project: WPSO R222
 Pin: DOR 696

RECOMMENDED
 DISTRICT ENGINEER BUREAU OF PUBLIC ROADS
 RECOMMENDED FOR APPROVAL
 CHIEF ENGINEER BUREAU OF PUBLIC ROADS
 APPROVED
 DIRECTOR - BUREAU OF PUBLIC ROADS

CORRECT:
 BRIDGE ENGINEER

SERIES WPSO NO. R222 FILED
 SHEET 1 OF 26