


WPSO
 R 222 1937 5 26

Sta 7+32
 200' VC
 El. 501.10

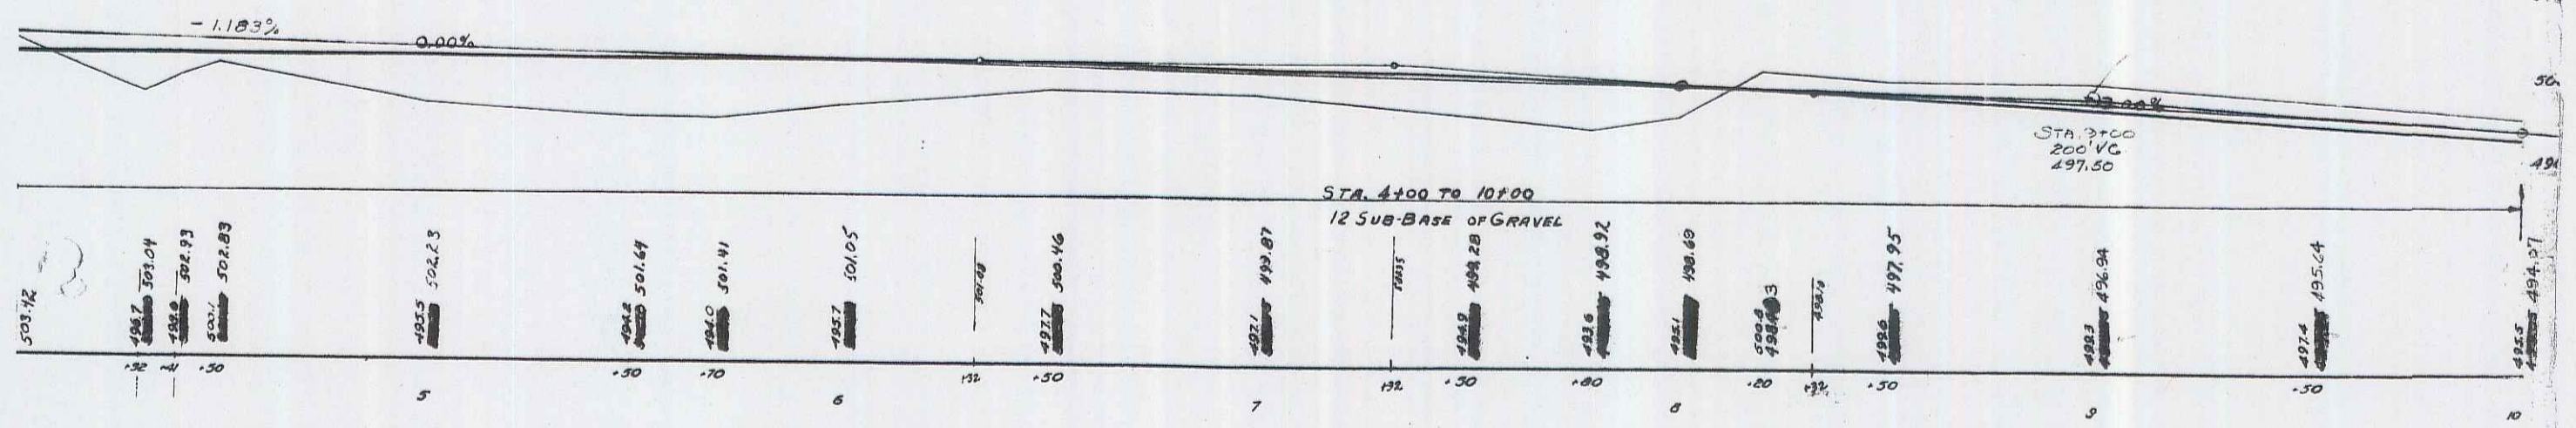

5/26 EWING BRIDGE
 JAMAICA
 WPSO R 222
 5