

INDEX OF SHEETS

SHEET NO. 1	TITLE PAGE
" 2	TYPICAL CROSS-SECTION OF IMPROVEMENT 6" GRAVEL SURFACE COURSE ITEM 22
" 3	BANKING AND WIDENING TABLES
" 4-12	PLAN AND PROFILE STA.
" 13	STANDARD STRUCTURE SHEET 5-30 PIPE CULVERTS
" 14	" " " 5-39 BOX CULVERTS
" 15	" " " 5-30-A UNDERDRAIN
" 16	" " " SC-1 BOX CULVERTS
" 17	" " " 5-40 BARBICADES, SIGNS & LIGHTS
" 18	" " " 5-41 ROUNDING SLOPES
" 19-57	CROSS SECTIONS

STATE OF VERMONT
 STATE HIGHWAY DEPARTMENT
 PLAN AND PROFILE OF PROPOSED
 STATE HIGHWAY



STATE FLOOD PROJECT 222-L

TOWN OF JAMAICA

EAST JAMAICA — WARDSBORO ROAD
 RECONSTRUCTION OF SIX SECTIONS OF HIGHWAY

LENGTH OF PROJECT 7,782 FT. = 1.473 MI.
 7,932 1.502

FED. ROAD DIST. NO.	STATE PROJ. NO.	FISCAL YEAR	TOTAL SHEETS
9	Vt. 222-L	1939	57

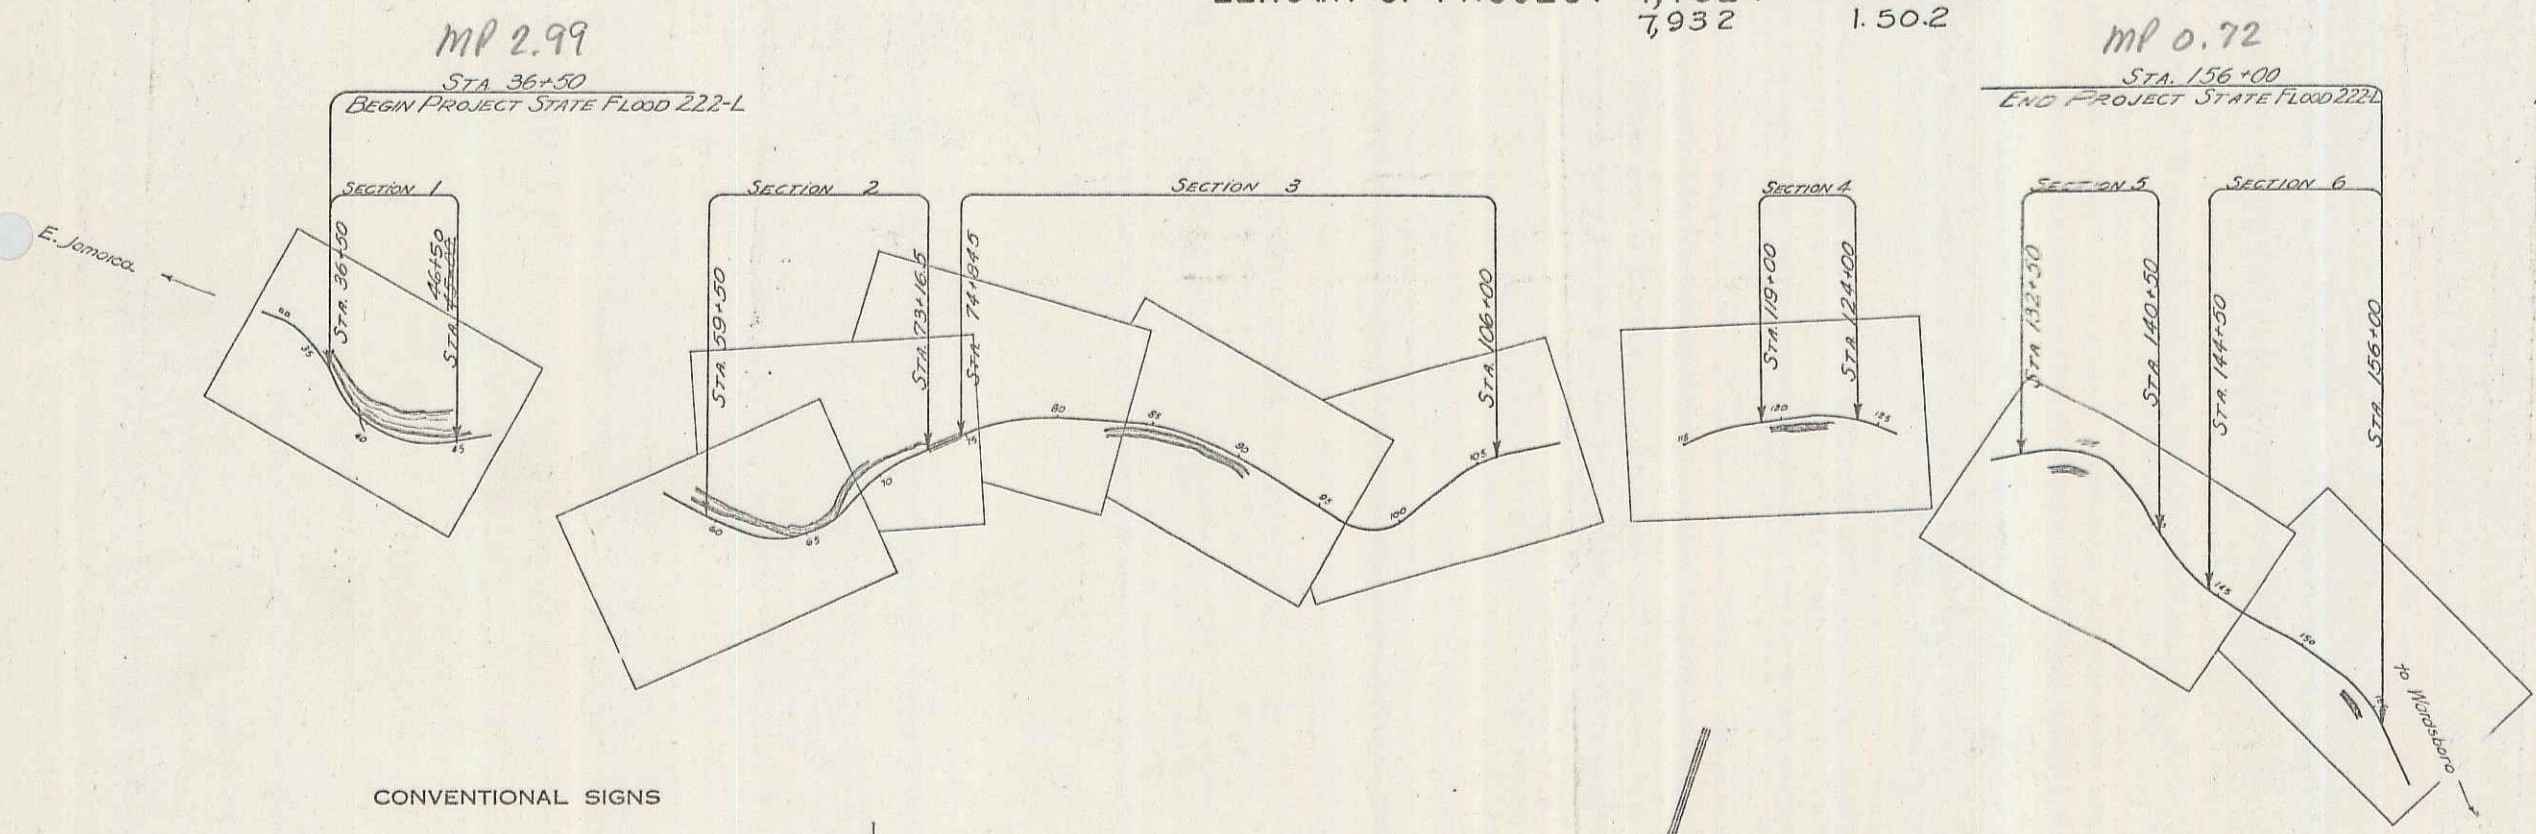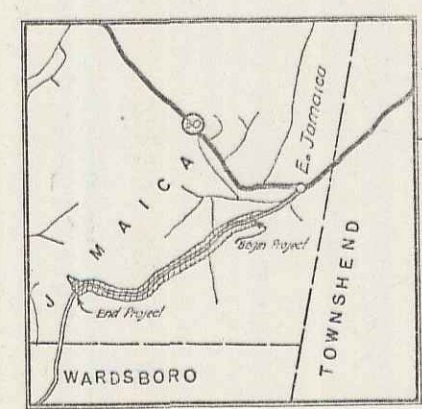

These layouts have been corrected to correspond with the project as constructed.
 No State Notes available
 No Line Change mentioned in field books.

RIGHT-OF-WAY DIVISION
 TOWN FILE
 PERPETUAL
 Town of U100
 [To Be Returned To R.O.W. Division]

PIN: 008697
 ROUTE: VT100
 PROJECT: SF222 L
 DATE: 08/04/1939

APPROVED: *H. H. August*
 COMMISSIONER OF HIGHWAYS
 SUBMITTED BY ORDER OF THE STATE HIGHWAY BOARD

CONVENTIONAL SIGNS


COUNTY LINE	GROUND ELEVATION
TOWN LINE	GRADE ELEVATION
FENCE LINE	
STONE WALL	
UNFENCED PROPERTY	
GUARD RAIL	
TRAVELED WAY	
RAILROAD	
RETAINING WALL	
CENTER LINE	
SURVEY LINE	
CULVERT	
DROP INLET	
TROLLEY POLE	
POWER POLE	
TELEPHONE POLE	
TREES	
HEDGE	

CURVE DATA

DEFLECTION ANGLE	Δ
DEGREE OF CURVE	D
RADIUS OF CURVE	R
TANGENT DISTANCE	T
LENGTH OF CURVE	L
EXTERNAL DISTANCE	E
POINT OF INTERSECTION	P. I.
POINT OF CURVE	P. C.
POINT OF TANGENT	P. T.
POINT ON TANGENT	P. O. T.

SCALES

TITLE	1" = 500'
TYPICAL	1" = 2'
PLAN	1" = 50'
HORIZ.	1" = 50'
PROFILE	
VERT.	1" = 10'
CROSS-SECTIONS	1" = 5'

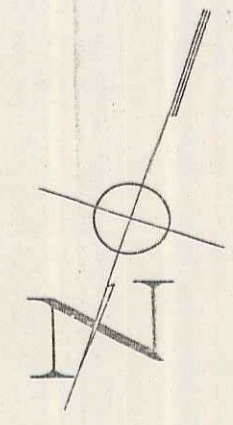

These plans are subject to such revision as may be required by the Public Roads Administration or the Commissioner of Highways.
 Construction is to be carried on in accordance with the plans and the Standard Road & Bridge Specifications of 1936, as approved Dec. 29, 1936, by the Public Roads Administration including all subsequent approved revisions and such revised specifications and special provisions as are submitted with the plans.

RECOMMENDED
 DISTRICT ENGINEER
 RECOMMENDED FOR APPROVAL
 CHIEF ENGINEER
 APPROVED
 CHIEF ENGINEER OF PUBLIC ROADS

APPROVED: *[Signature]* DISTRICT HIGHWAY COMMISSIONER
 APPROVED: *[Signature]* ROAD ENGINEER
 SERIES No. 222-L FILED
 SHEET 1 OF 57 Vt 100

DIST. #2 PLANS.