
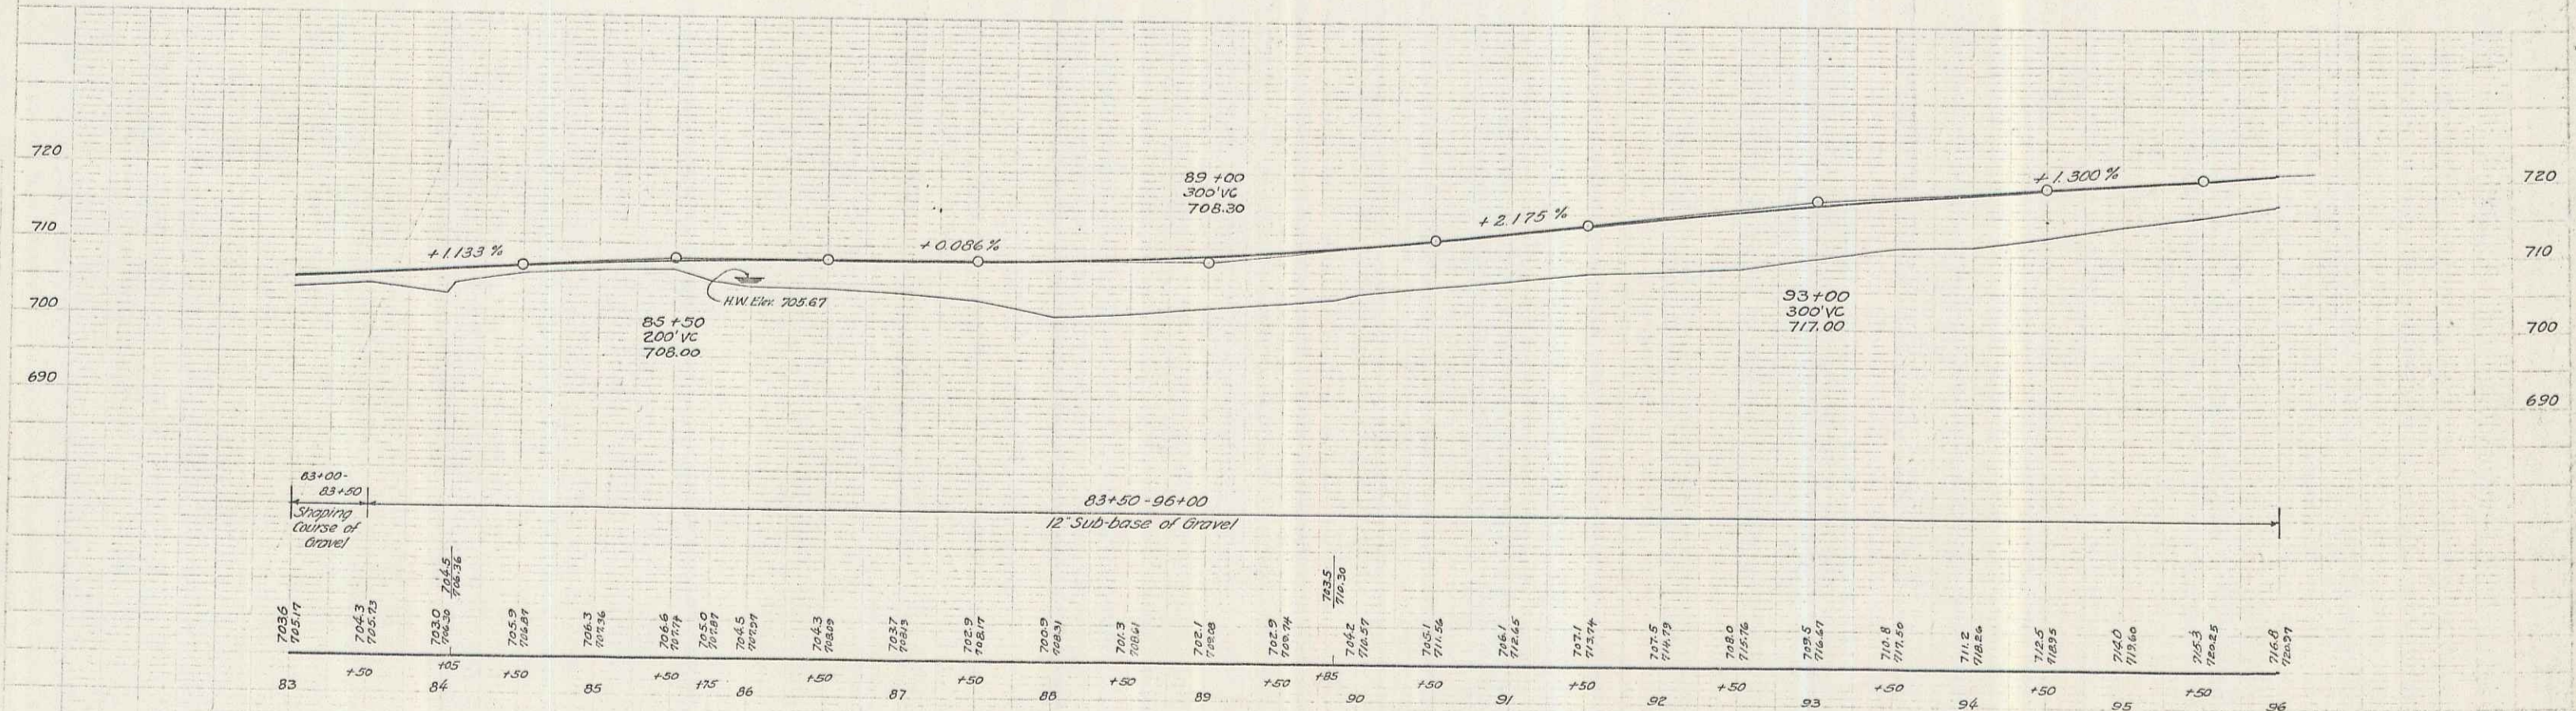


| | | | | |
|---------|-------|------------|---------------|-------|
| ED. NO. | STATE | STATE ROAD | FEDERAL SHEET | TOTAL |
| 5 | VT | 222-L | 1957 | 6 |
| | | | NO. SHEETS | 57 |

PLAN
 7-39
 GREGG
 J.E. PANMAN
 M.E. MINNERT
 M.E. MINNERT
 7-39
 Traced

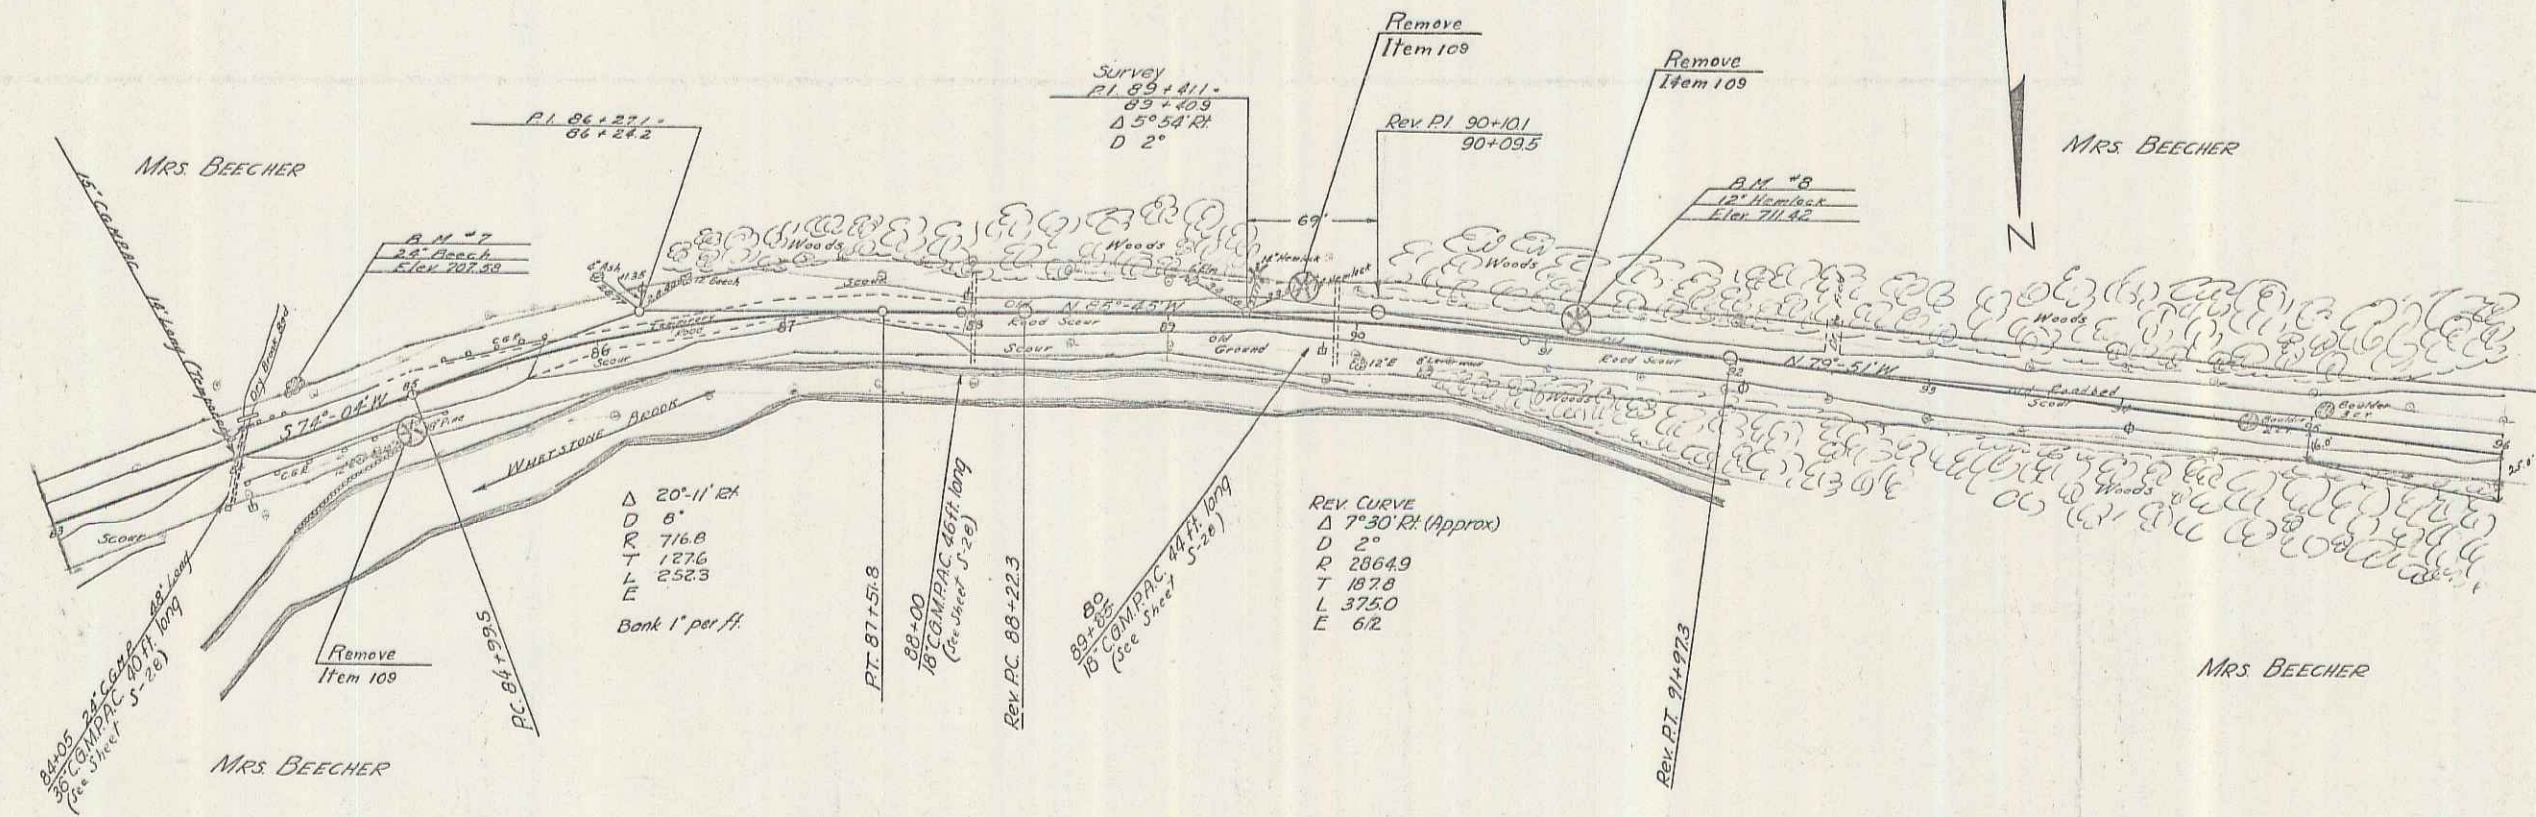

B.M. 7 Spike in Root 24" Birch 25' Lt Sta 84+41 Elev 707.58
 B.M. 8 Spike in Root 12" Hemlock 12' Lt Sta 91+14 Elev 711.42

JAMAICA S.E. 222-L
 Section 3
 Sheet 8 of 57

6