



THREE CABLE GUARD RAIL WITH STEEL POSTS  
 LT 33+00 - 33+78  
 RT 32+65 - 33+151

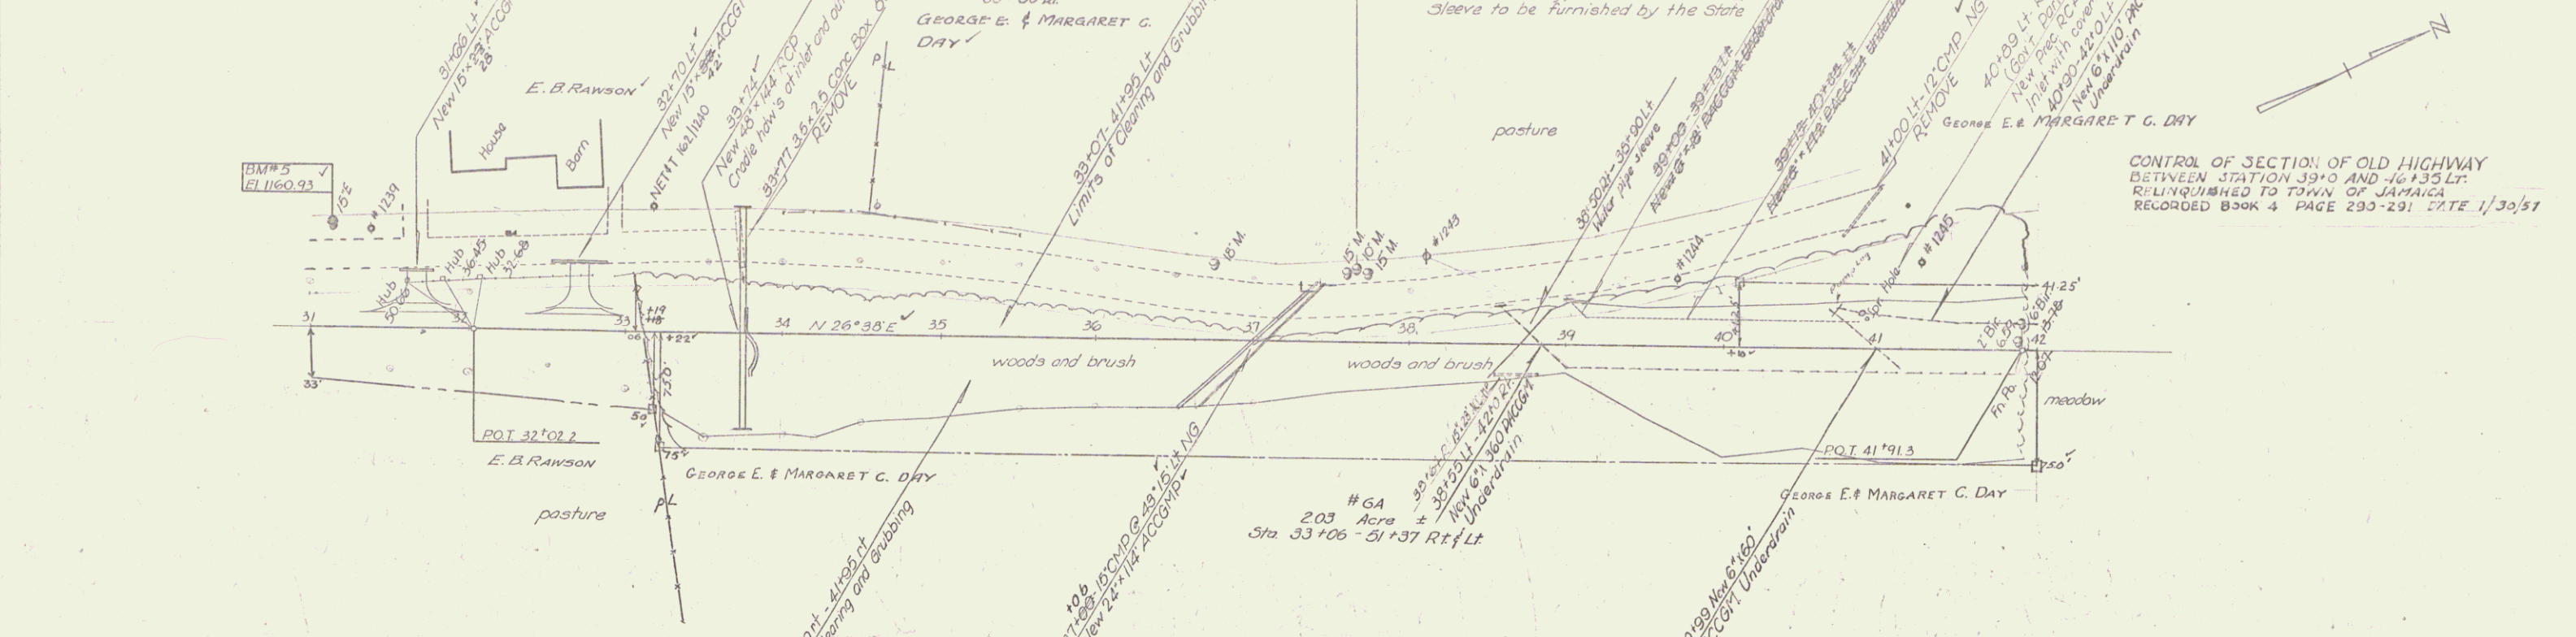

PARCEL INSTRUMENT DATE	GRANTOR	GRANTEE	RECORDED TOWN OF JAMAICA	Book	Page	Date	REMARKS
6AB W.D. 3-24-55	GEORGE E. & MARGARET G. DAY	ST. OF VT.	JAMAICA	33	522-523	11-23-55	See also Sheet 15

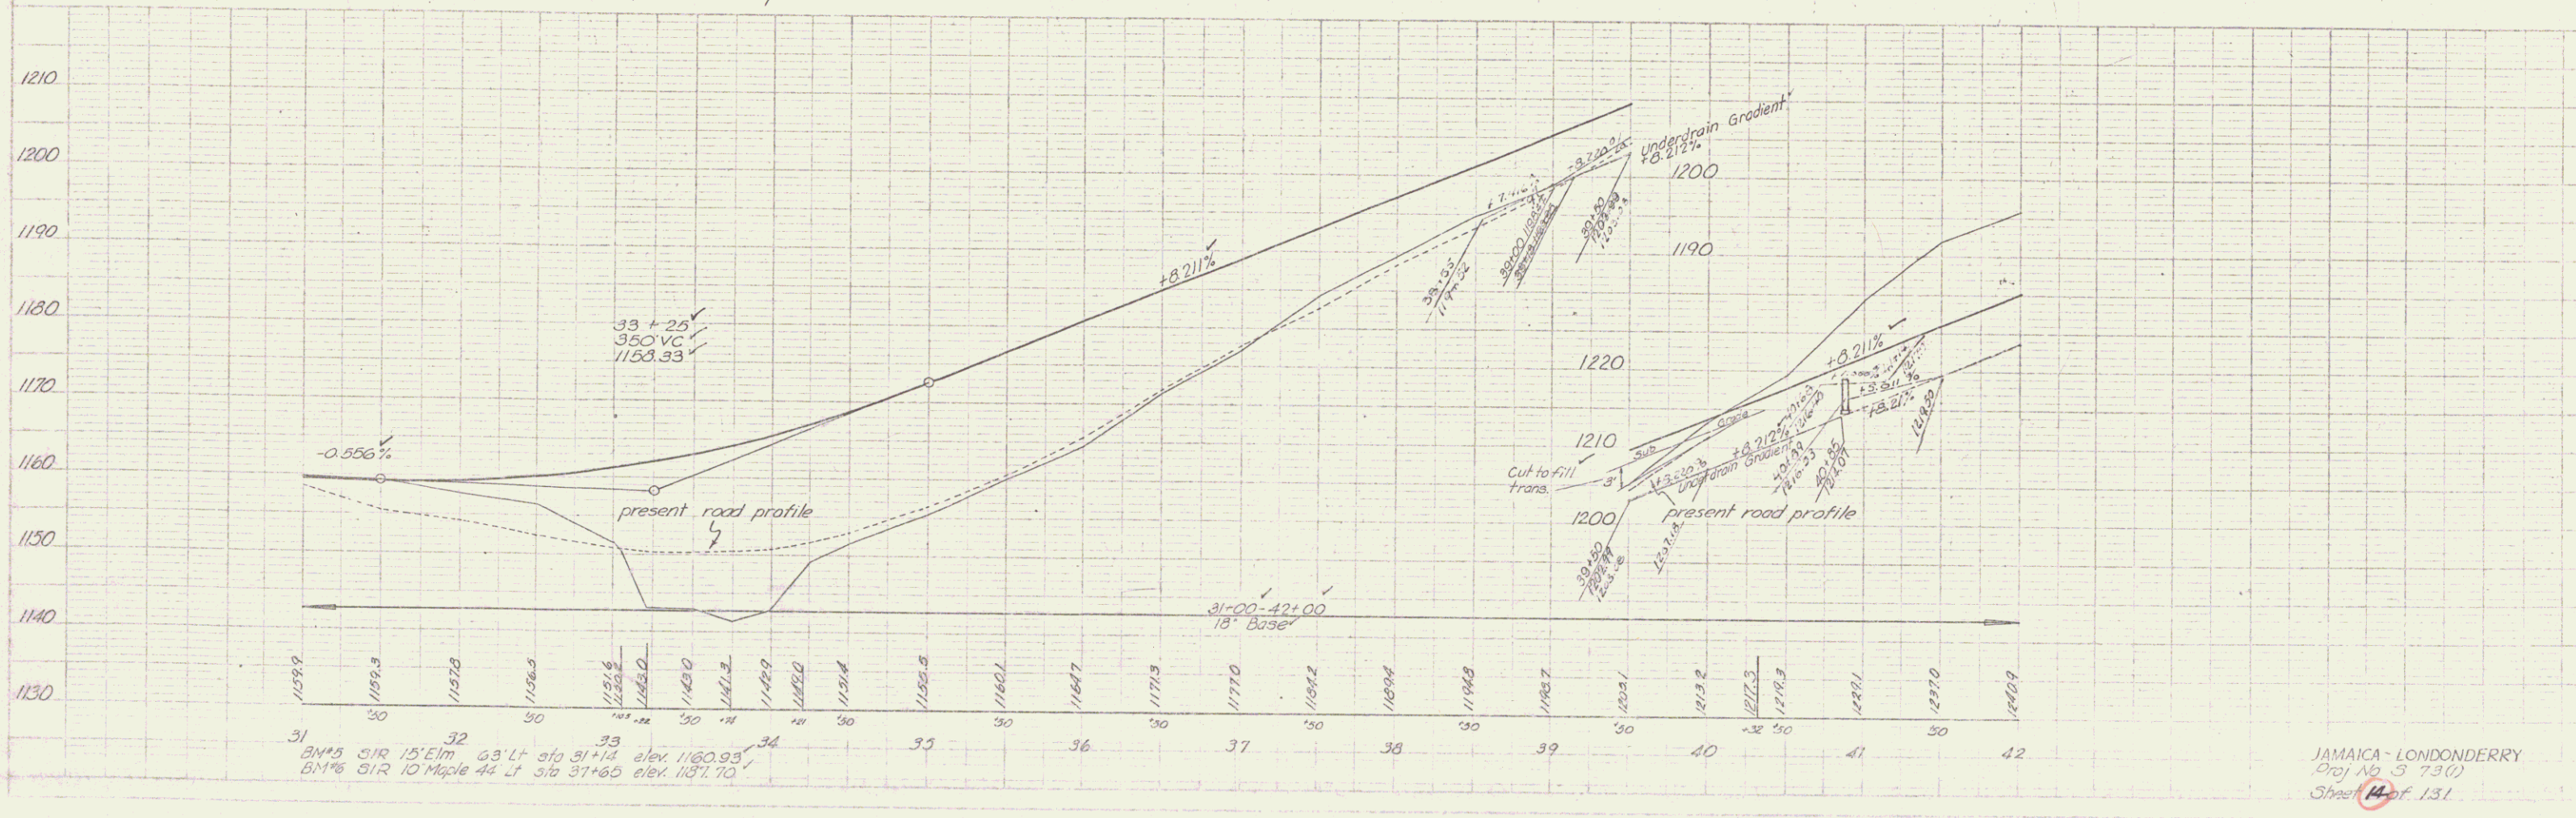

JAMAICA - LONDONDERRY  
 Proj No. 3 73(1)  
 Sheet 14 of 131