



STEEL GUIDE POSTS 16%	THREE CABLE GUARD RAIL	PLANK GUARD RAIL	CONSTRUCT DRIVES
LT	RT	LT	RT
7125-72153 RT	71125-72153 RT	71163-72124 LT	71120 74120 140
79120	78196	69170	79125
79140-79156-2	79120	78150	85100 (to proposed picnic area)
8410	79140		
84125	8110		

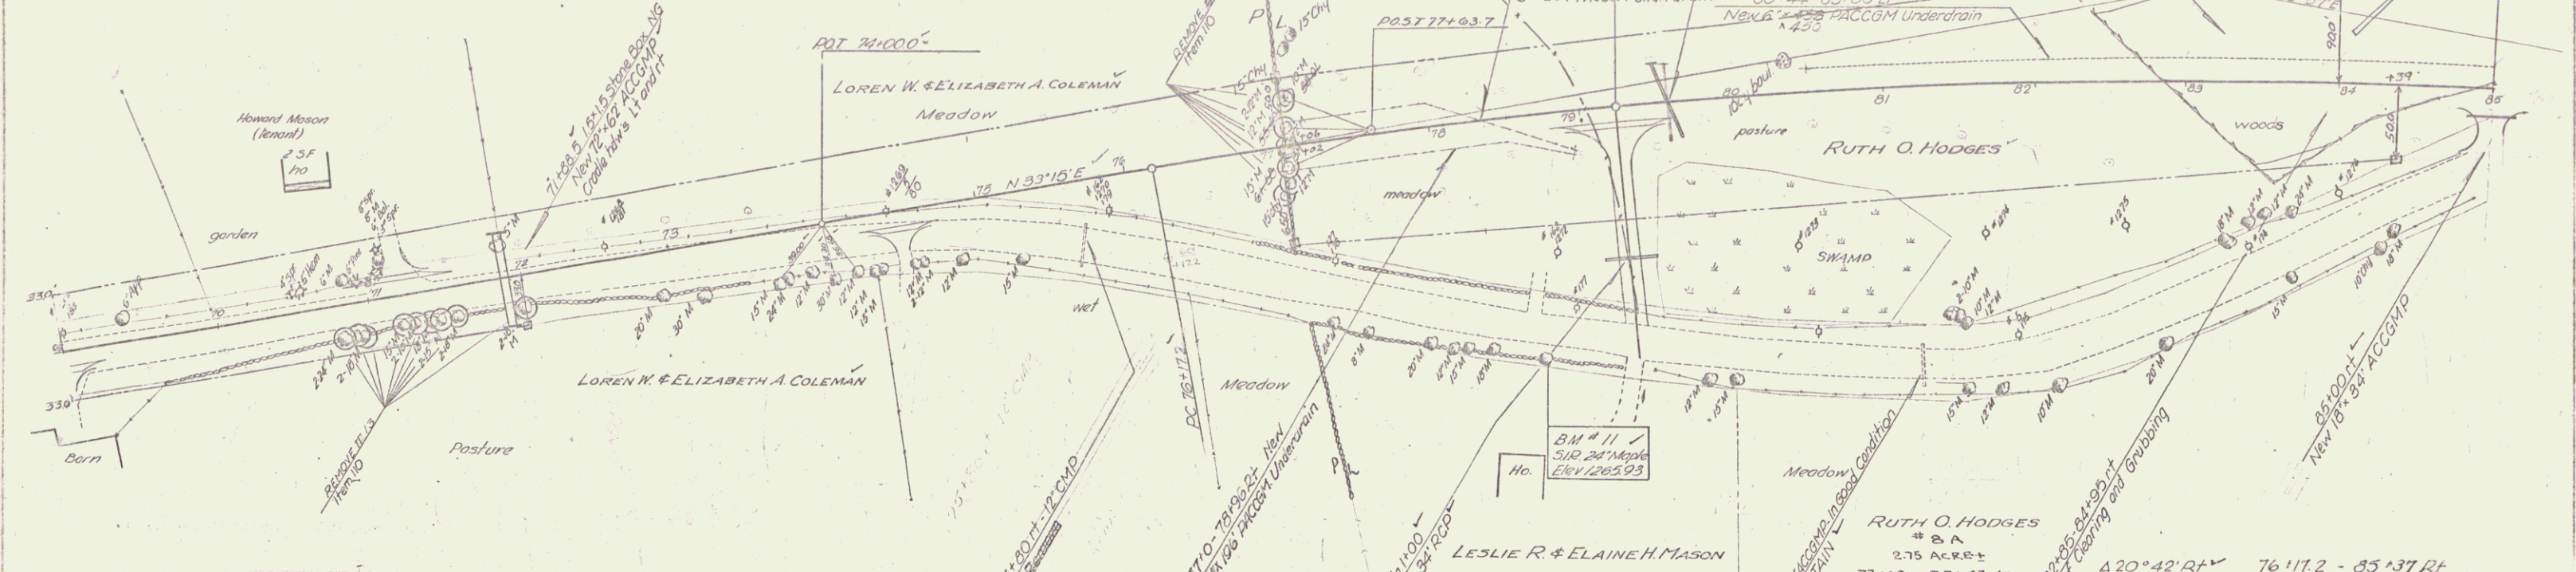

PARCEL INSTRUMENT	DATE	GRANTOR	GRANTEE	RECORDED TOWN OF LONDONDERRY	Book	Page	Date	REMARKS
84B	W.D.C.	3-24-55	RUTH O. HODGES	ST. OF VT.	27	294	11-23-55	See also sheets 18 & 19

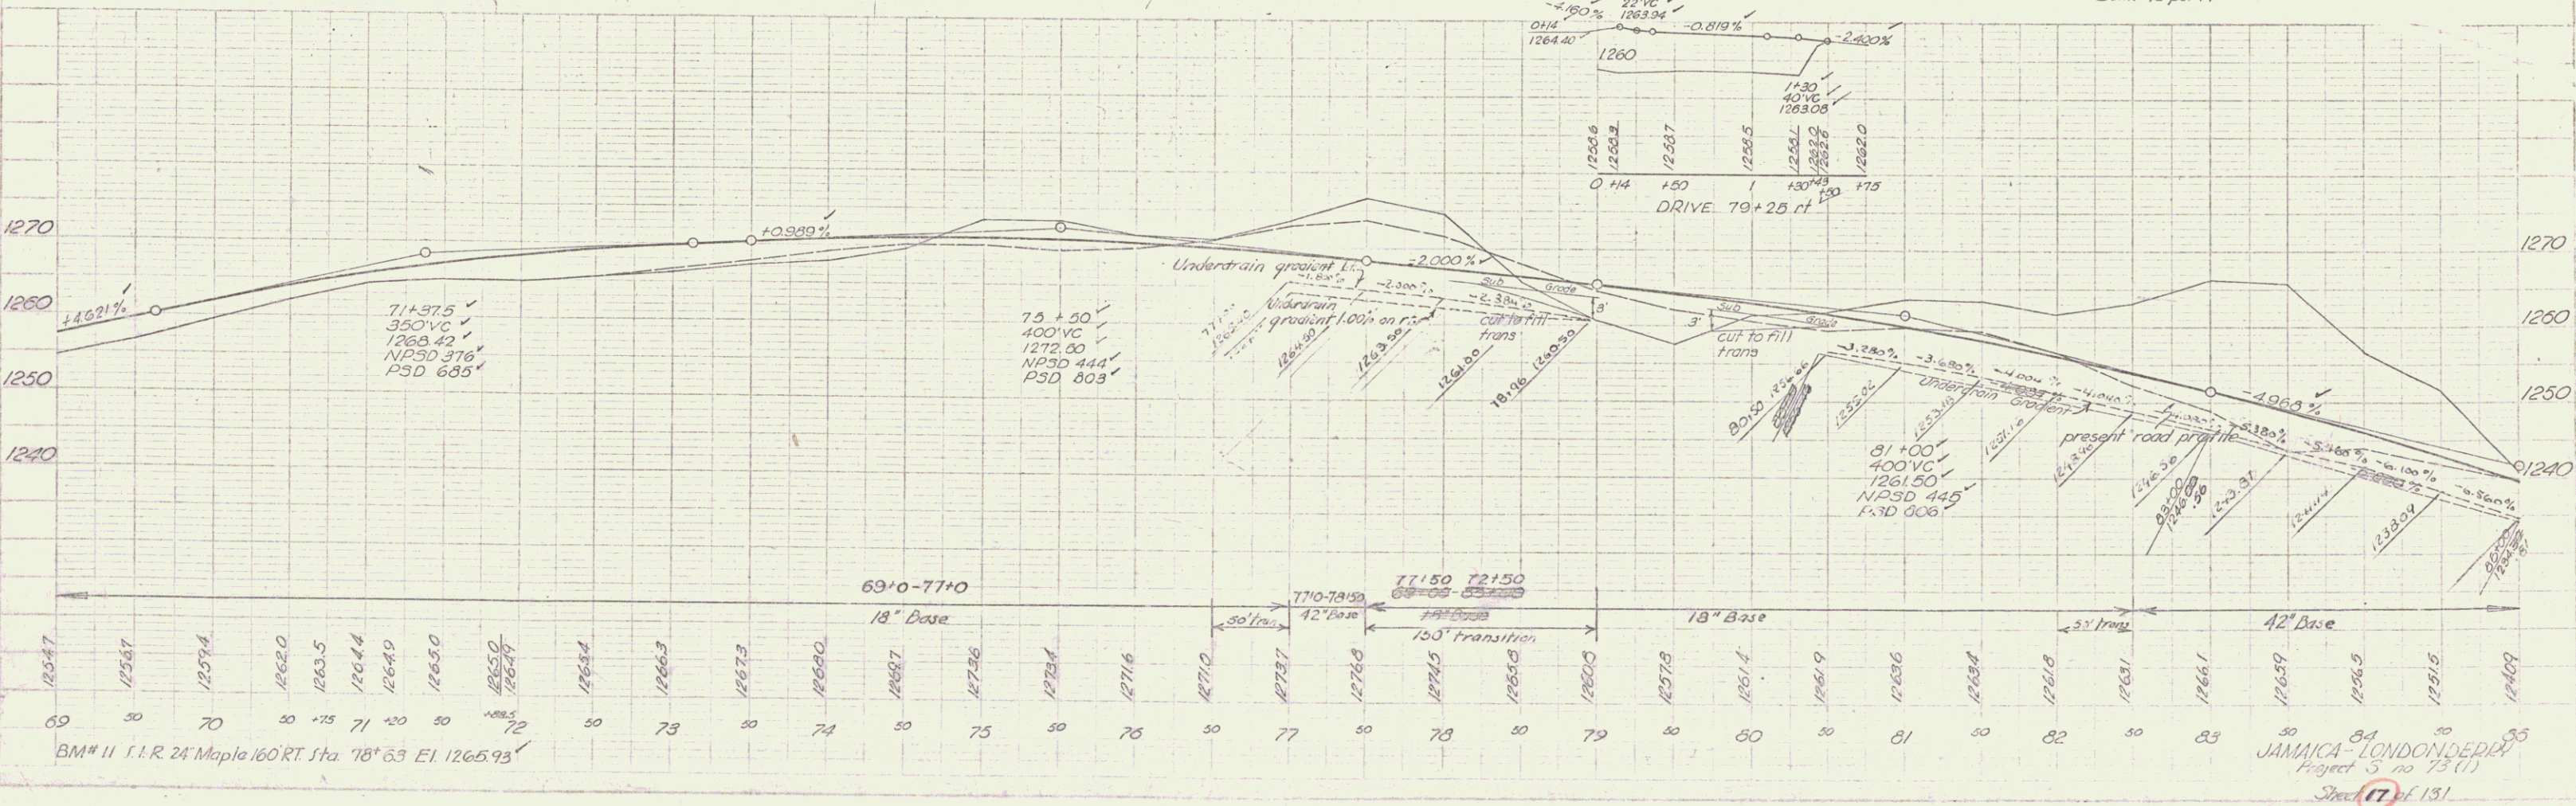

JAMAICA - LONDONDERRY  
Project 5 no 73 (1)  
Sheet 17 of 131