



STEEL GUIDE POSTS SPACED 16' c/c  
 108+25 - 111+77 RL  
 108+33 Lt.  
 110+10 Lt.

PLANK GUARD RAIL  
 108+30 Lt.  
 110+30 Lt.

109+01 - 114+0 LI  
 CONTROL OF OLD HIGHWAY BETWEEN THESE STATIONS  
 RELINQUISHED TO TOWN - Recorded Book 27 Page 366  
 of Land Records of town of Londonderry

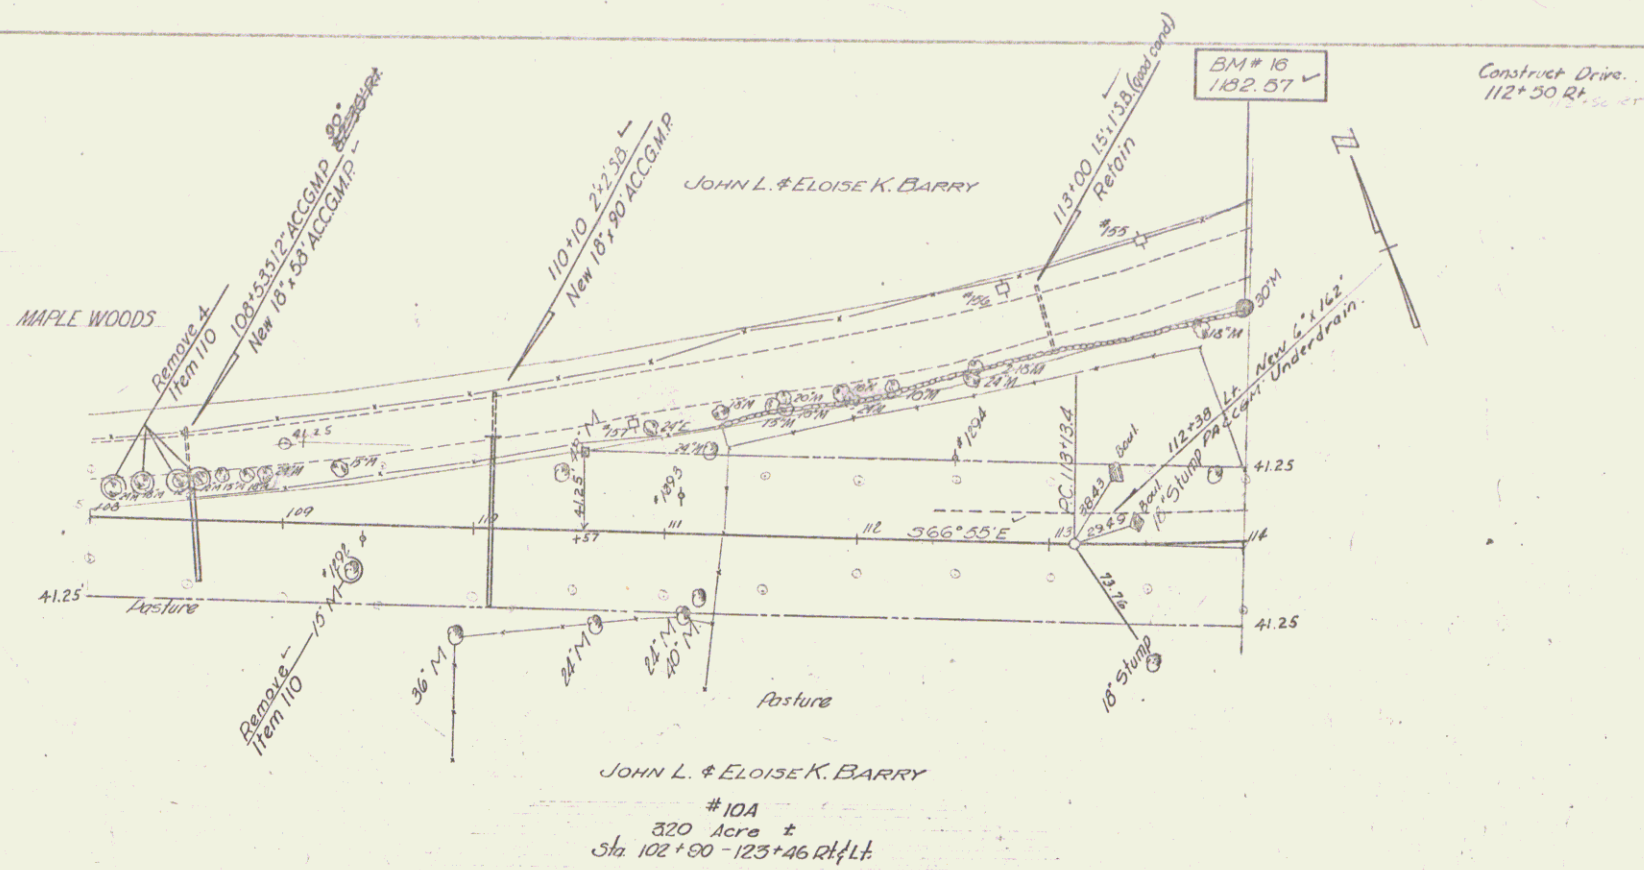

PARCEL	INSTR	DATE	GRANTOR	GRANTEE	RECORDED BOOK	PAGE	DATE	REMARKS
10A,B	COND.	12-3-54	JOHN L. & ELOISE K. BARRY	ST OF VT	LONDONDERRY 27	236-238	12-1-54	

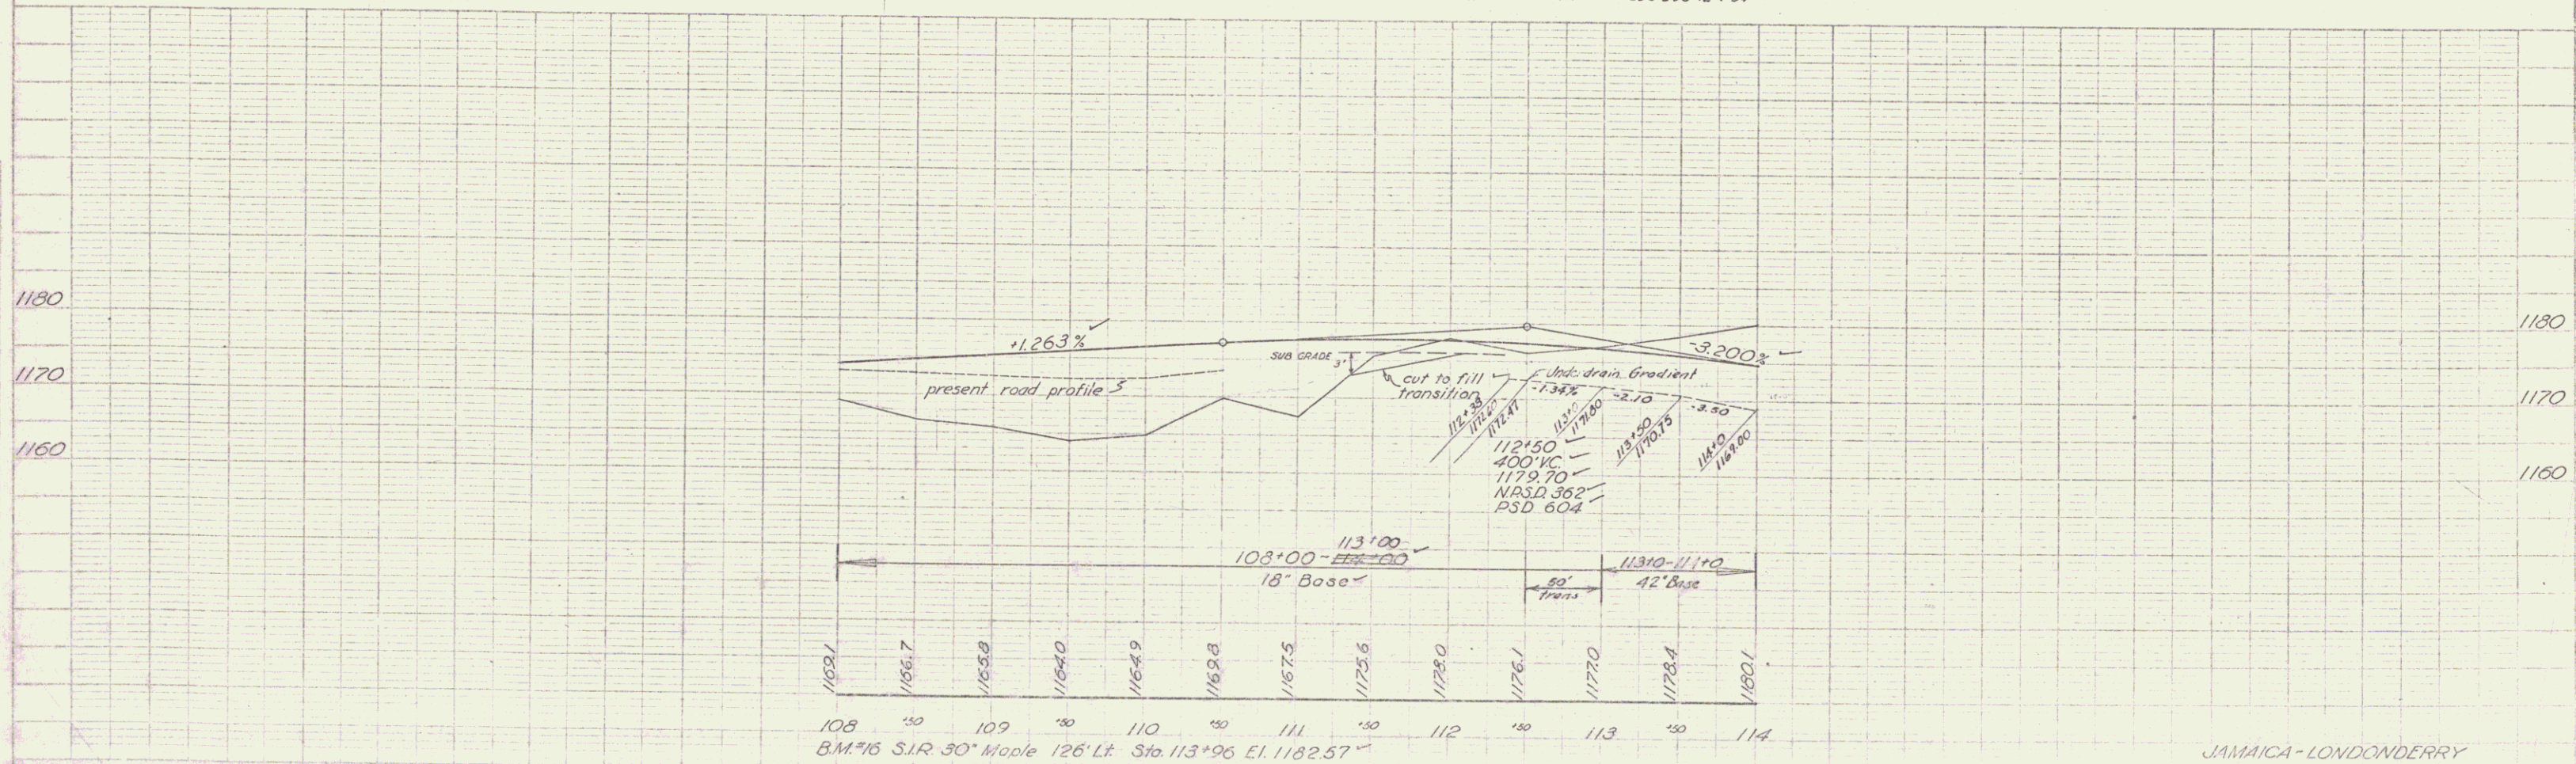

JAMAICA - LONDONDERRY  
 Proj. S. No. 73(1)  
 Sheet 20 of 131