

As shown on plan of Present & Proposed
 1.175-1.177
 1.175-1.177 RT
 1.175-1.177 RT
 1.175-1.177 RT



#1-A-1 WILLIAM R. & JOYCE P. FLANDERS
 (A 0.008) STA 41+08-41+332
 W.D. 11/25/57
 RECORDED-HYDE PARK-BK 35-PG 209/210-11/30/57

CONSTRUCT DRIVES	
40+00	0.7 RT
41+00	0.6 RT
41+00	2.2 LT
42+60	EF

#1-B WILLIAM R. & JOYCE P. FLANDERS
 (A 0.233) STA 41+33-47+211
 W.D. 11/25/57
 RECORDED-HYDE PARK-BK 35-PG 209/210-11/30/57

#1-A-3 WILLIAM R. & JOYCE P. FLANDERS
 (A 0.001) STA 47+08-52+60E
 W.D. 11/25/57
 RECORDED-HYDE PARK-BK 35-PG 209/210-11/30/57

#1-A-2 WILLIAM R. & JOYCE P. FLANDERS
 (A 0.402) STA 40+64-48+36.12
 W.D. 11/25/57
 RECORDED-HYDE PARK-BK 35-PG 209/210-11/30/57

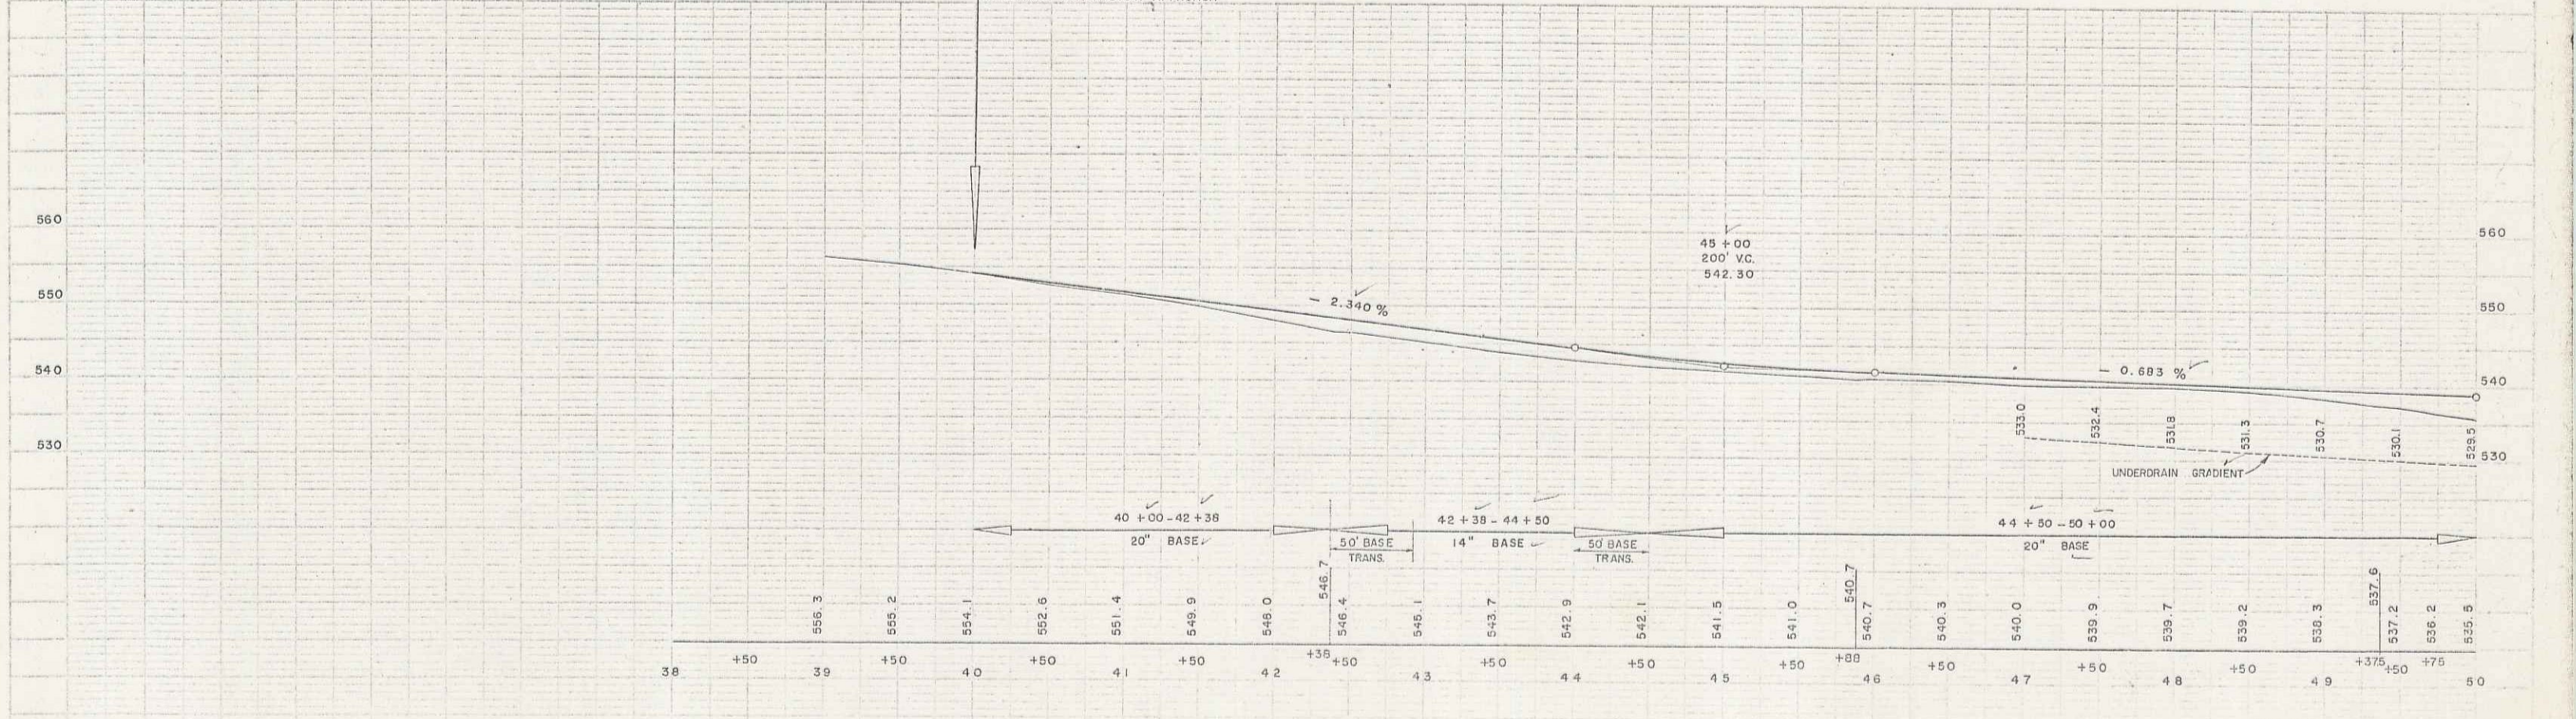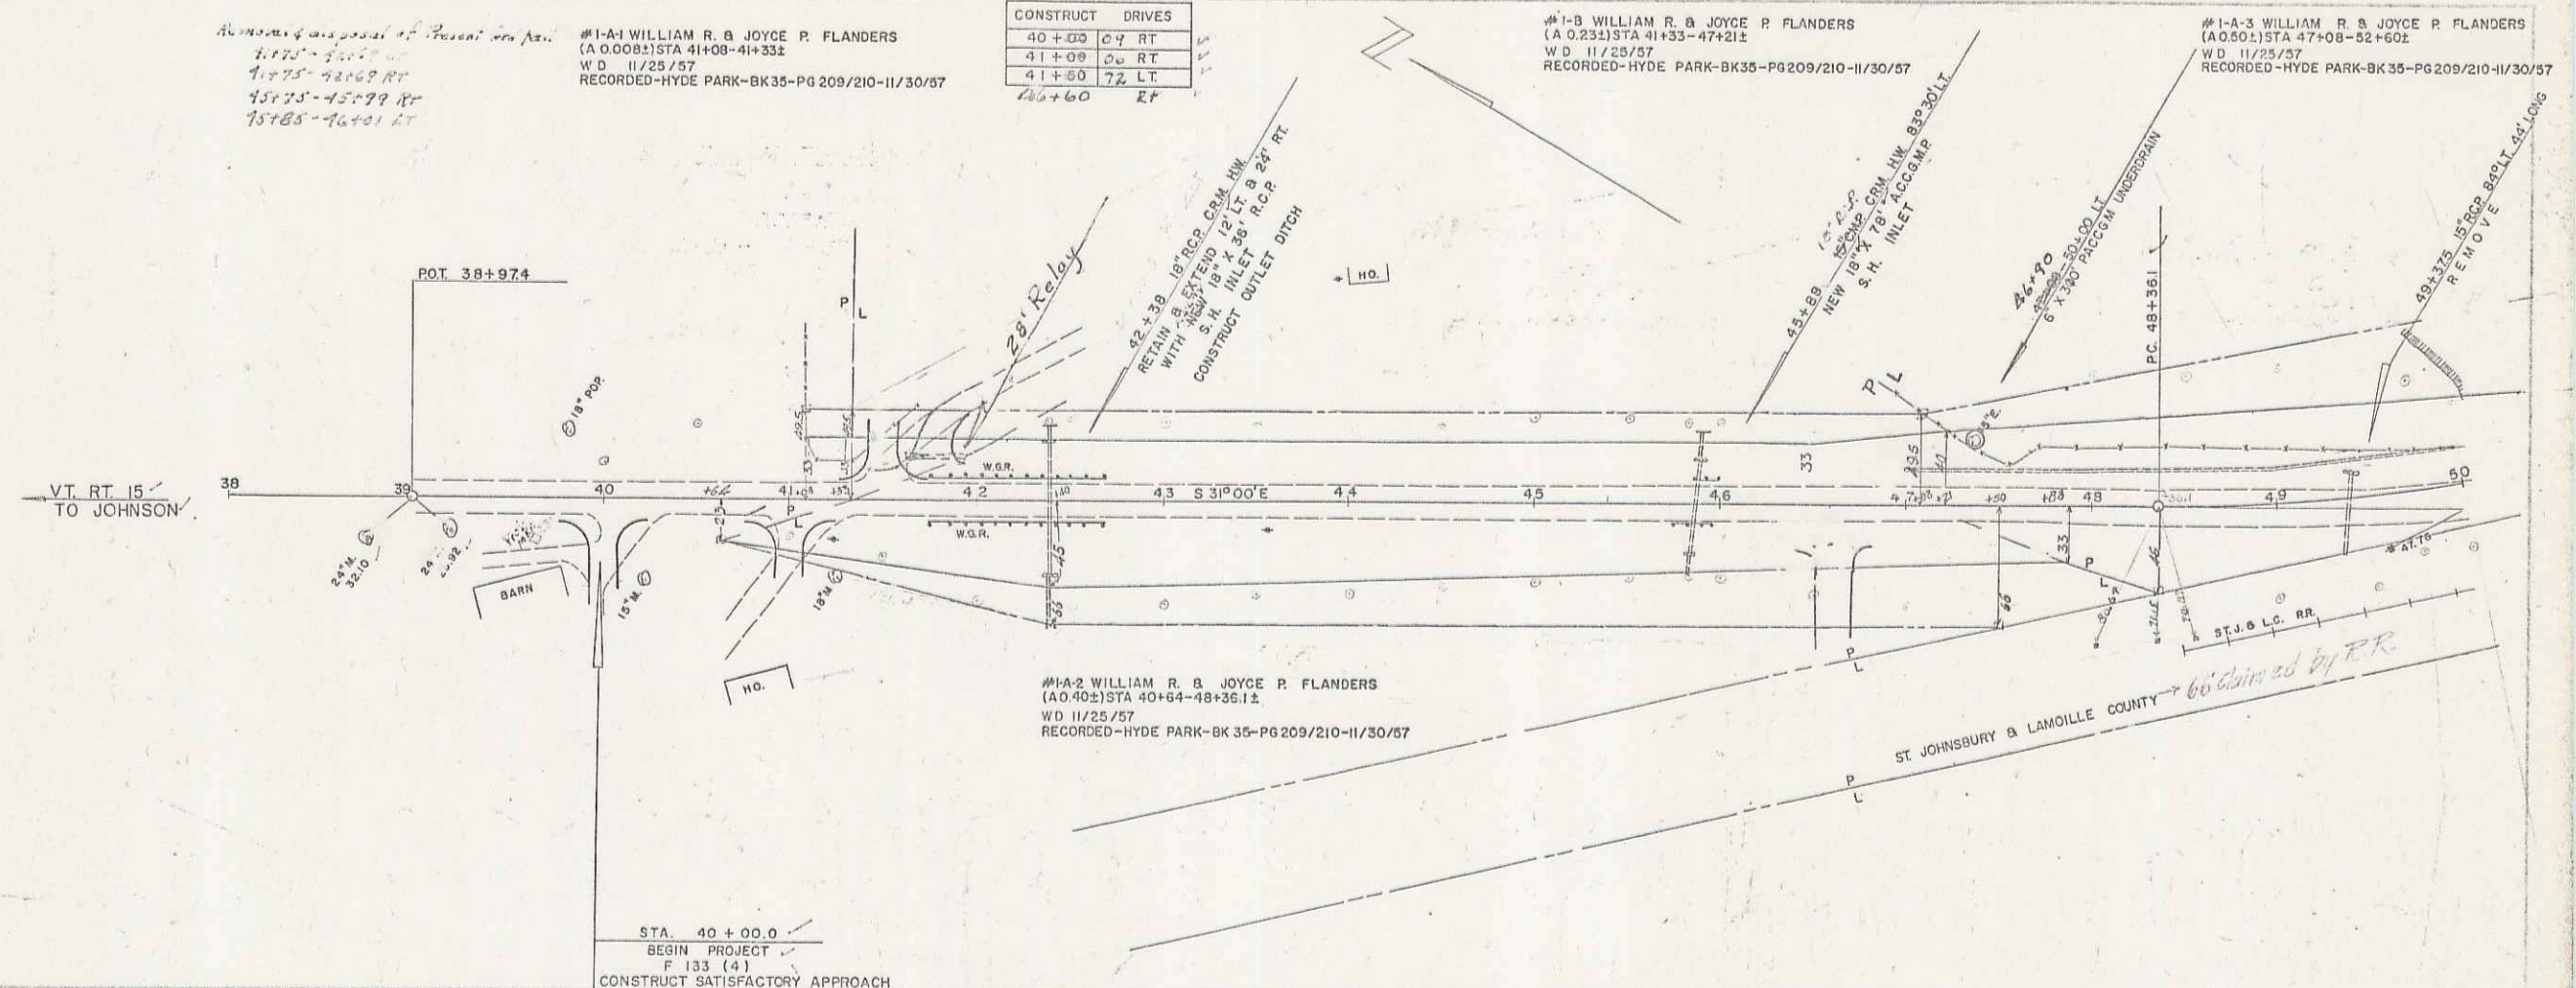

SPILLING
 WESTER-MARTIN, INC.
 5-55
 5-55

SPILLING
 WESTER-MARTIN, INC.
 5-55
 5-55