


CONSTRUCT DRIVES	
58+10	LT.
58+15	RT.
64+09	LT.
54+50	LT.
59+00	RT.
58+42	RT.
54+42	LT.
55+73	RT.
60+34	LT.
7+17	RT.

CONSTRUCT APPROACH LT.	
63+00	

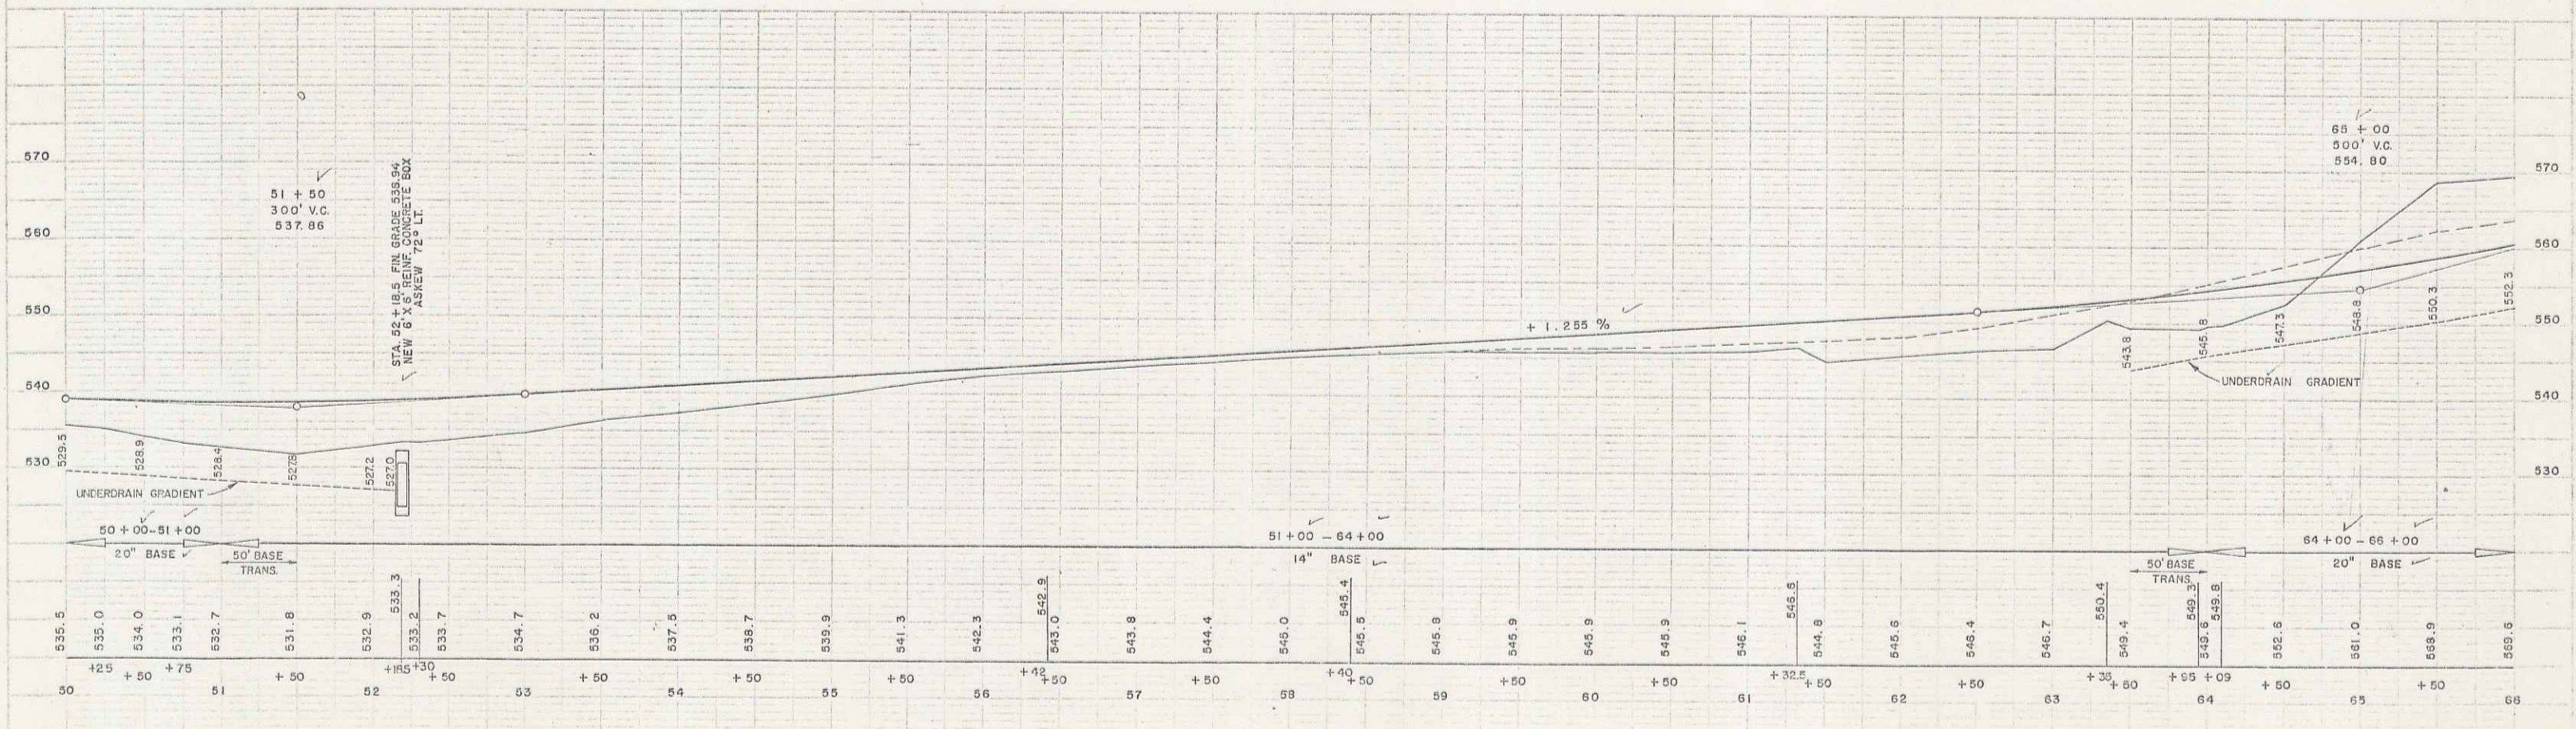

B.M. 1 = 25' RT. 52+10 SPOT ON TOP OF S. WALL CULVERT - ELEV. 535.29 B.M. 1-A 50' RT. SPOT ON TOP OF CONC. RT. CULVERT ELEV. 535.29

HYDE PARK F133(4)
SHEET 12 OF 133
B.M. 2 73' RT. 65+00 S.L.R. 48" ELM. ELEV. 559.30

3