


TURNING MOVEMENT DIAGRAM
SHOWING 1975 DIV.

FOR INTERSECTION AT STA. 110+33.0

CONSTRUCT	APPROACH	POS.	CONSTRUCT	DRIVES	POS.	CONSTRUCT	APPROACH	LINE
STA		LT. & RT.	STA		LT. & RT.	STA		CONSTRUCT DRIVES
110+33		LT. & RT.	109+35		LT. & RT.	2+50		LT
			107+00		LT	7+77		RT
			107+30		RT	9+25		LT
			108+25		RT	3+78		RT
			107+26		LT			
			105+20		RT			

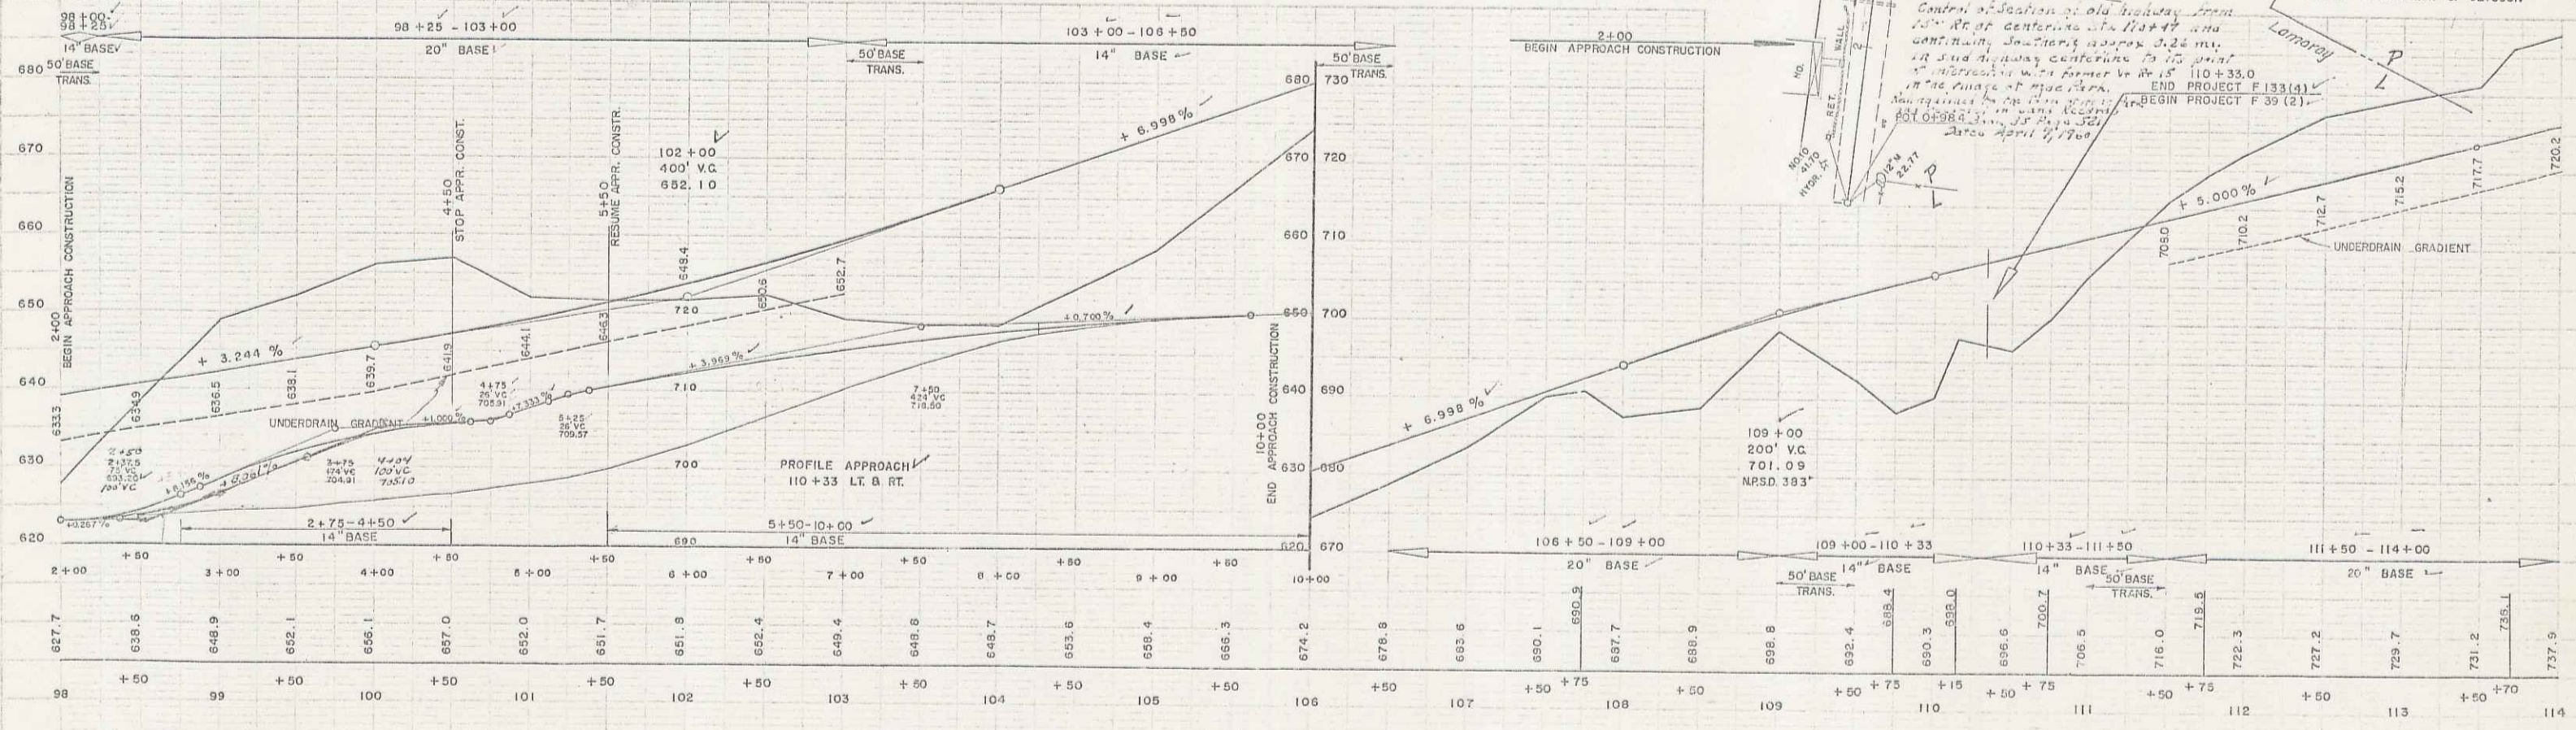

B.M. 5 189' LT. 105+48 S.I.R. 24" ELM. ELEV. 644.39

B.M. 6 82' RT. 100+99 S.I.R. 50" MAPLE. ELEV. 686.90

HYDE PARK F 133 (1)
HYDE PARK-MORRISTOWN F 39(2)
SHEET 15 OF 133
B.M. 7 210' LT. 112+35 SPOT ON LEVEL. ELEV. 738.70